
DUNHAM SURVEYING, S. C.

SURVEYING & SUBDIVIDING

DELAVAN, WISCONSIN 53115

RECEIVED
MAR 5

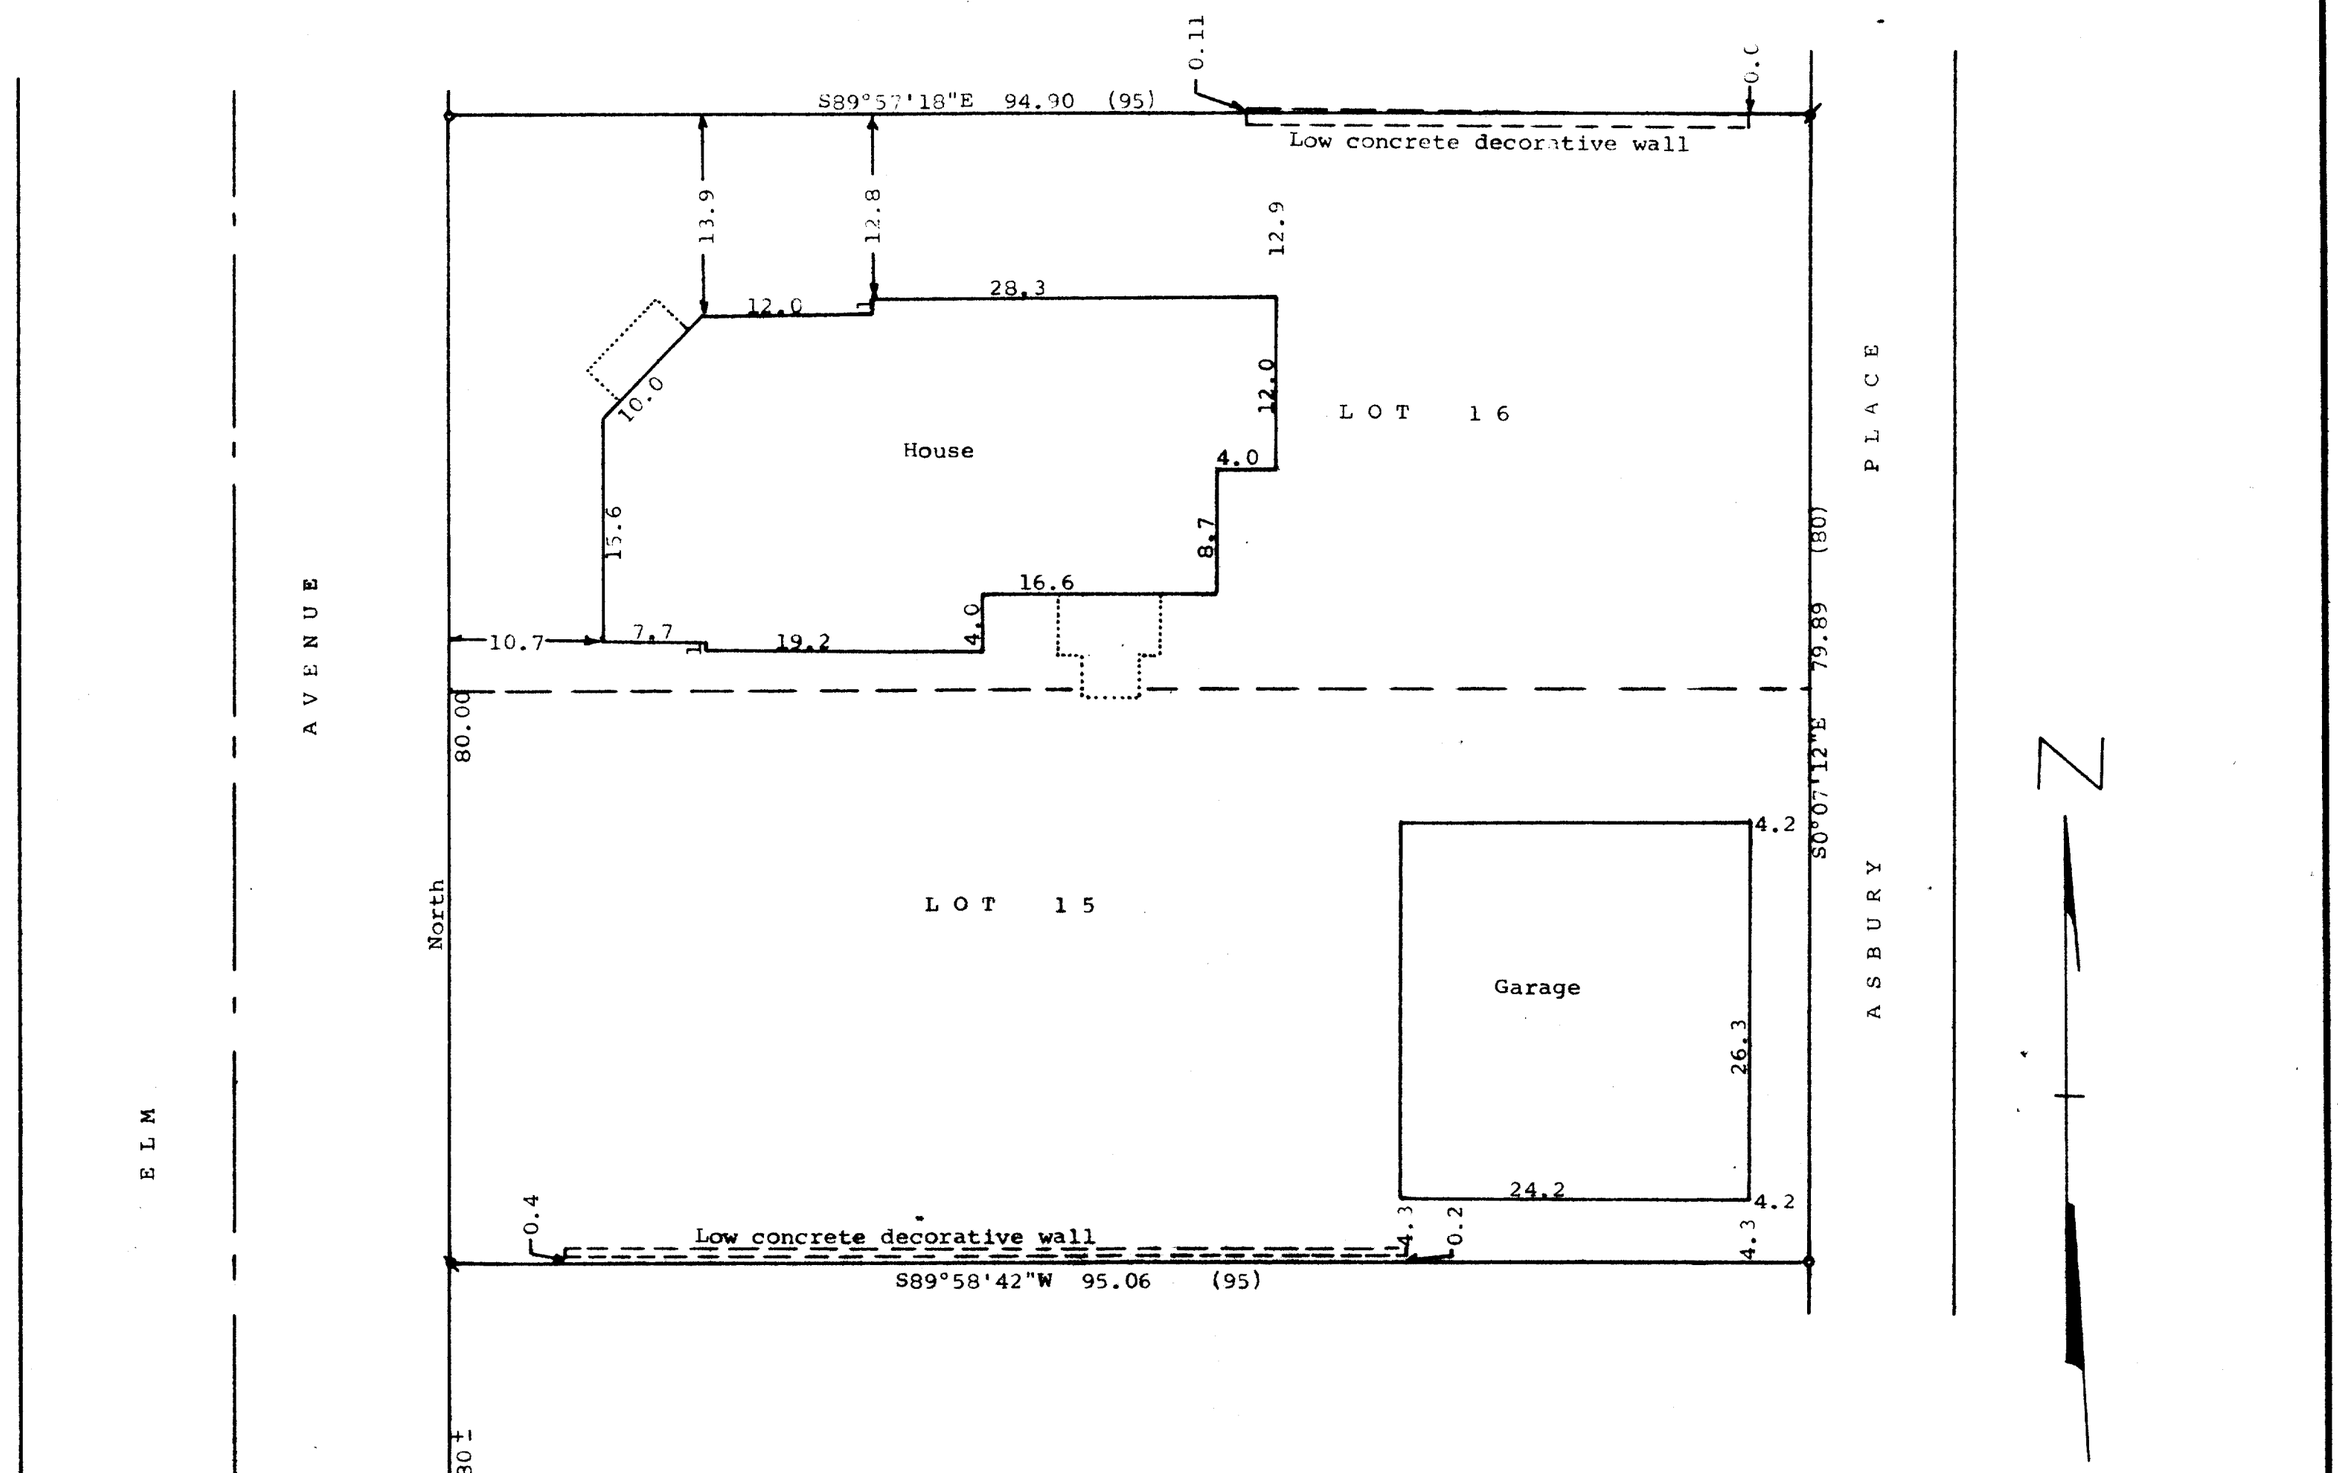

STATE OF WISCONSIN)
COUNTY OF WALWORTH) SS

I, George T. Dunham, Surveyor, certify that I have surveyed the property described as follows:

Lots 15 and 16 in Block 16, Glenwood Springs, a subdivision located in the Village of Fontana, Walworth County, Wisconsin,

and that the map shown hereon is a correct representation thereof and shows the size and location of the property, its exterior boundaries, the location of all visible structures and dimensions of all principal buildings thereon, boundary fences, apparent easements, roadways and visible encroachments, if any, and that I have surveyed the property hereon described, according to the official records, to the best of my knowledge and belief.

December 23, 1986

George T. Dunham, Surveyor

WISCONSIN
GEORGE T. DUNHAM
S-306
DELAVAN WIS.
LAND SURVEYOR

S65-126

5-69Y

GME 1029