
# DUNHAM SURVEYING, S.C.

*SURVEYING & SUBDIVIDING*

DELAVAN, WISCONSIN 53115


RECEIVED
MAR 5

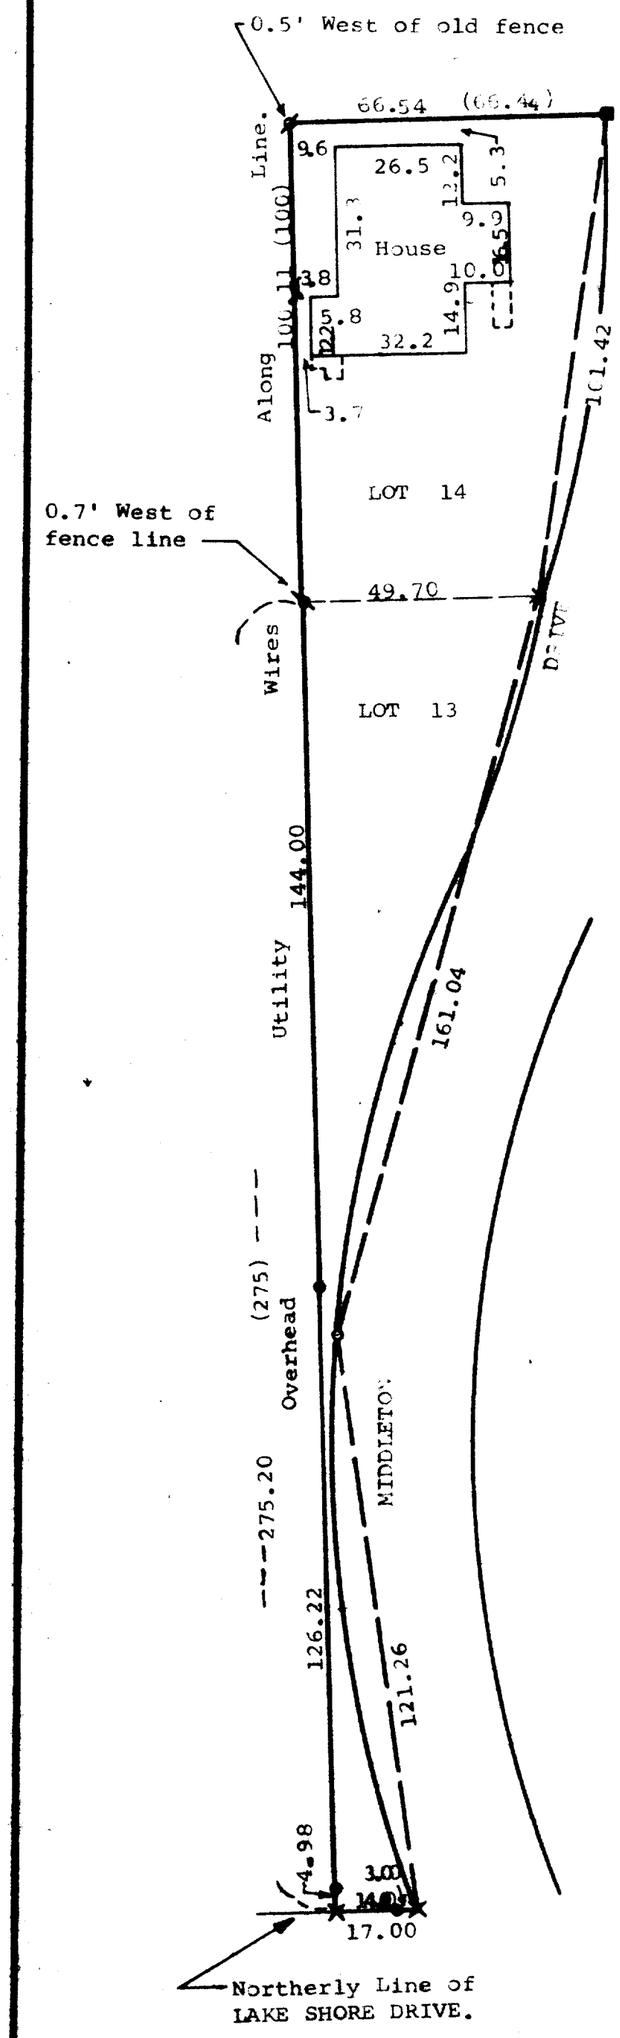


Scale - 1" = 30'

- = 3/4" Dia. Iron Pipe Found
- = 1" Dia. Iron Pipe Found
- = 3/4"x24" Iron Pipe Set
- = 1"x24" Iron Pipe Set
- X = Cross Cut in Concrete
- = Found ½" Dia. Iron Rod
- = Square Concrete Monument Found

(0.00) = recorded distance

Survey Ordered By: David Williams
Attorney At Law
Delavan, Wisconsin
53115

STATE OF WISCONSIN)
COUNTY OF WALWORTH) SS

I, George T. Dunham, Surveyor, certify that I have surveyed the property described as follows,

Lots 13 and 14 in Club Unique, a subdivision located in the Southeast ¼ of Fractional Section 14, T1N, R16E, Village of Fontana, Walworth County, Wisconsin,

and that the map shown above is a correct representation thereof and shows the size and location of the property, its exterior boundaries, the location of all visible structures and dimensions of all principal buildings thereon, boundary fences, apparent easements, roadways and visible encroachments, if any, and that I have surveyed the property hereon described according to the official records, to the best of my knowledge and belief.

November 11, 1986.

George T. Dunham, Surveyor

WISCONSIN
GEORGE T. DUNHAM
S-306
DELAVAN WIS.
LAND SURVEYOR

SCB-13, 14

5-698