#170-61

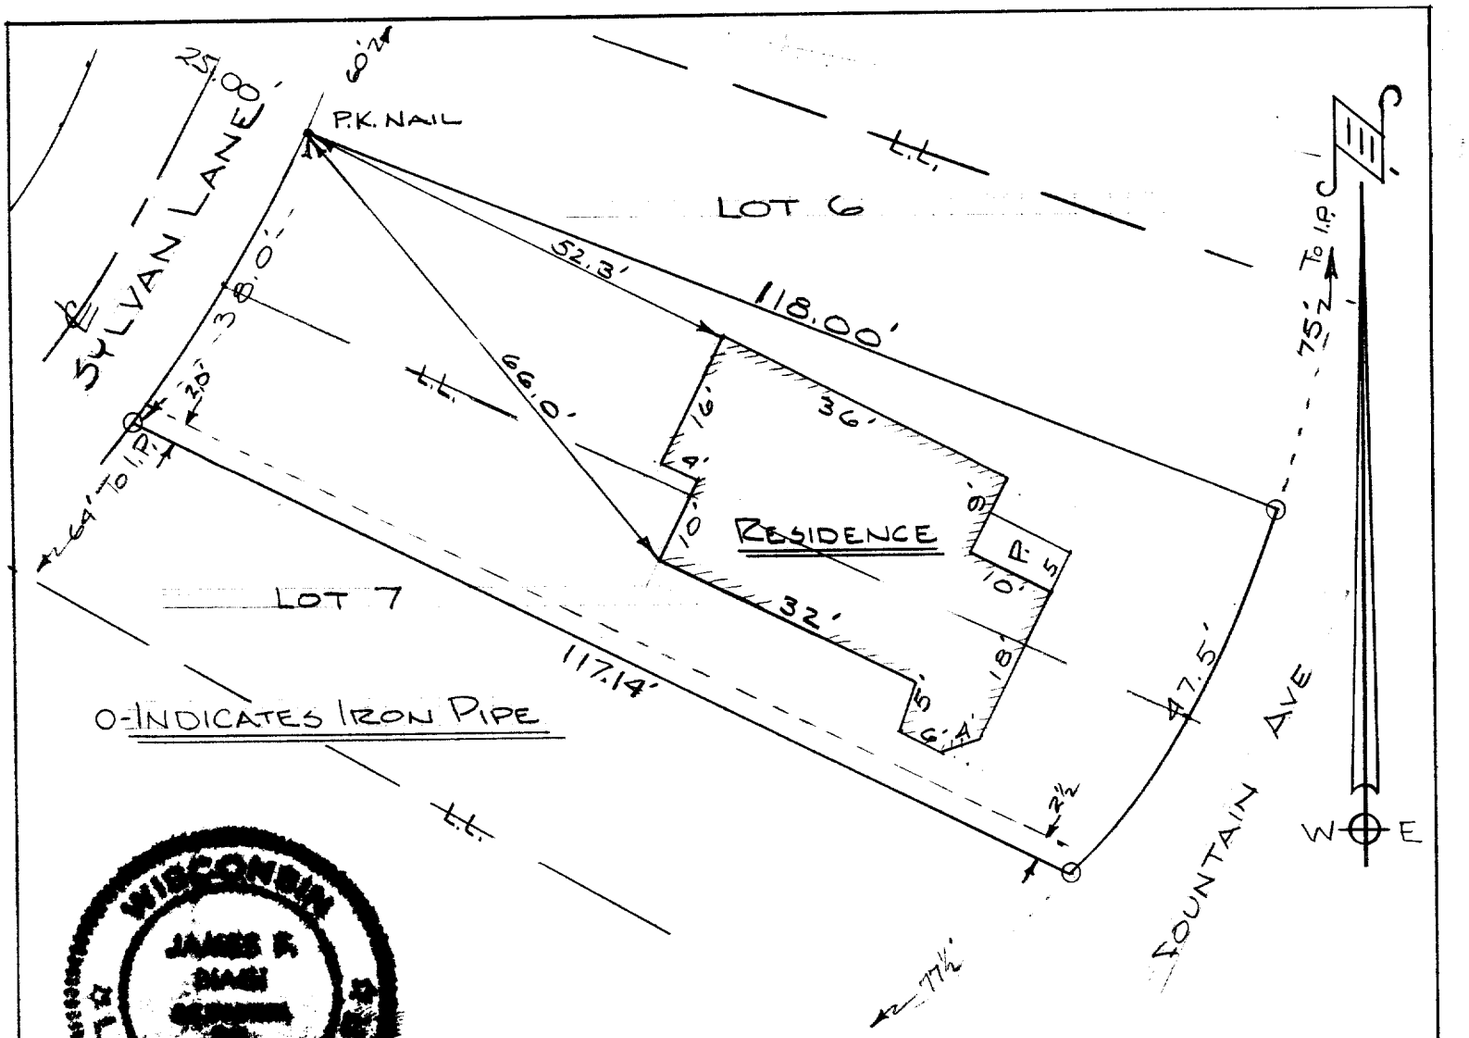

WISCONSIN JAMES F. BIAGI LAND SURVEYOR

DESCRIPTION: The South ½ of Lot 6 and the North 20/50ths. of Lot 7, also a strip off of the North side of the South 30/50ths. of 7 that is 2.00 ft. wide on Sylvan Lane and 2.50 feet wide on Fountain Avenue all in Buena Vista Subdivision located in Sections 11 and 14 in the Village of Fontana, Walworth County, Wisconsin.

CERTIFICATE: I, James F. Biagi, surveyor, do hereby certify that I have surveyed the property hereon described.

October 2, 1969.

James F. Biagi

James F. Biagi, R.L.S. 272

SBV-5

5-6B