
ABELL
SURVEYING & MAPPING
DELAVAN, WISCONSIN 53115
414-728-6737

RECEIVED
APR 2 1 1987

GENEVA LAKE

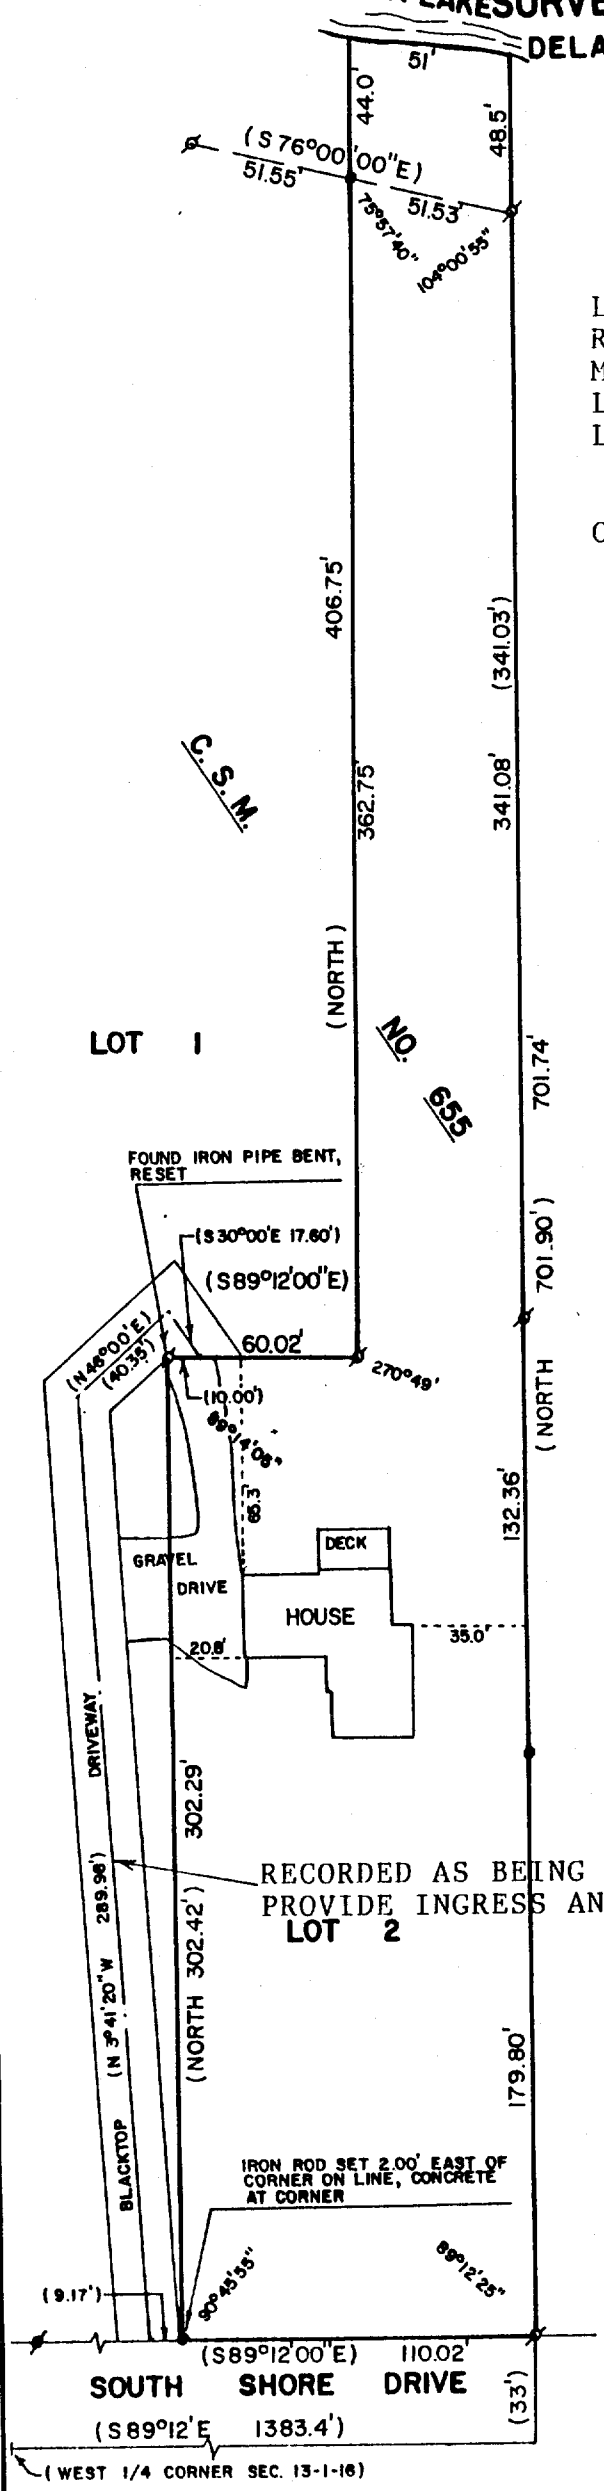

SA655-2

PLAT OF SURVEY OF

LOT 2 OF CERTIFIED SURVEY MAP NO. 655 AS RECORDED IN VOLUME 3 OF CERTIFIED SURVEY MAPS ON PAGE 140 AS DOCUMENT NUMBER 15118, LOCATED IN THE VILLAGE OF FONTANA-ON- GENEVA LAKE, WALWORTH COUNTY, WISCONSIN.

ORDERED BY: MRS. JOAN HUERTH
24227 N. FOREST DR.
'AKE ZURRICK, IL 60047

SCALE - 1"=60'

LEGEND
ø - IRON PIPE FOUND
ø - CONCRETE MONUMENT FOUND
( )- RECORDED AS
• - IRON ROD SET

RECORDED AS BEING THE CENTERLINE OF A 20 FOOT WIDE EASEMENT TO PROVIDE INGRESS AND EGRESS TO LOT 2

I, DAVID F. ABELL, DO HEREBY CERTIFY THAT I HAVE SURVEYED THE PROPERTY HEREON DESCRIBED ACCORDING TO THE OFFICIAL RECORDS AND THAT THE PLAT HEREON IS A CORRECT REPRESENTATION OF THE PROPERTY LINES TO THE BEST OF MY KNOWLEDGE AND BELIEF.

David F. Abell
DAVID F. ABELL
WISCONSIN REGISTERED LAND SURVEYOR, S-1596

April 2, 1987
DATE JOB NUMBER - 87029

NOTE: THIS IS NOT A CERTIFIED COPY UNLESS SEALED.

5-703