
WALWORTH COUNTY
SURVEYING & MAPPING
LAKE GENEVA, WISCONSIN

RECEIVED
JUN 19 1987

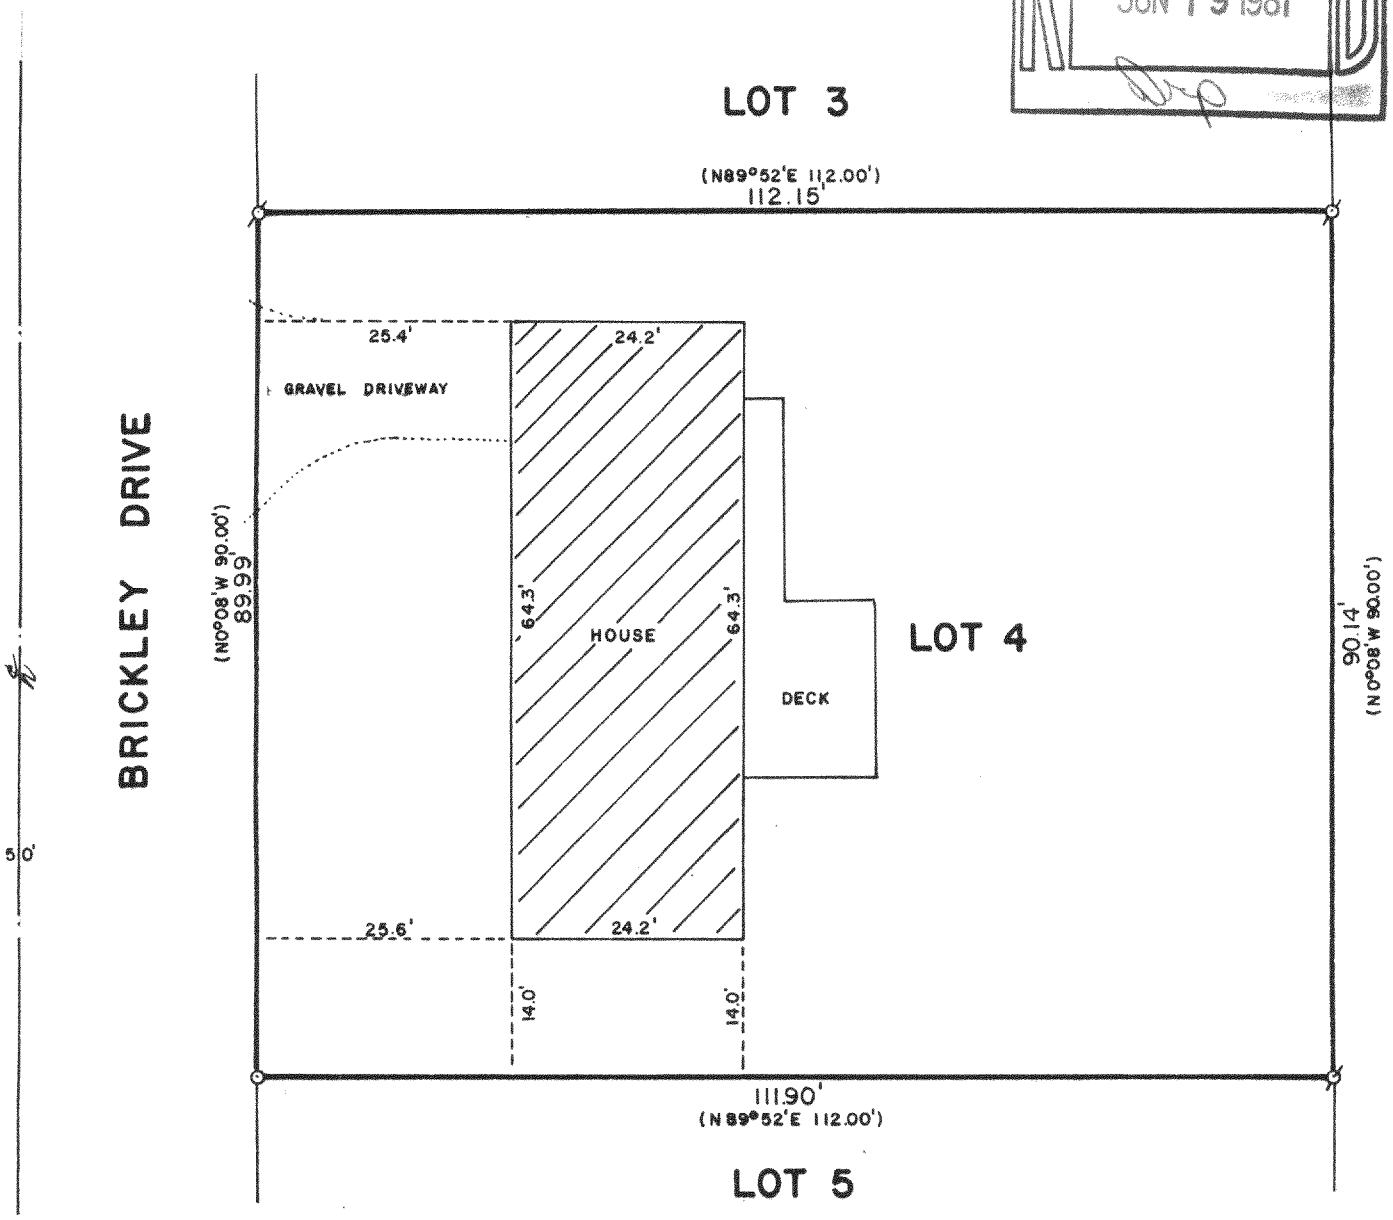


PLAT OF SURVEY OF

LOT 4 OF BRICKLEY SUBDIVISION, LOCATED IN THE VILLAGE OF FONTANA-ON-GENEVA LAKE, WALWORTH COUNTY, WISCONSIN.

ORDERED BY: RICHARD CAIN
P. O. BOX 351
FONTANA, WISCONSIN

SCALE: 1"=20'

ø -IRON PIPE FOUND
o -IRON ROD PLACED
( )-RECORDED AS

I, ROBERT M. BAERENWALD, DO HEREBY CERTIFY THAT I HAVE SURVEYED THE PROPERTY HEREON DESCRIBED ACCORDING TO THE OFFICIAL RECORDS AND THAT THE PLAT HEREON IS A CORRECT REPRESENTATION OF THE PROPERTY LINES TO THE BEST OF MY KNOWLEDGE AND BELIEF.

Robert M. Baerenwald
ROBERT M. BAERENWALD
WISCONSIN REGISTERED LAND SURVEYOR, S-1508

April 24, 1987
DATE JOB NO. 1016

NOTE: THIS IS NOT A CERTIFIED COPY UNLESS SEALED.

SBR-4

S-720