
WALWORTH COUNTY
SURVEYING & MAPPING
LAKE GENEVA, WISCONSIN

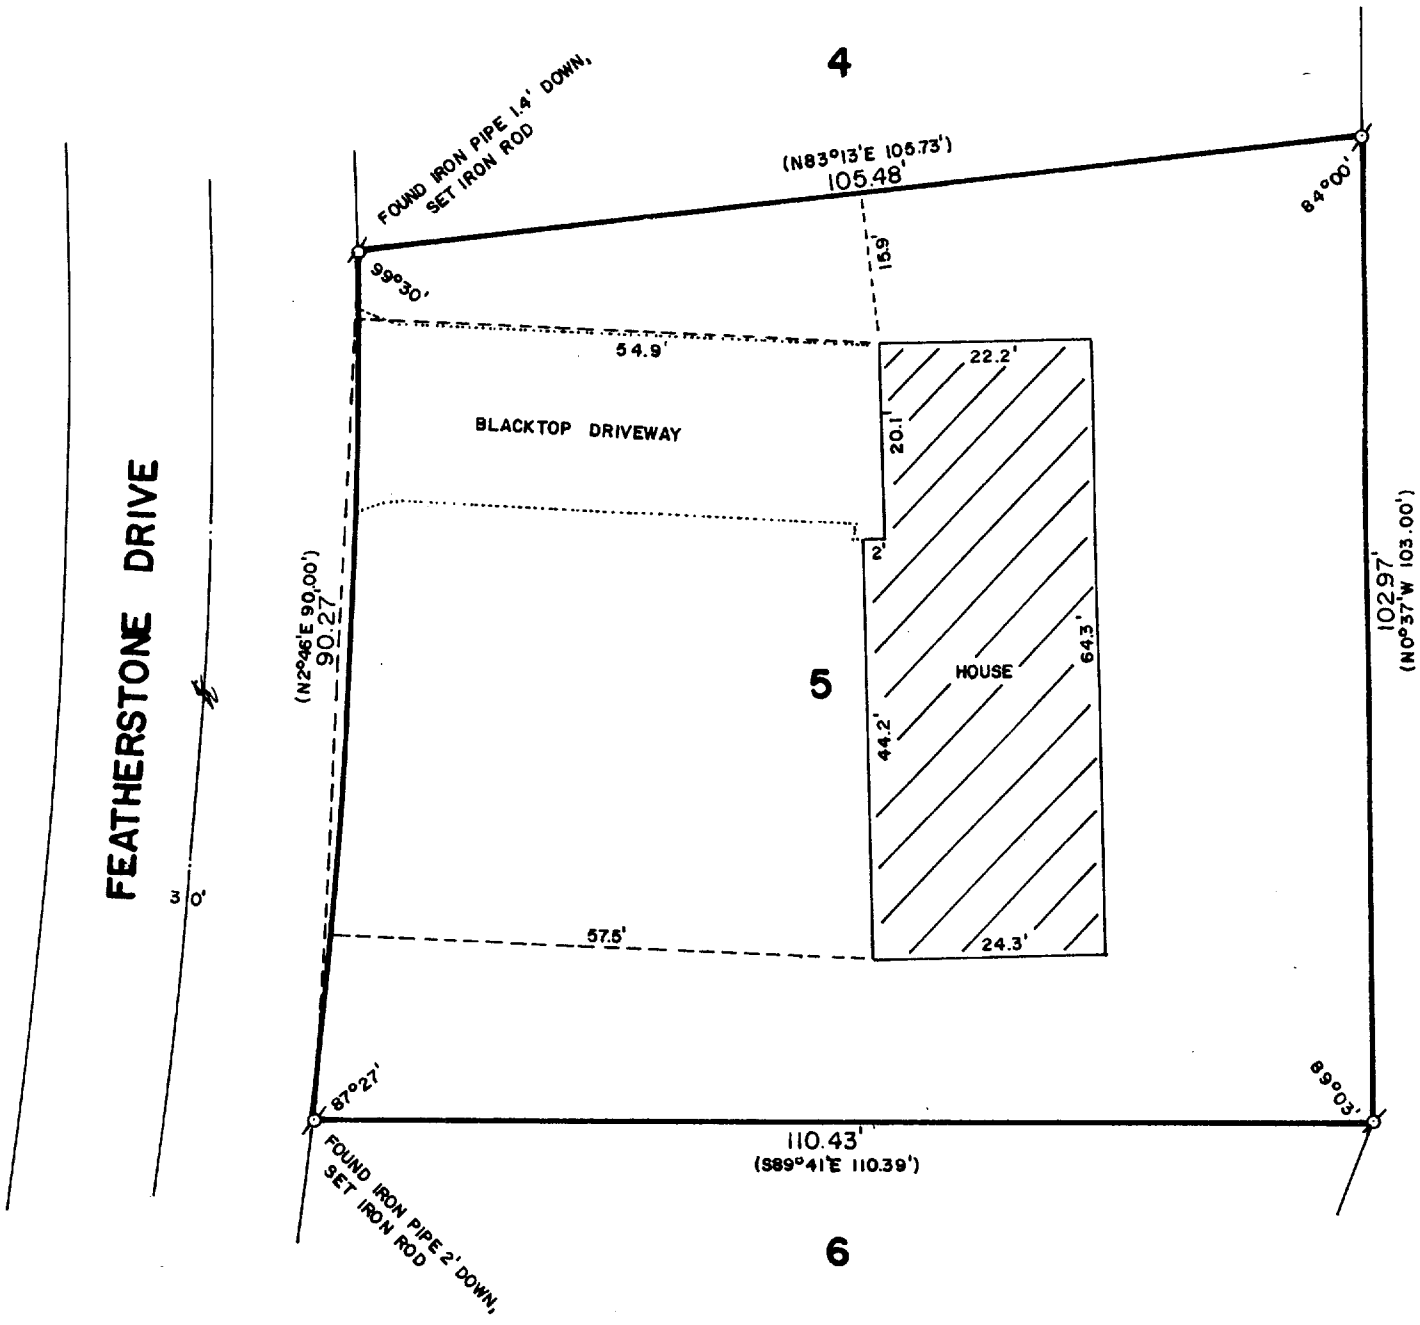

PLAT OF SURVEY OF

LOT 5 OF COUNTRY CLUB ESTATES ADD. "A", LOCATED IN THE VILLAGE OF FONTANA-ON-GENEVA LAKE, WALWORTH COUNTY, WISCONSIN.

RECEIVED

ORDERED BY: RICHARD CAIN
3RD AVENUE
FONTANA, WISCONSIN

N

SCALE: 1"=20'

ø-IRON PIPE FOUND
()-RECORDED AS

I, ROBERT M. BAERENWALD, DO HEREBY CERTIFY THAT I HAVE SURVEYED THE PROPERTY HEREON DESCRIBED ACCORDING TO THE OFFICIAL RECORDS AND THAT THE PLAT HEREON IS A CORRECT REPRESENTATION OF THE PROPERTY LINES TO THE BEST OF MY KNOWLEDGE AND BELIEF.

Robert M. Baerenwald
ROBERT M. BAERENWALD
WISCONSIN REGISTERED LAND SURVEYOR, S-1508

Sept. 16, 1987
DATE JOB NO. 1253

NOTE: THIS IS NOT A CERTIFIED COPY UNLESS SEALED.

SCTA-5

5-761