


DUNHAM SURVEYING, S.C.
SURVEYING & SUBDIVIDING
DELAVER, WISCONSIN 53115

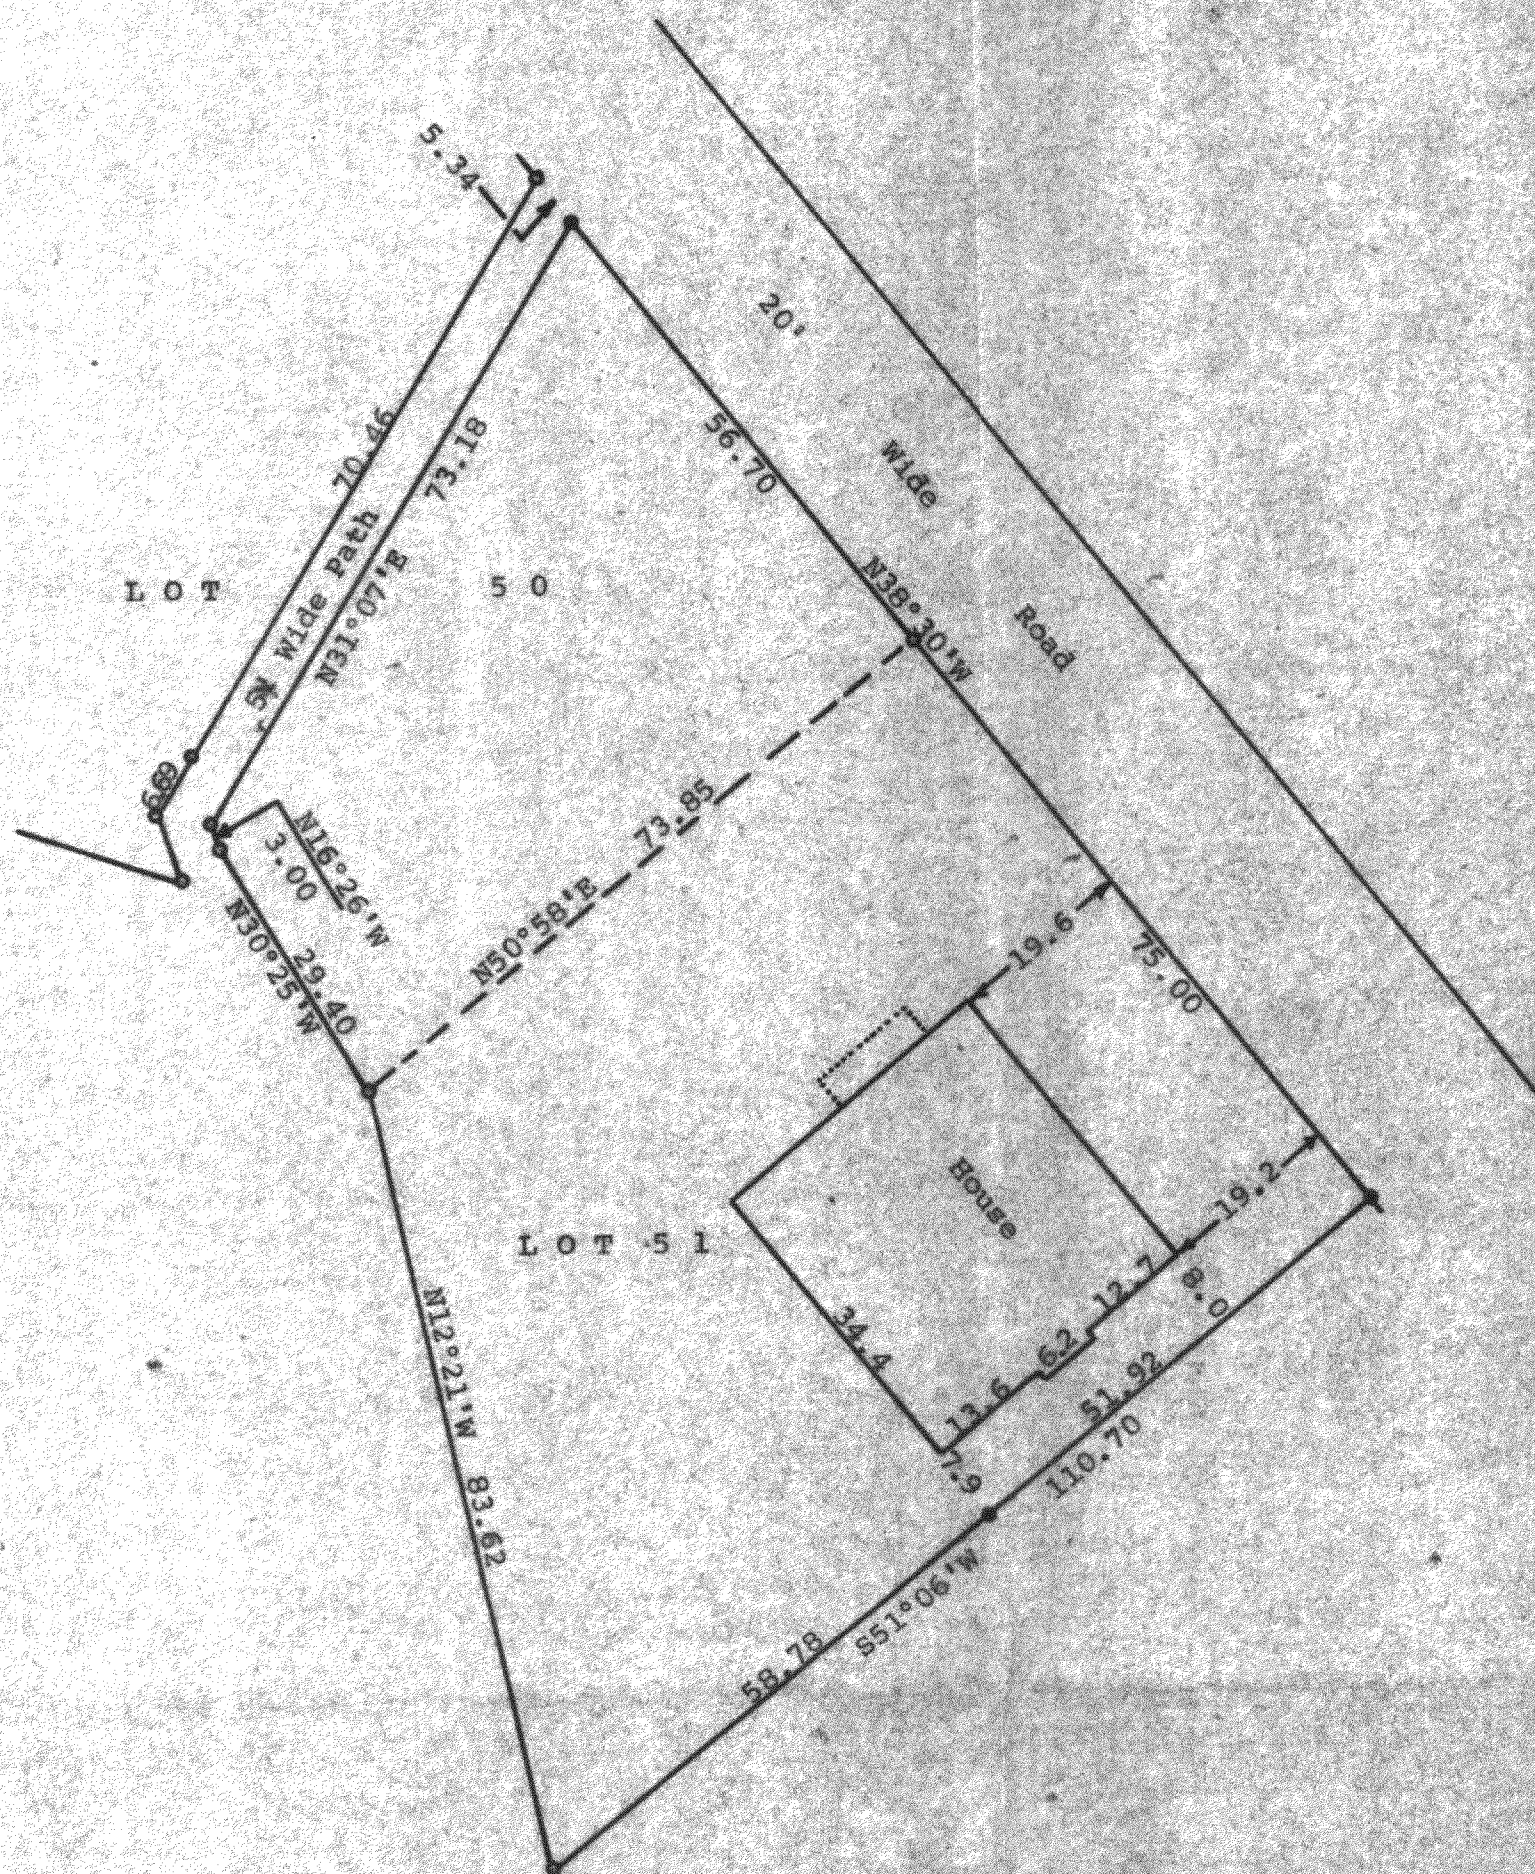

STATE OF WISCONSIN) SS
COUNTY OF WALWORTH)

I, George T. Dunham, Surveyor, certify that I have surveyed the property described as follows:


Lot 51 located in The Gardens, a subdivision located in the Village of Fontana-on-Geneva Lake, Walworth County, Wisconsin.

Also that part of Lot 50 of The Gardens, a subdivision located in the Village of Fontana-on-Geneva Lake, Walworth County, Wisconsin, described as follows:

Beginning at the most easterly corner of said Lot 50; thence N38°30'W along the northeasterly line of said Lot 50, 56.70 feet; thence S31°07'W 73.18 feet to the southwesterly line of said Lot 50; thence S16°26'E along said southwesterly line of said Lot 50, 3.00 feet; thence S36°25'E along said southwesterly line of said Lot 50, 29.40 feet to the most southerly corner of said Lot 50; thence N50°58'E 73.85 feet to the place of beginning.

and that the map shown hereon is a correct representation thereof and shows the size and location of the property, its exterior boundaries, the location of all visible structures and dimensions of all principal buildings thereon, boundary fences, apparent easements, roadways and visible encroachments, if any, and that I have surveyed the property hereon described according to the official records, to the best of my knowledge and belief.

October 28, 1987

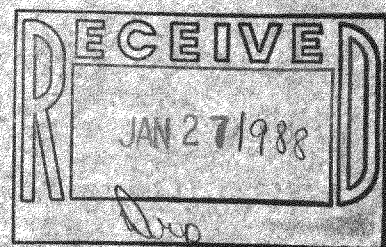

George T. Dunham
George T. Dunham, Surveyor

