
GEORGE T. DUNHAM

SURVEYING & SUBDIVIDING

DELAVAN, WISCONSIN

Public

Road

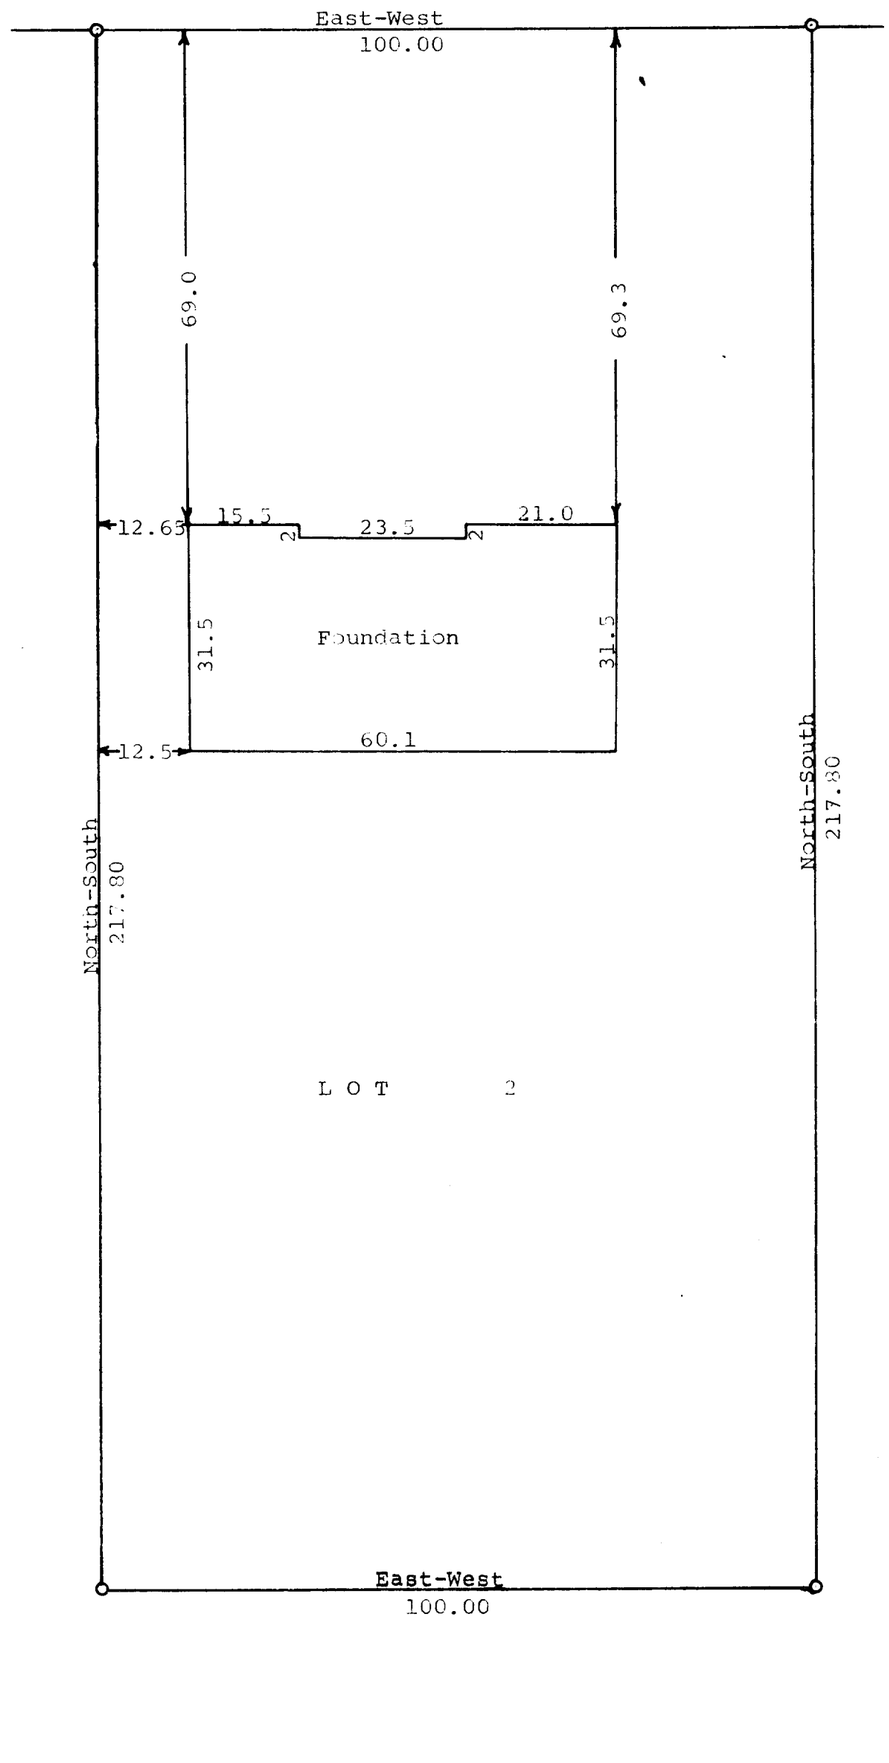

N

Scale - 1" = 20'

O = Iron Pipe

STATE OF WISCONSIN)
WALWORTH COUNTY) SS

I, George T. Dunham, Surveyor, certify that I have surveyed the property described as follows,

Lot 2, Block 4 in Brookwood Subdivision located in Govt Lot 4 and in the NW¼ of the SW¼ of Section 18, T 1 N, R 17 E, Village of Fontana, Walworth County, Wisconsin

and said survey was made at the request of FIRST FEDERAL SAVINGS & LOAN ASSOCIATION and the above plat is an accurate survey and a true representation thereof and correctly shows the exterior boundary lines and location of the foundation built thereon and the correct measurements thereof.

February 15, 1966

George T Dunham

George T Dunham, Wis Land Surveyor No. S-306

58538

K & E 10-5122--250-8.64

5-81