
KOLB LAND CONSULTING, INC.
LAND SURVEYING · SUBDIVIDING · LAND PLANNING
LAKE GENEVA, WISCONSIN

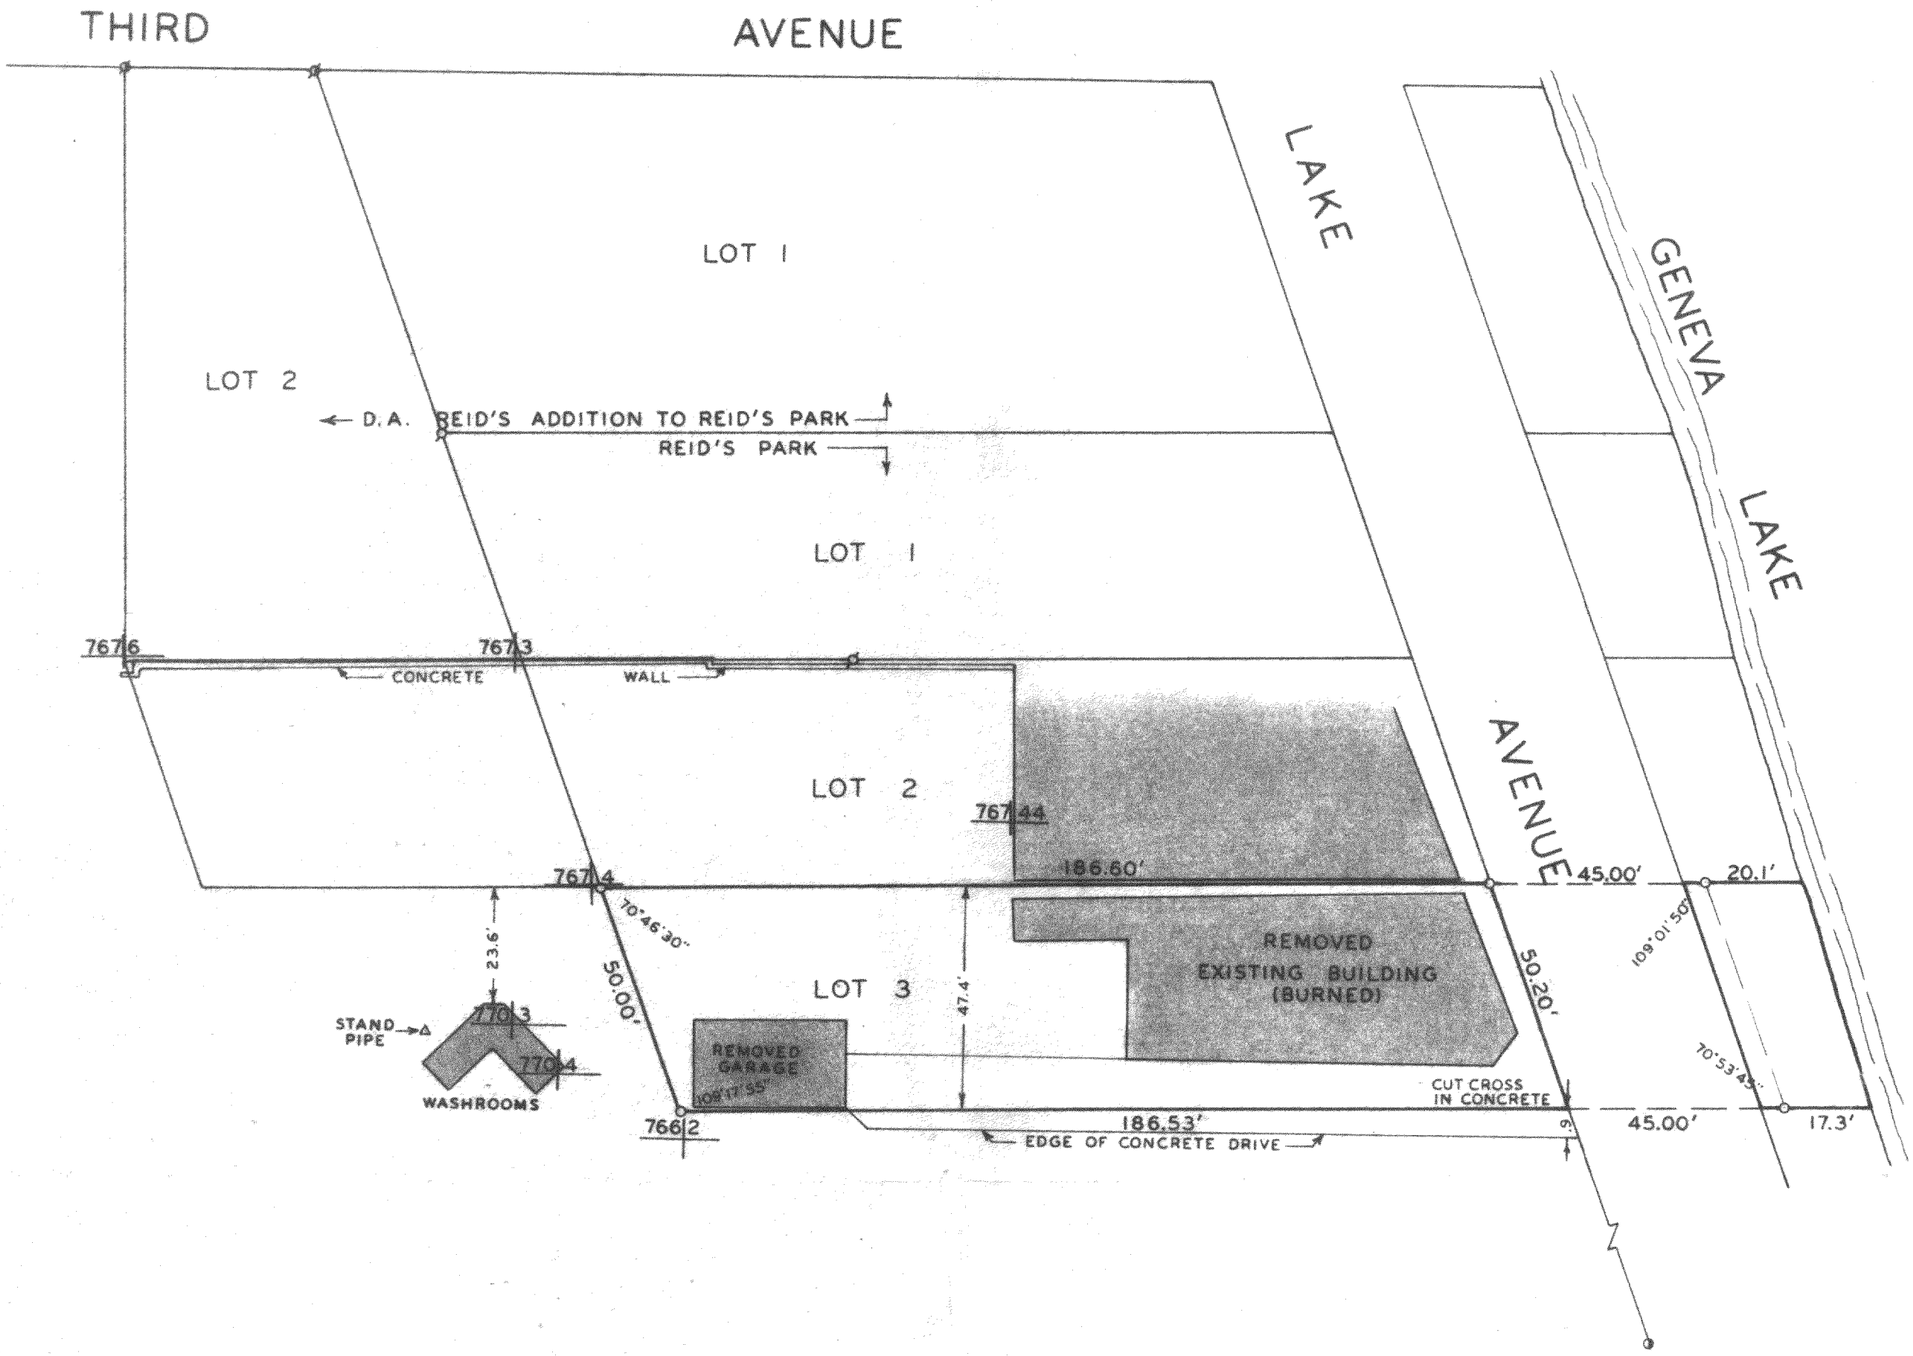

PLAT OF SURVEY OF

LOT 3 OF REID'S PARK, VILLAGE OF FONTANA-ON-GENEVA LAKE, WALWORTH COUNTY, WISCONSIN.

ORDERED BY: CHUCK'S LAKE SHORE INN
JAMIE WHOWELL
BOX 330
FONTANA, WI 53125

NOTE: GENEVA LAKE ELEVATION 763.94 AS SHOWN ON PLAT FROM DONAHUE AND ASSOC.

RECEIVED
MAY 19 1988

SCALE : 1" = 30'

LEGEND

- ø - IRON PIPE FOUND
- ø - IRON ROD FOUND
- o - IRON ROD SET
- 770.0 - ELEVATION

I, HAROLD H. KOLB, DO HEREBY CERTIFY THAT I HAVE SURVEYED THE PROPERTY HEREON DESCRIBED ACCORDING TO THE OFFICIAL RECORDS, AND THAT THE PLAT HEREON IS A CORRECT REPRESENTATION OF THE LOT LINES AND PRINCIPAL LINES OF THE BUILDING THEREON TO THE BEST OF MY KNOWLEDGE AND BELIEF.
SURVEY NOT VALID UNLESS SURVEYOR'S SIGNATURE IS IN RED.

HAROLD H. KOLB
WISCONSIN REGISTERED LAND SURVEYOR, S-137

DATE JANUARY 12, 1988
REVISED MARCH 2, 1988

SR-3

5-829