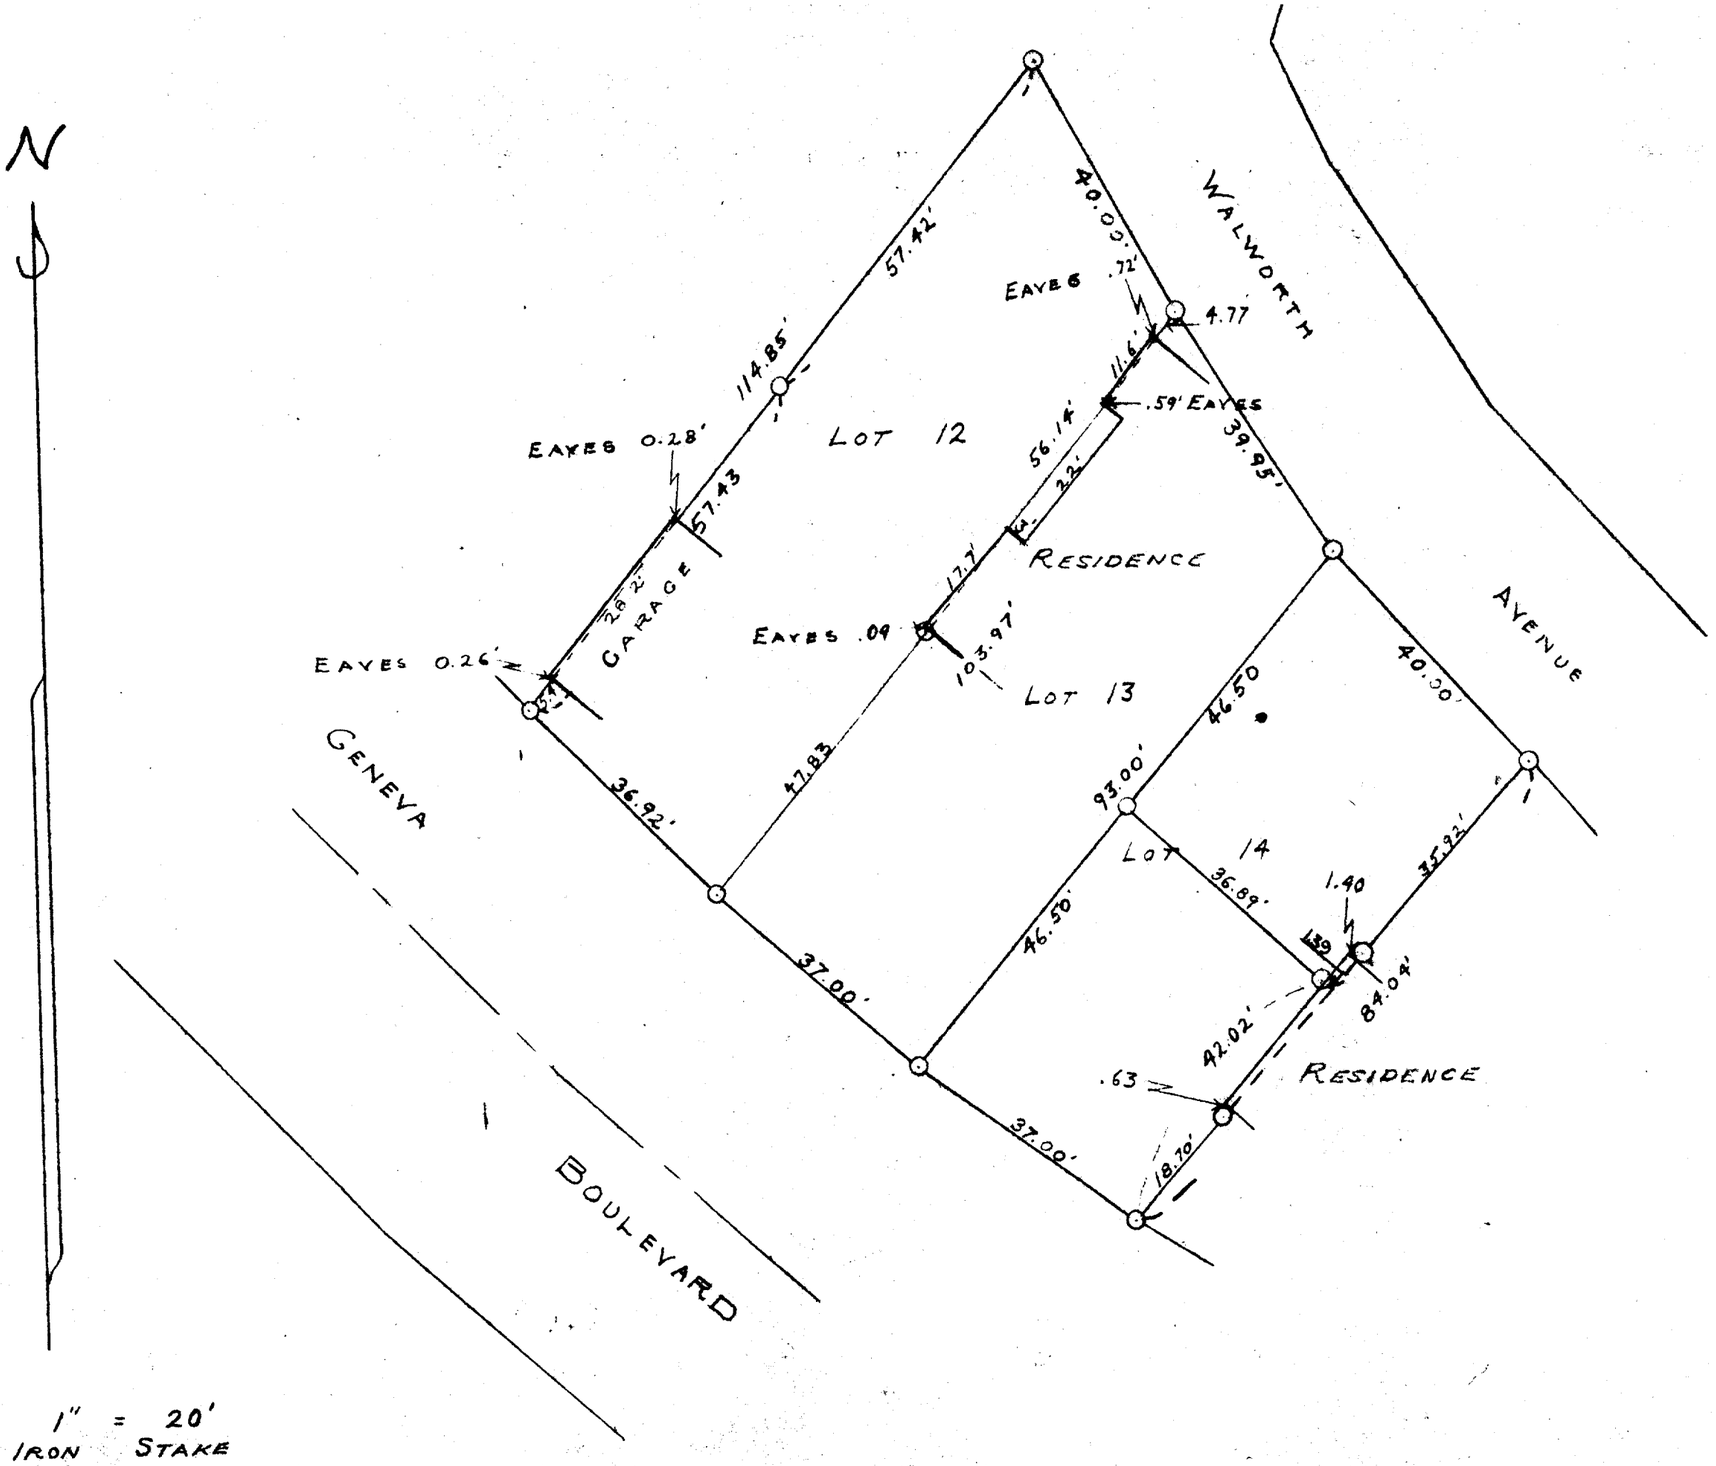


SCALE 1" = 20'
O = IRON STAKE

PLAT OF SURVEY OF LOTS 12 AND 14
BLOCK 7 GLENWOOD SPRINGS
WISCONSIN WALWORTH COUNTY.
OCTOBER 26 1951

Lloyd L. Jensen
COUNTY SURVEYOR

5-82J

SGS-35 39