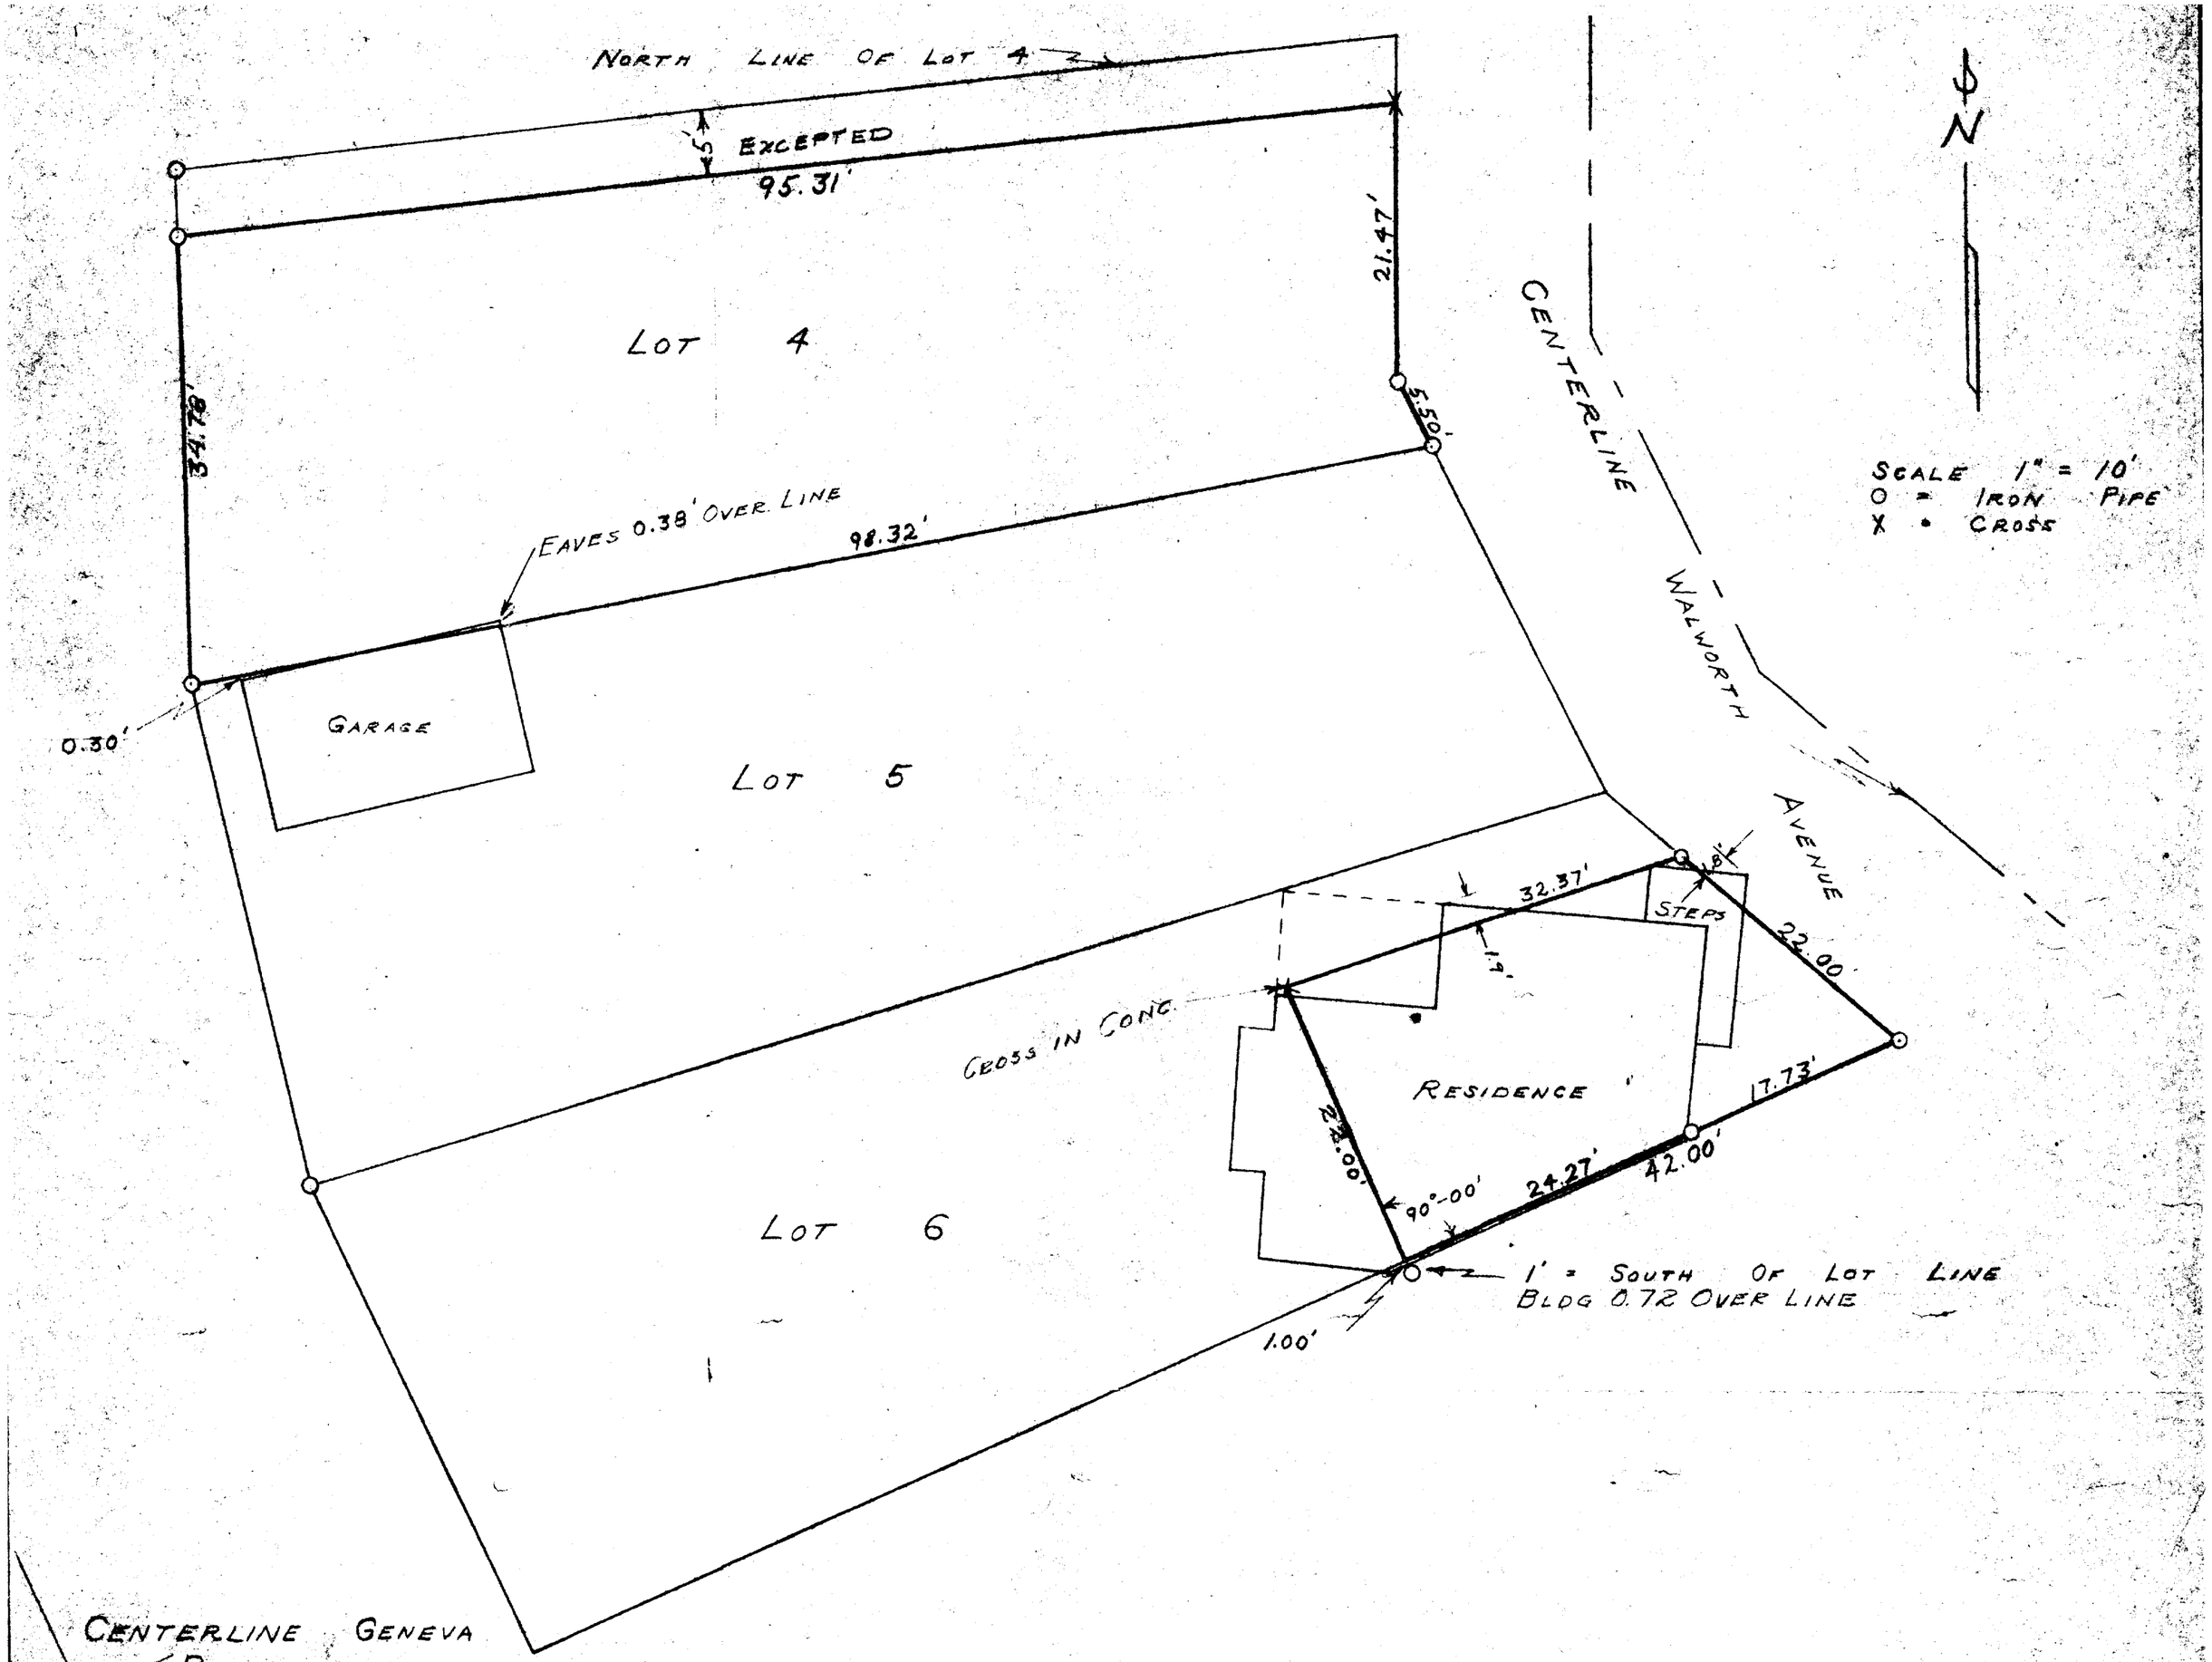


PLAT OF SURVEY OF PART OF LOT 7 OF
4 AND PART OF LOT 6 BLOCK 7 OF
GLENWOOD SPRINGS SUBDIVISION LOCATED IN
THE VILLAGE OF FONTANA WALWORTH COUNTY,
WISCONSIN.
APRIL 10, 1952

Floyd L. Jensen
WALWORTH COUNTY SURVEYOR

S6-24, 25

5-86J