
WALWORTH COUNTY
SURVEYING & MAPPING
LAKE GENEVA, WISCONSIN

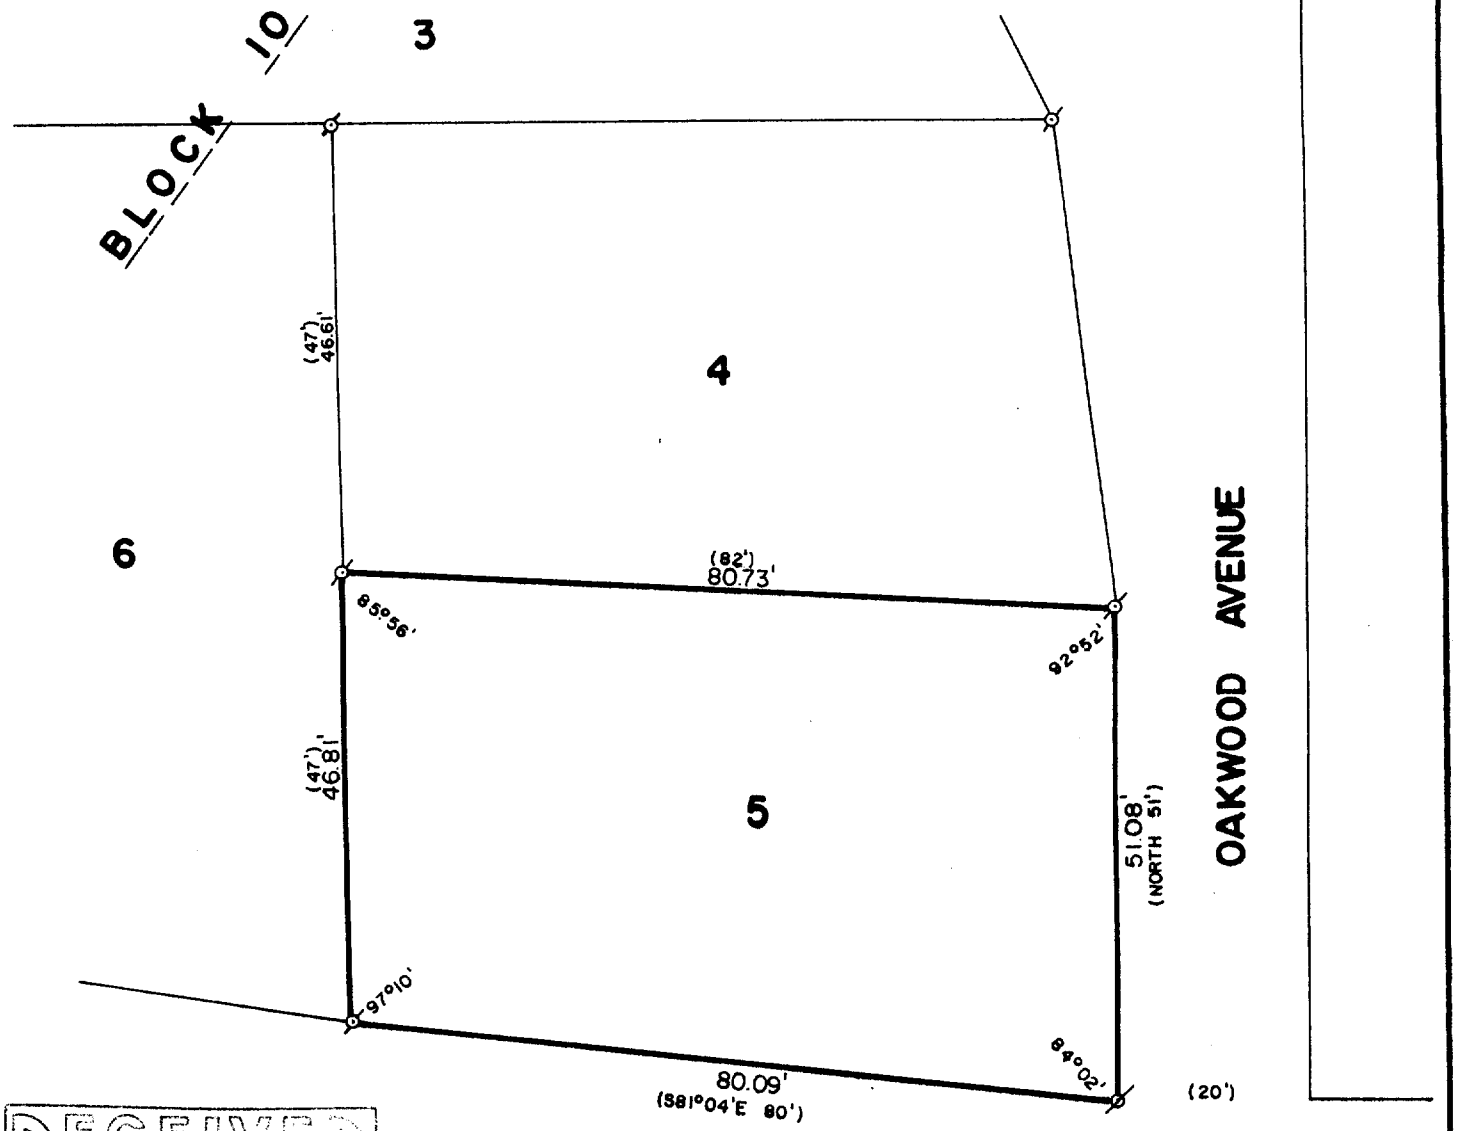

RECEIVED
JUL 19 1989

PLAT OF SURVEY OF

LOT 5, BLOCK 10 OF GLENWOOD SPRINGS, A SUBDIVISION LOCATED IN THE VILLAGE OF FONTANA-ON-GENEVA LAKE, WALWORTH COUNTY, WISCONSIN.

NOTE: UNDERGROUND DRAINAGE SYSTEM APPEARS TO BE DRAINING ON THIS PROPERTY FROM ADJACENT LANDS.

ORDERED BY: ATTORNEY PAUL LANTHIER
568 SPRING ROAD
ELMHURST, ILLINOIS
60126

SCALE: 1"=20'

ø-IRON PIPE FOUND
ø-IRON ROD FOUND
()-RECORDED AS

I HEREBY CERTIFY THAT I HAVE SURVEYED THE ABOVE DESCRIBED PROPERTY AND THAT THE ABOVE MAP IS A TRUE REPRESENTATION THEREOF AND SHOWS THE SIZE AND LOCATION OF THE PROPERTY, ITS EXTERIOR BOUNDARIES, THE LOCATION OF ALL VISIBLE STRUCTURES AND DIMENSIONS OF ALL PRINCIPAL BUILDINGS THEREON, BOUNDARY FENCES, APPARENT EASEMENTS AND ROADWAYS AND VISIBLE ENCROACHMENTS, IF ANY.

THIS SURVEY IS MADE FOR THE EXCLUSIVE USE OF THE PRESENT OWNERS OF THE PROPERTY, AND ALSO THOSE WHO PURCHASE, MORTGAGE, OR GUARANTEE THE TITLE THERETO WITHIN ONE (1) YEAR FROM DATE HEREOF.

Robert M. Baerenwald
ROBERT M. BAERENWALD
WISCONSIN REGISTERED LAND SURVEYOR, S-1508

March 30, 1989
DATE JOB NO. 1898

NOTE: THIS IS NOT A CERTIFIED COPY UNLESS SEALED.

SGS-58

5-973