
FEATHERSTON DRIVE

110.36
S 73° 42' E

LOT 8 OF ADDITION A TO COUNTRY CLUB ESTATES, FONTANA-ON-GENEVA LAKE, WALWORTH COUNTY, WISCONSIN.

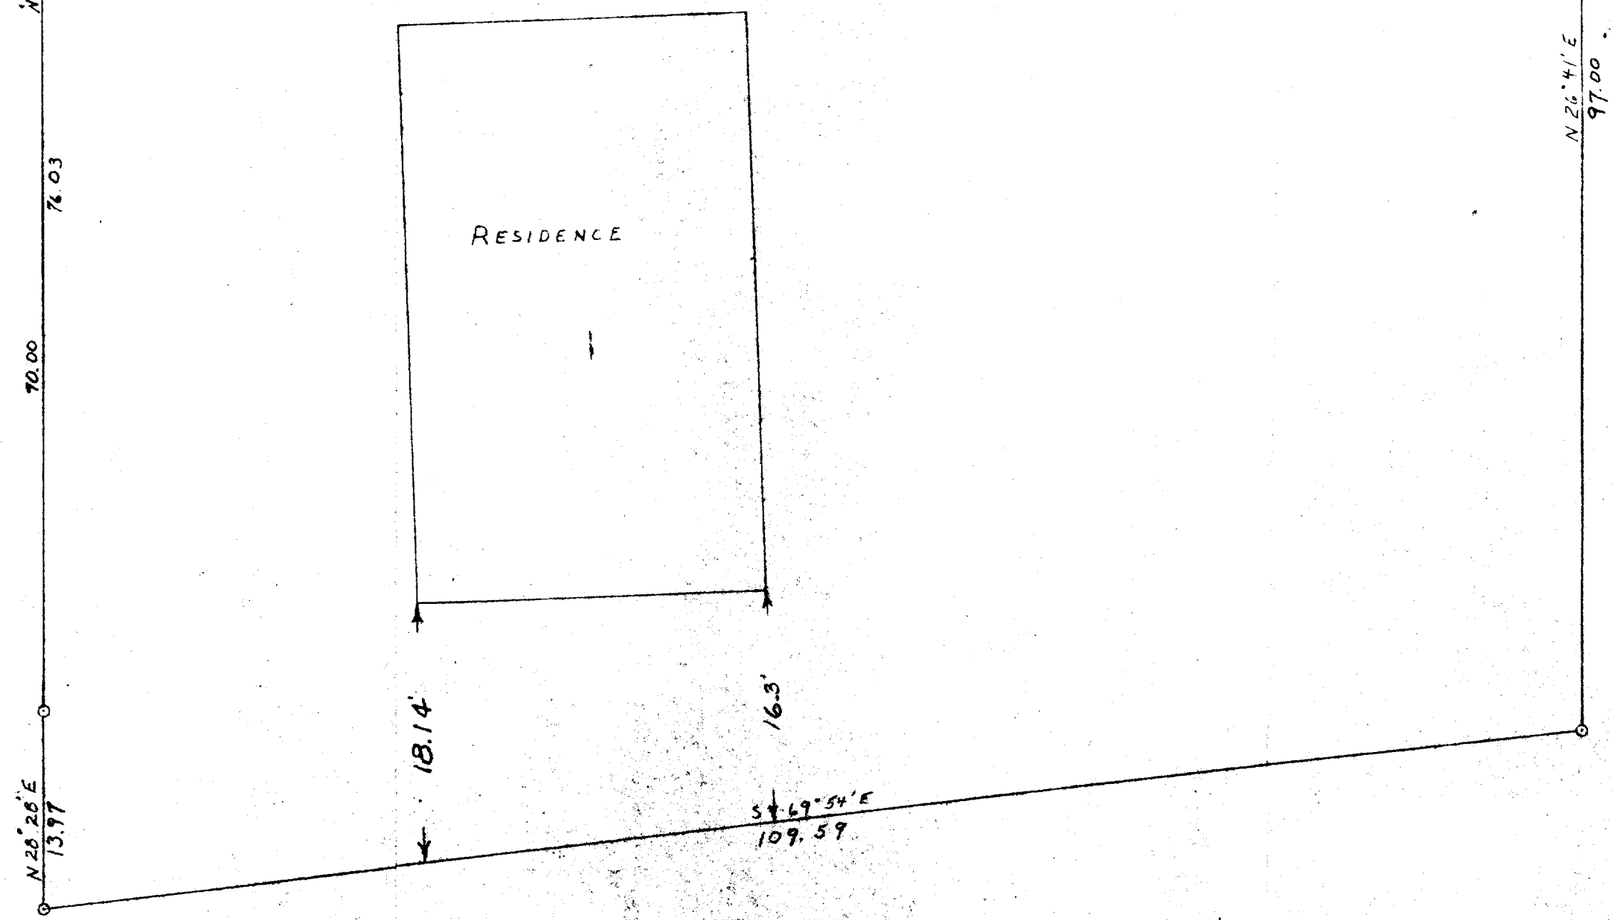

KEY

o - IRON PIPE

SCALE 1" = 10'

STATE OF WISCONSIN) SS.
WALWORTH COUNTY)

I, LLOYD L. JENSEN, DO HEREBY CERTIFY THAT I HAVE SURVEYED THE PROPERTY DESCRIBED ABOVE ACCORDING TO THE OFFICIAL RECORDS, AND THAT THE PLAT ABOVE IS A CORRECT REPRESENTATION OF THE LOT LINES AND PRINCIPAL LINES OR BUILDINGS THEREON. MARCH 24, 1953 Lloyd L. Jensen, SURVEYOR 5-975

SCM-8