
#57-63

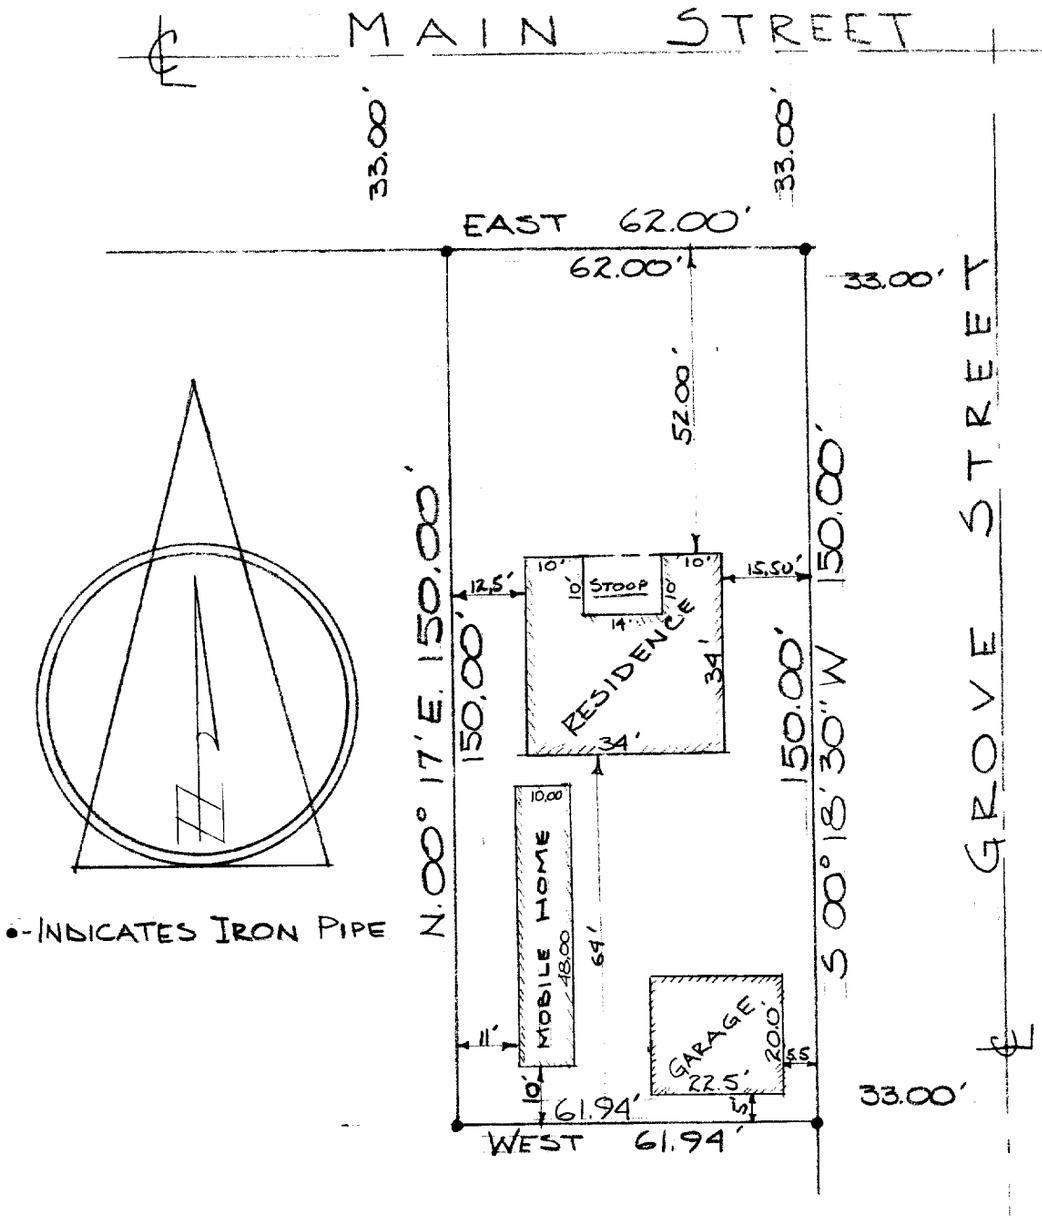

DESCRIPTION:

Lot 5, Zarnstorff Subdivision of a portion of Genoa City, Walworth County, Wisconsin.

CERTIFICATE:

I, James F. Biagi, surveyor, do hereby certify that I have surveyed the property hereon described and the location of the improvements are as shown.

May 23rd 1963.

WISCONSIN JAMES F. BIAGI MILWAUKEE, WIS. LAND SURVEYOR

James F. Biagi. RLS 272
Elkhorn, Wisconsin.

T52-5

6-10B