
#124-72

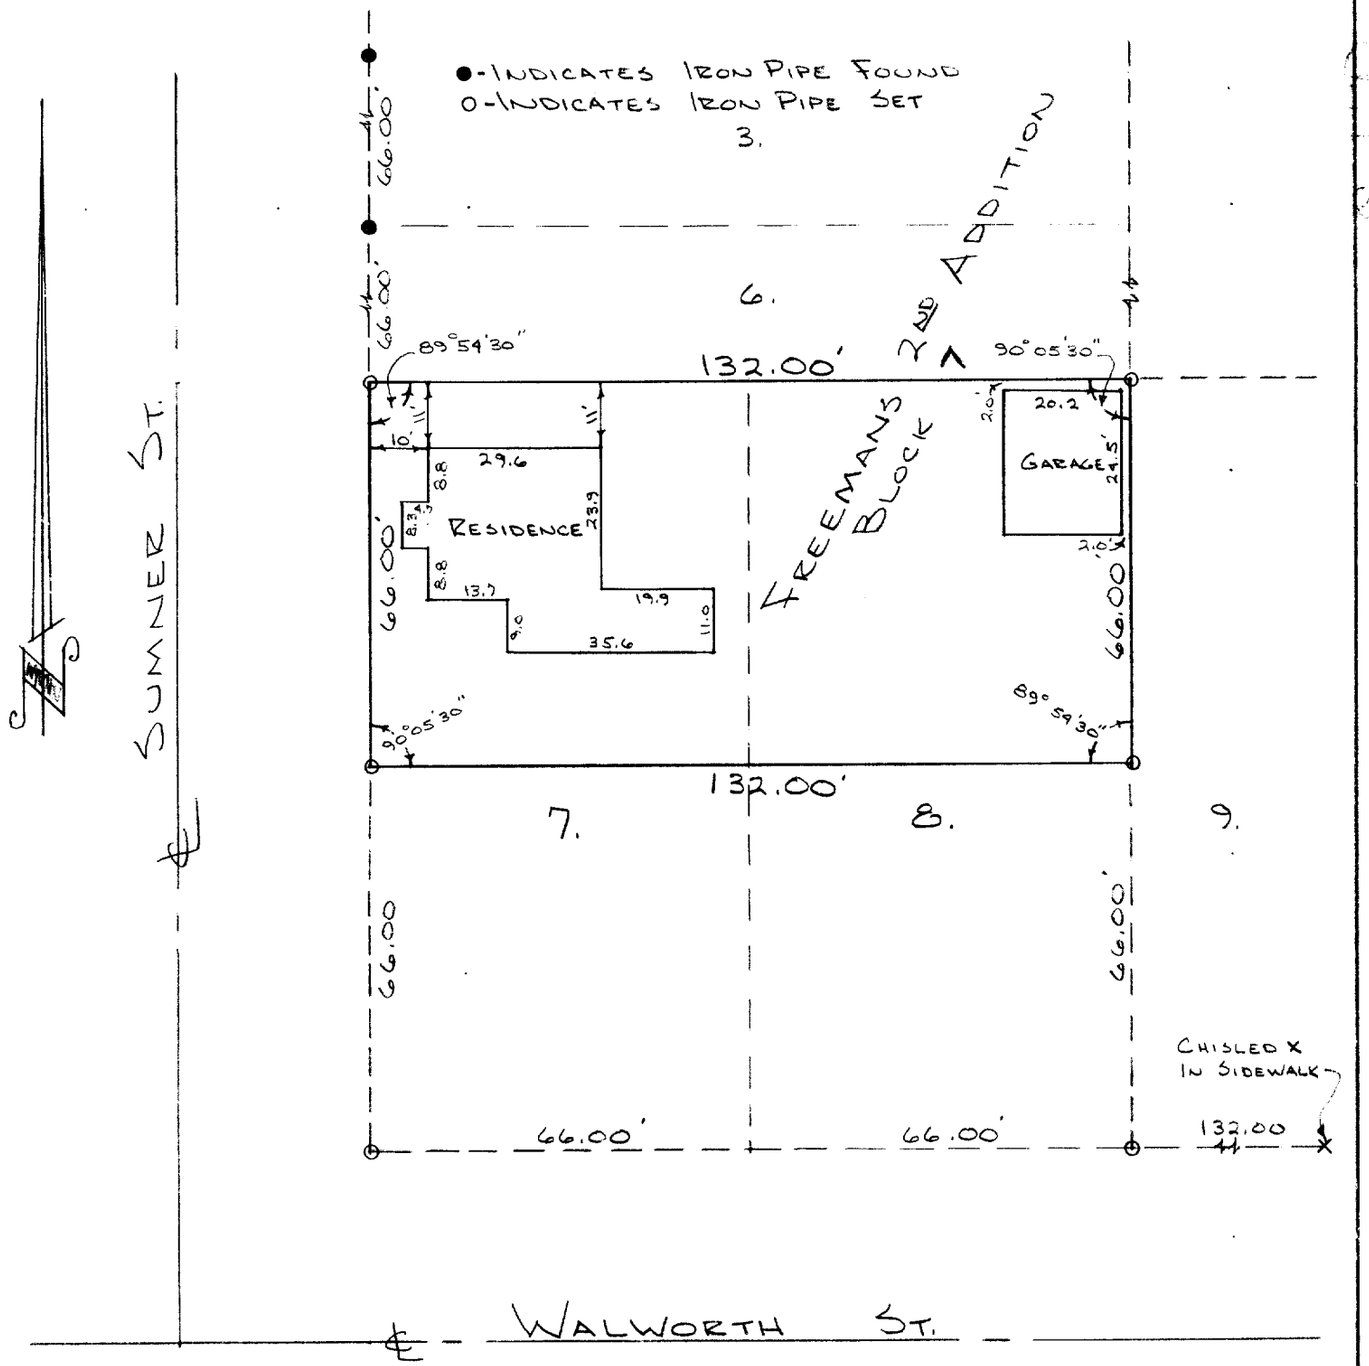

DESCRIPTION:
The North One-Half (½) of Lots number Seven (7) and number Eight (8) of Block number Seven (7) of Freemans 2nd Addition to the Village of Genoa City, Walworth County, Wisconsin.

CERTIFICATE:
I, James F. Biagi, surveyor, do hereby certify that I have surveyed the lands hereon described.

October 18, 1972

James F. Biagi RLS #272

WISCONSIN
JAMES F. BIAGI
MILWAUKEE, WIS.
LAND SURVEYOR

TFR2 32

6-1B