
PLAT OF SURVEY
-OF-

LOT 30 IN THE PLAT OF HORNSBY BUSINESS PARK FIRST ADDITION, BEING LOCATED IN THE NORTHWEST 1/4 AND THE SOUTHWEST 1/4 OF SECTION 36, T1N, R18E, VILLAGE OF GENOA CITY, COUNTY OF WALWORTH, STATE OF WISCONSIN.

SURVEY FOR: RE/MAX SOUTHERN LAKES

SURVEY LOCATION: _____ ELIZABETH LANE

RECEIVED
JUL 10 2006
SMF

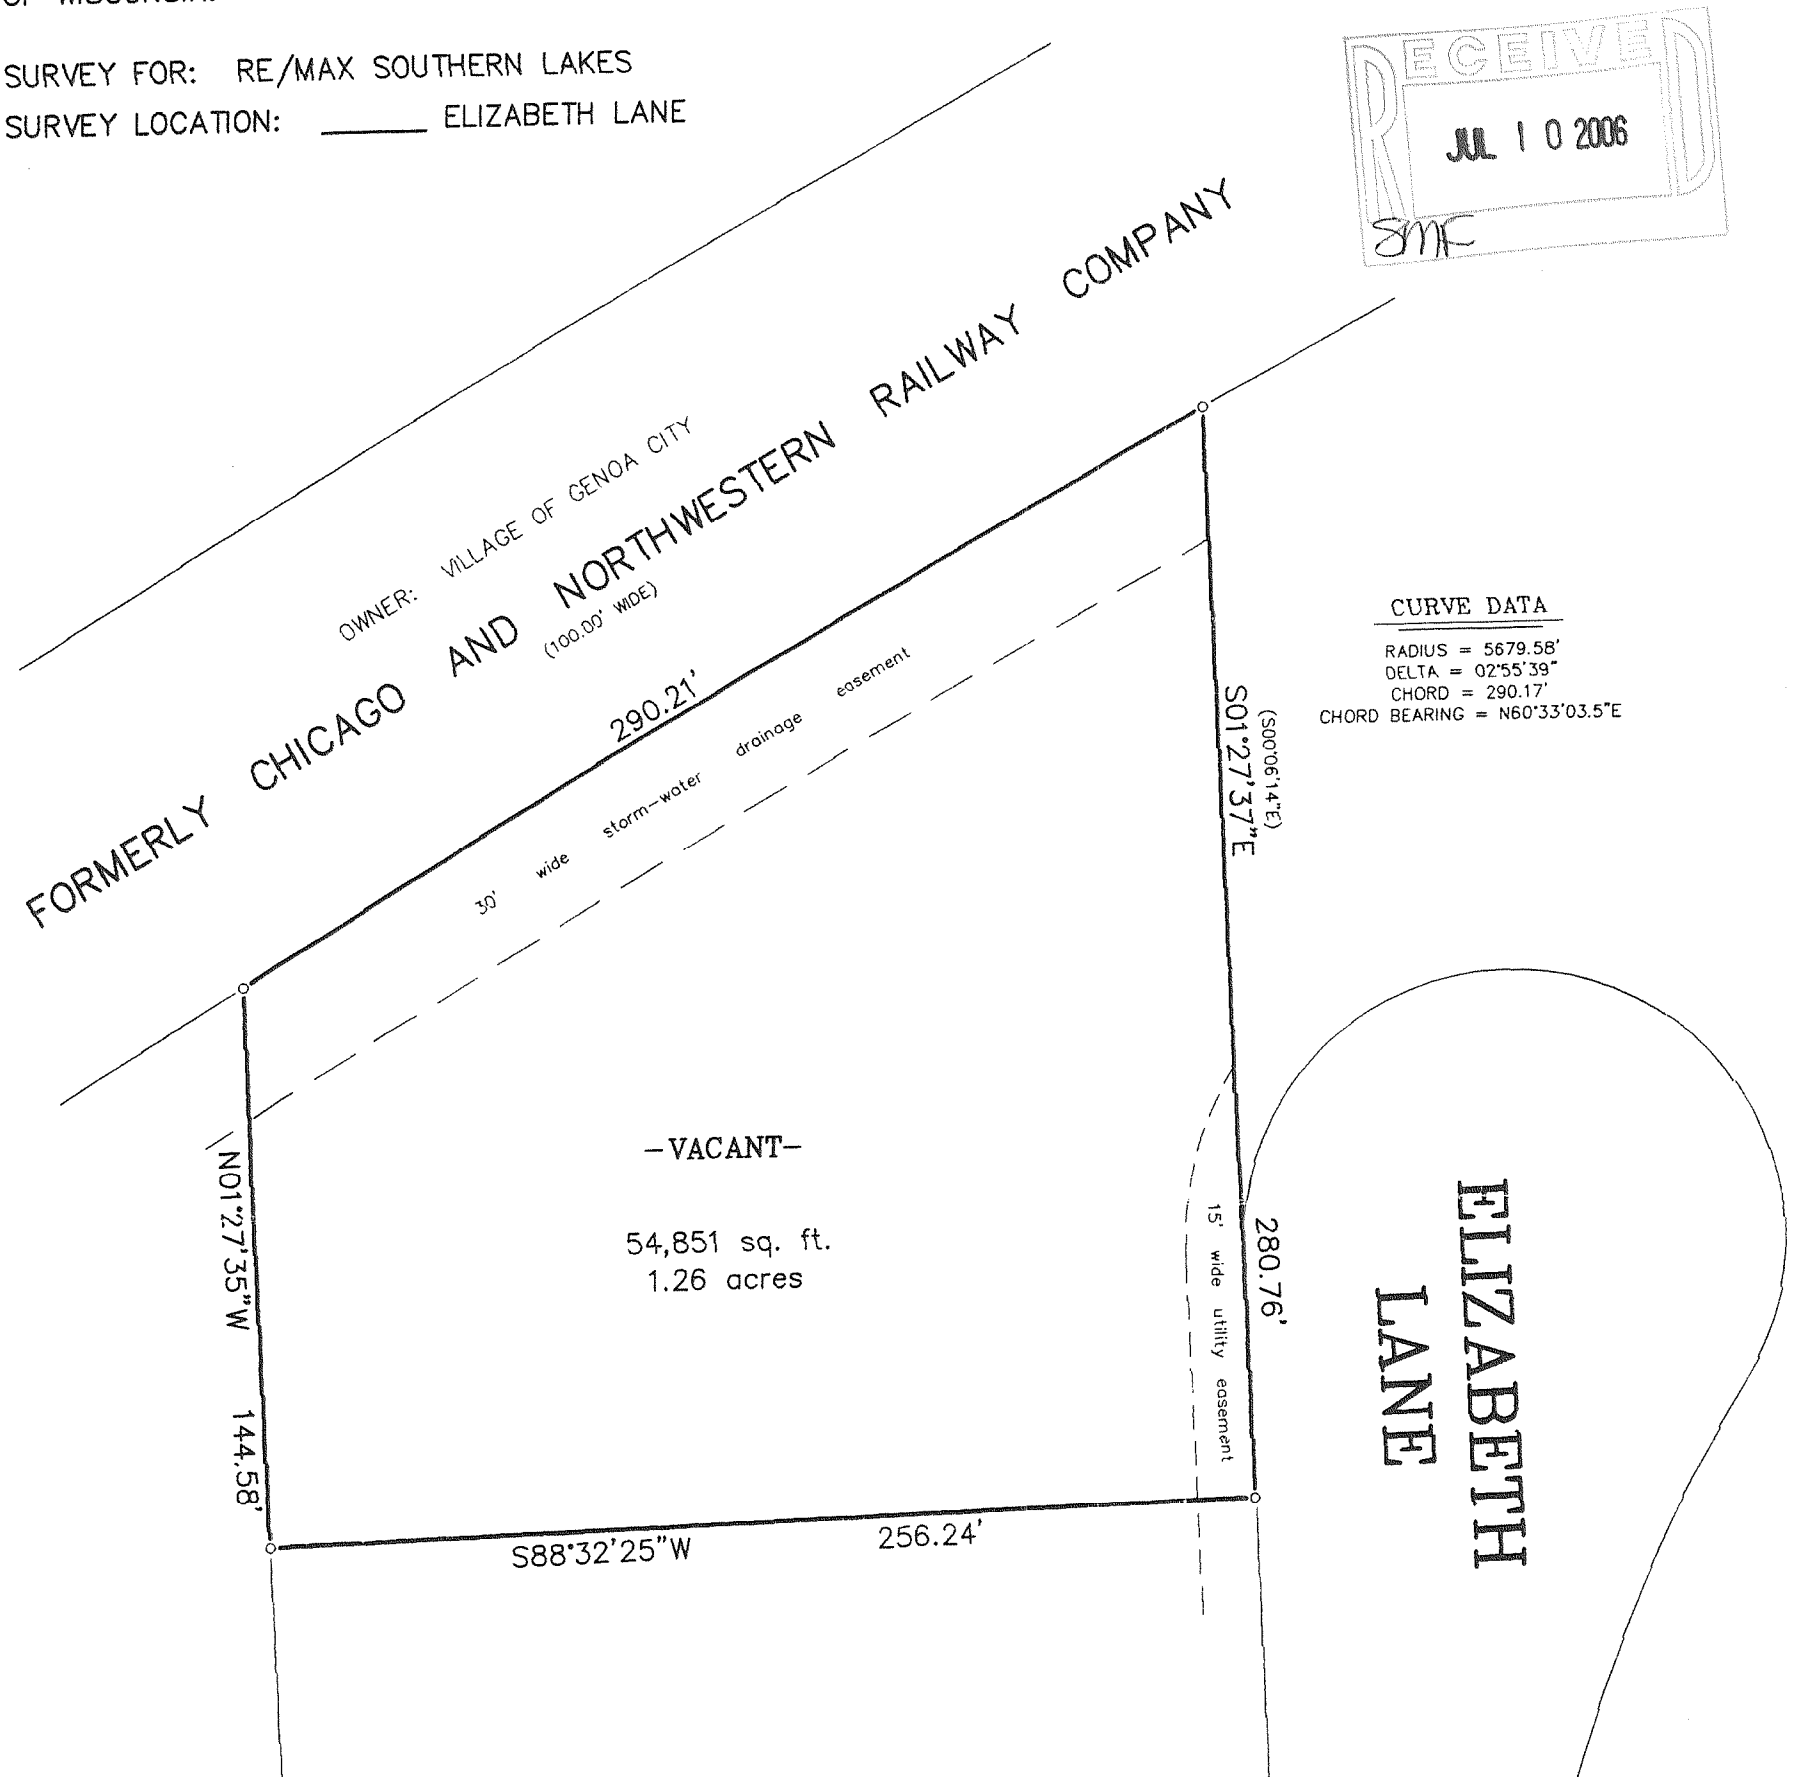

CURVE DATA

RADIUS = 5679.58'
DELTA = 02°55'39"
CHORD = 290.17'
CHORD BEARING = N60°33'03.5"E

LEGEND

- o FOUND IRON PIPE
- • SET IRON PIPE
- ( ) RECORDED AS

SCALE: 1" = 50'

"I hereby certify that I have surveyed the above described property and that the above map is a correct representation thereof and shows the size and location of the property, its exterior boundaries, the location of all visible structures and dimensions of all principal buildings thereon, boundary fences, apparent easements, roadways and encroachments, if any."

"This survey is made for the use of the present owners of the property, and those who purchase, mortgage, or guarantee the title thereto within one year from date hereof."

WISCONSIN
ROBERT J. WETZEL
S-1778
BURLINGTON WIS.
LAND SURVEYOR

THIS IS NOT AN ORIGINAL PRINT UNLESS THIS SEAL IS RED.

B.W. SURVEYING, INC.
LAND SURVEYS
MAPPING AND PLANNING
412 N. PINE STREET
BURLINGTON, WI 53105
(262)-767-0225

Robert J. Wetzel
ROBERT J. WETZEL S-1778

FEBRUARY 2, 2006 — DATE

7153 — JOB NUMBER

006-1237

THBP1-3