


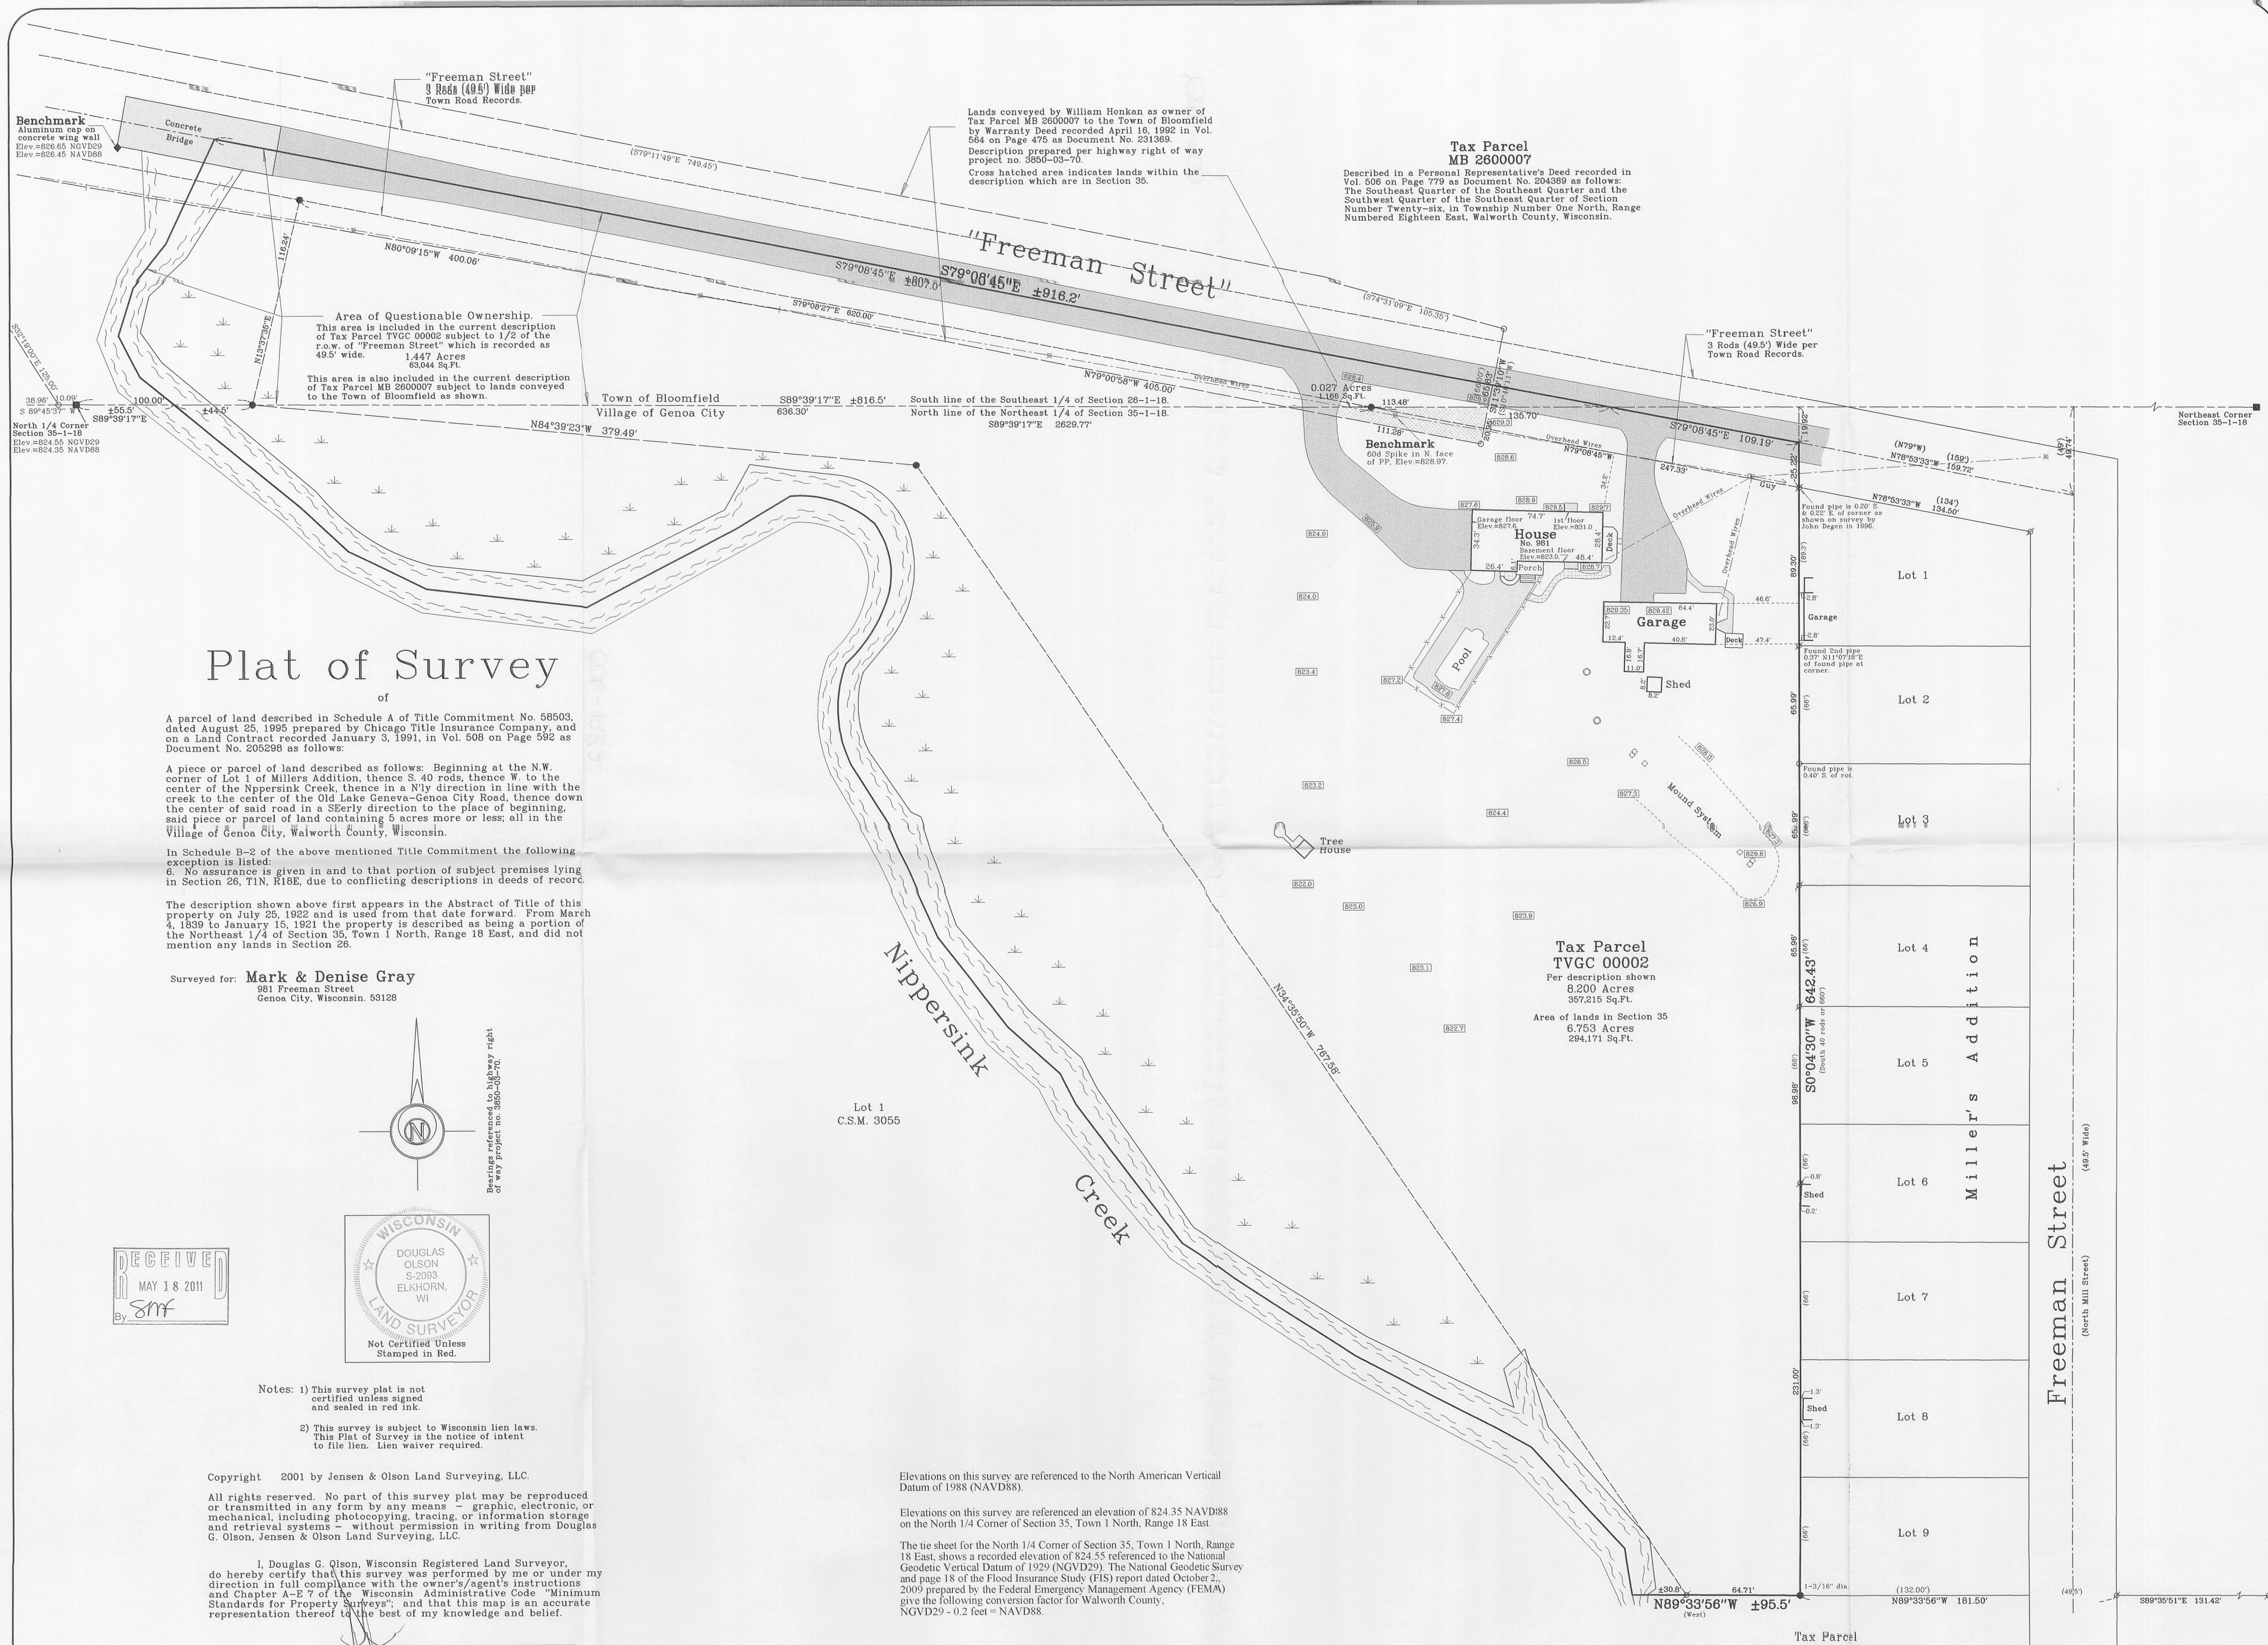

Survey date: September 26, 2001.  
Revisions: No. 1 - Elevations

Scale in Feet  
1" = 40'

Jensen & Olson Land Surveying, LLC

## Legend

- Found County Section Corner
- ⊗ Found Iron Pipe
- Found Iron Rod
- Set Iron Rod, 3/4" dia. unless noted
- ) Recorded Information
- ⊗ Utility Pole
- Utility Pedestal
- Concrete Cover
- Concrete Surface
- ▨ Asphalt Surface
- ▨ Brick Pavers

Sheet 1 of 1 Sheets.

---

Job Reference Number  
2010.095