

PLAT OF SURVEY


Situated on Elizabeth Lane, in the Village of Genoa City, Walworth County, Wisconsin.

Lots 4 & 5, Hornsby Business Park as recorded in Cabinet B Slide 94 Document No. 194058, located in Northwest 1/4 of the Southwest 1/4 of Section 36 Town 1 North, Range 18 East, in the Village of Genoa City, Walworth County, Wisconsin.

April 27, 2016

Surcenter Development



Survey No. 166778-RMK

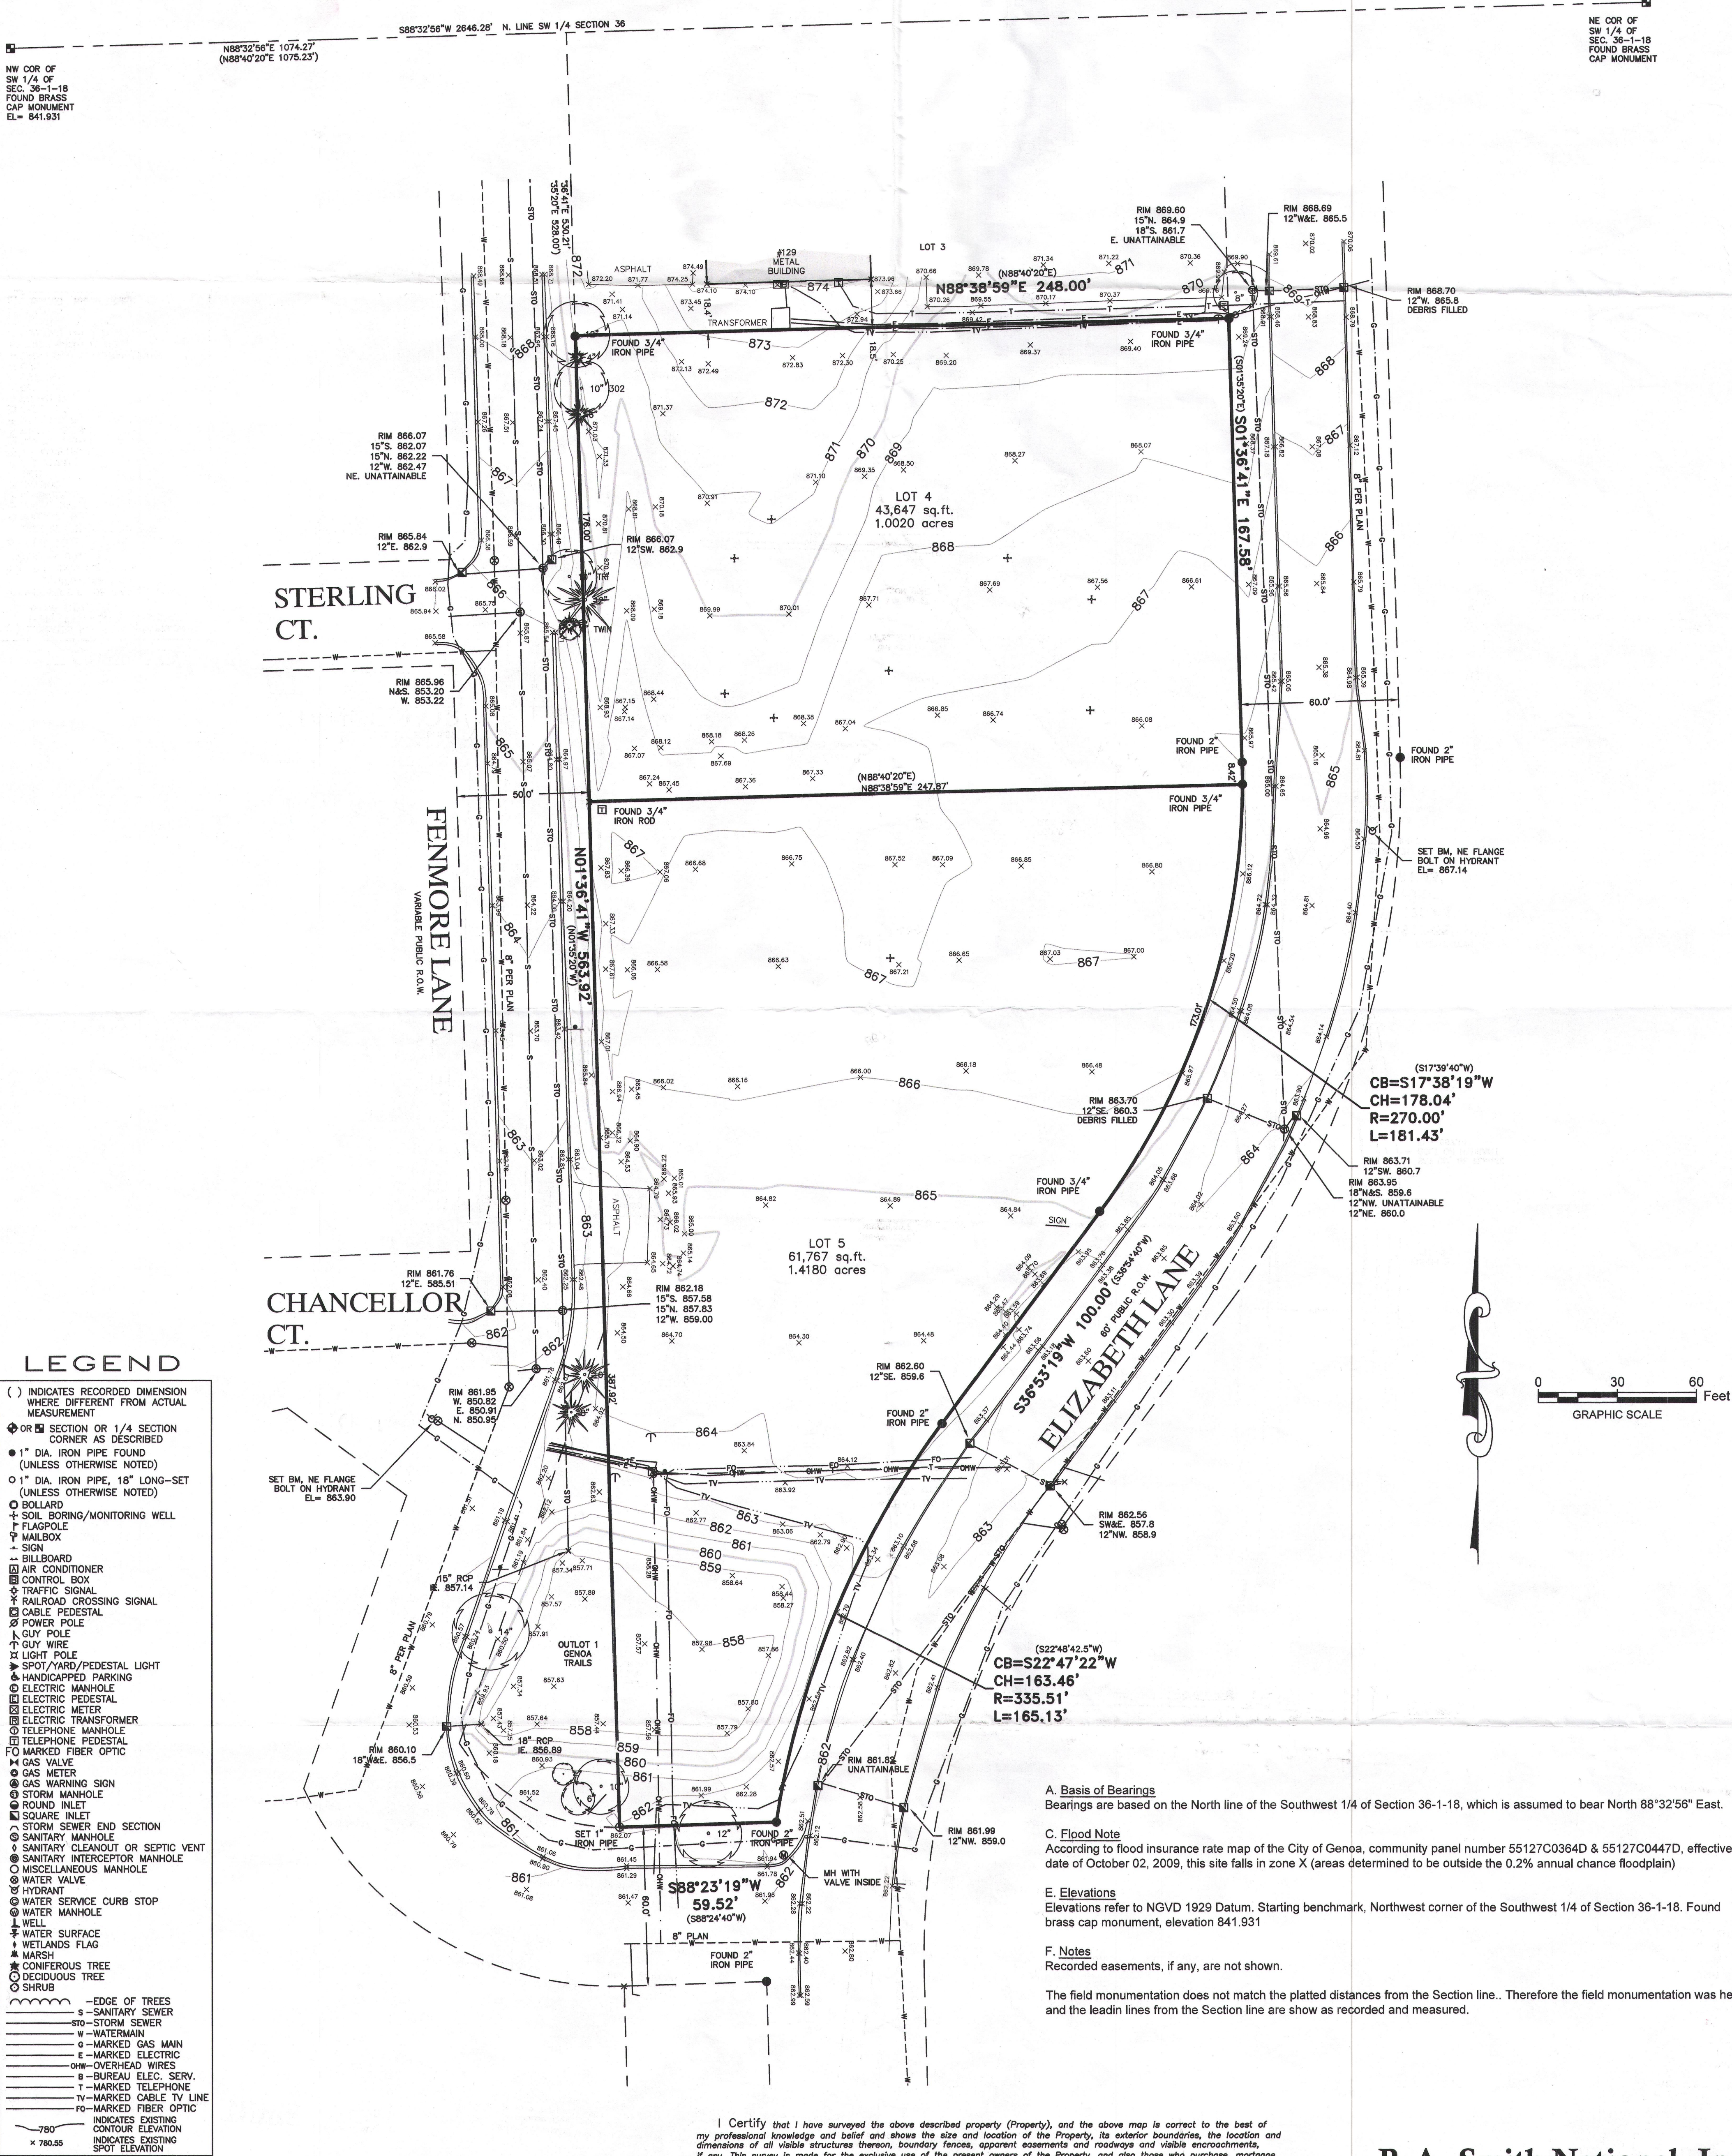

DIGGERS HOTLINE TICKET NO. 2016-16-05059 & OTHERS

THE UNDERGROUND UTILITY INFORMATION AS SHOWN HEREON IS BASED, IN PART, UPON INFORMATION FURNISHED BY UTILITY COMPANIES AND THE LOCAL MUNICIPALITY. WHILE THIS INFORMATION IS BELIEVED TO BE RELIABLE, ITS ACCURACY AND COMPLETENESS CANNOT BE GUARANTEED NOR CERTIFIED TO.

(P) INDICATES PIPE SIZES PER RECORD PLANS. OTHER PIPE SIZES ARE ESTIMATED. NO PIPE SIZES SHOULD BE RELIED UPON WITHOUT FURTHER VERIFICATION.

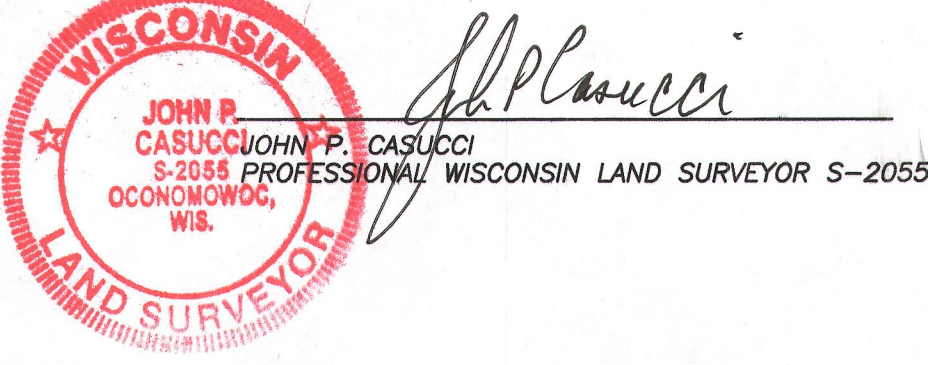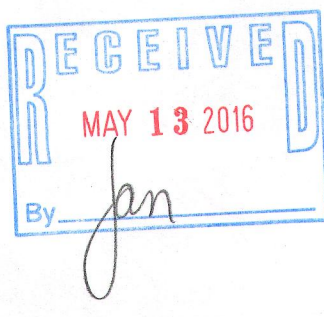

R.A. Smith National, Inc.

Beyond Surveying and Engineering

16740 W. Bluemound Road, Brookfield, WI 53005-8998
262-781-1000 Fax 262-797-7273, www.ra-smithnational.com
Appleton, WI Irvine, CA Pittsburgh, PA
S:\166778\dwg\PS101D30.dwg \ ELIZABETH LANE

THBP-4
THBP-5 006-1324

R.A. Smith National, Inc.