GRID NORTH


WISCONSIN STATE PLANE COORDINATE SYSTEM
SOUTH ZONE (NAD-27) E. LINE OF THE
SW 1/4 OF SECTION 25-1-18
BEARS N 01°26'58" W

PLAT OF SURVEY

SUPER MIX USA – SUPER AGGREGATES

LOT 1 OF CERTIFIED SURVEY MAP NO. 4653, RECORDED AS DOCUMENT NO. 926124

BEING A PART OF THE NE 1/4 & THE SE 1/4 OF THE SW 1/4, SECTION 25,
AND A PART OF THE NE 1/4 OF THE NW 1/4, SECTION 36, TOWN 1 NORTH,
RANGE 18 EAST, VILLAGE OF GENOA CITY, WALWORTH COUNTY, WISCONSIN

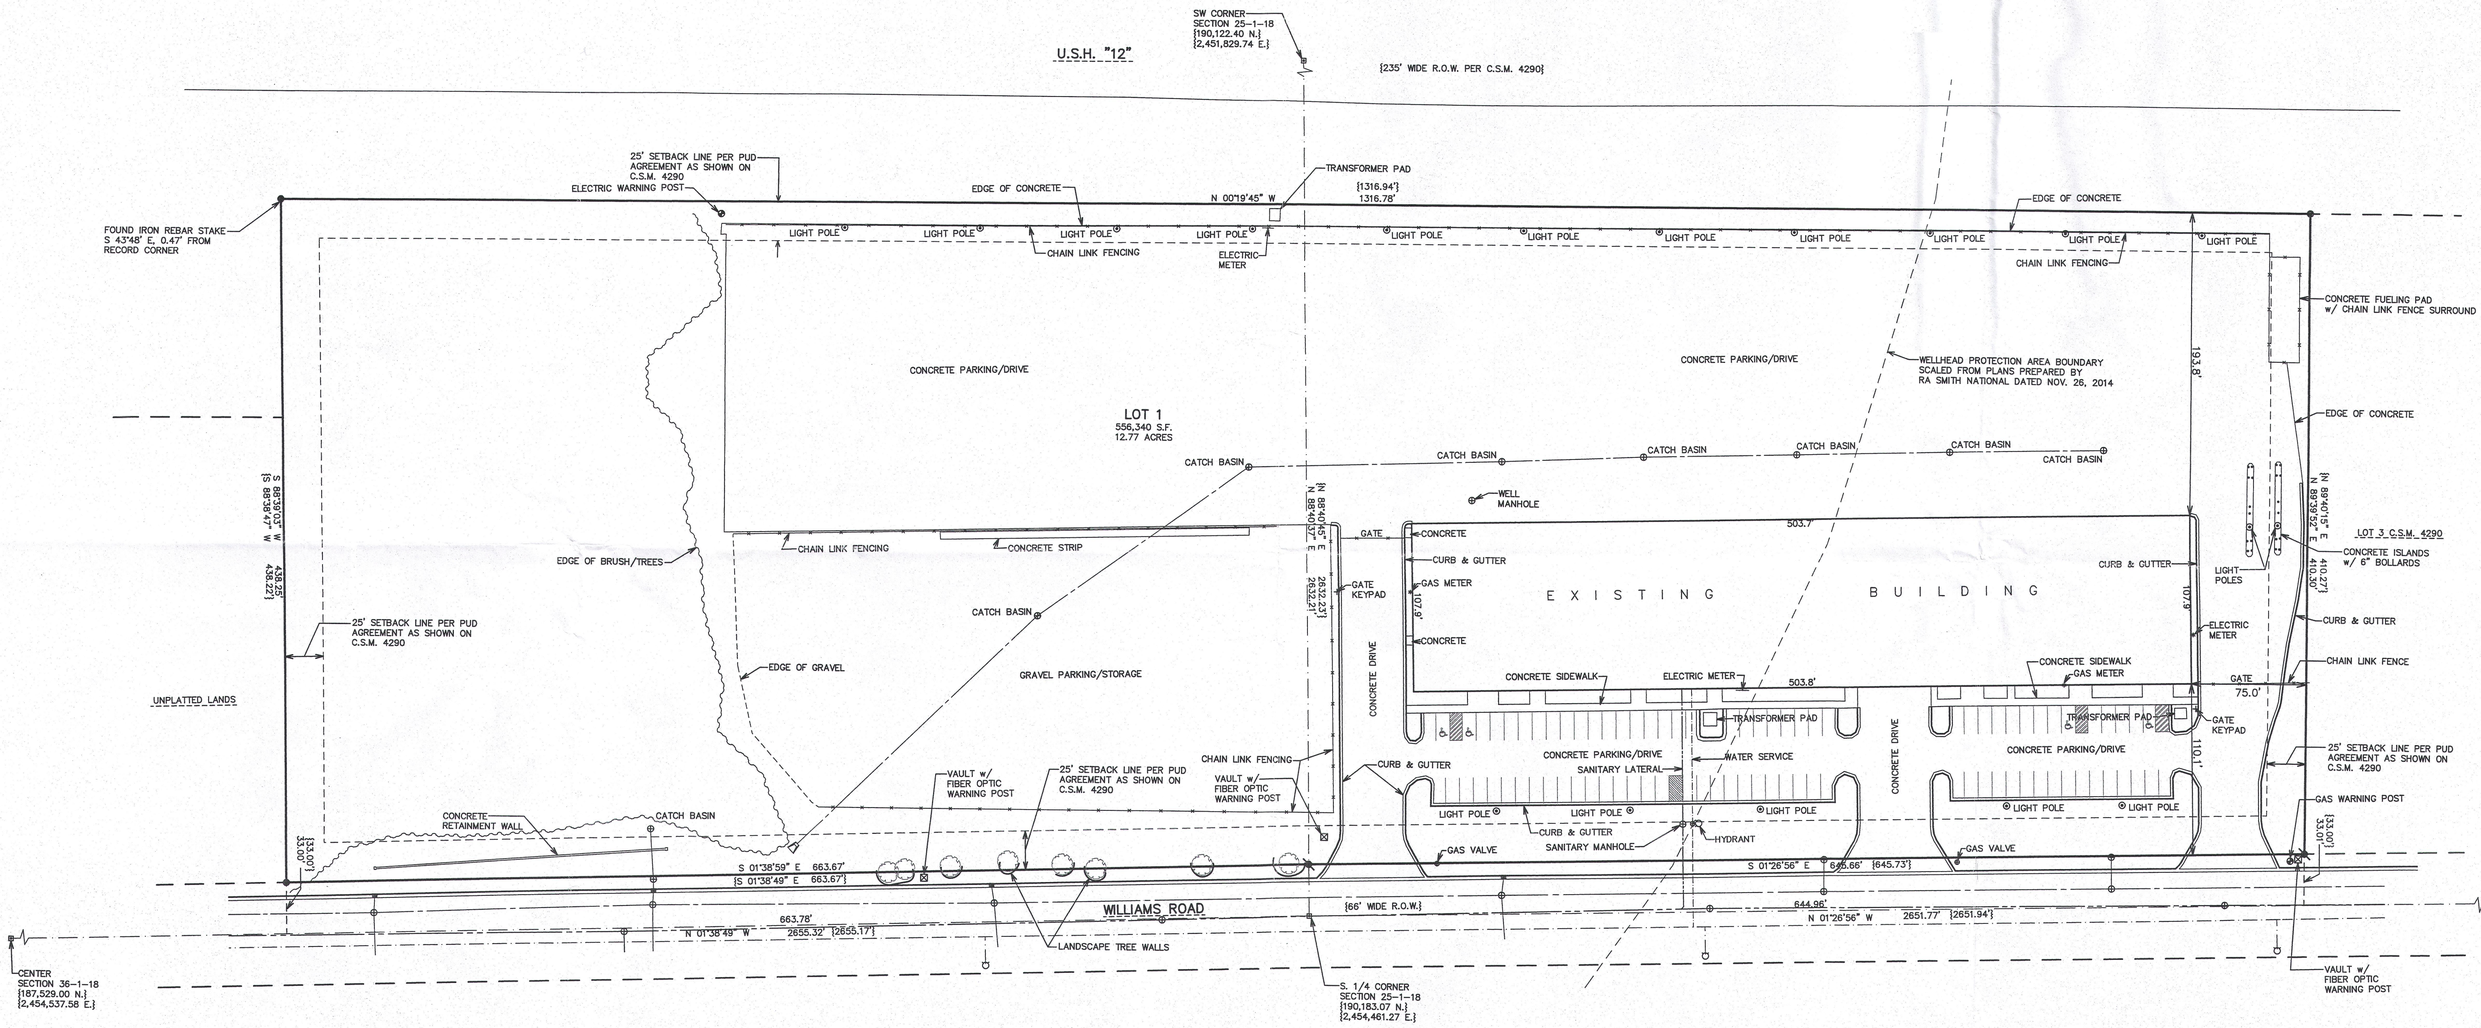

RECEIVED
AUG - 4 2016
BY:

LEGEND

- ● = FOUND IRON REBAR STAKE
- ⌀ = SET IRON REBAR STAKE, 3/4" DIA. x 24" x 1.50 LBS./FT.
- ⊞ = FOUND CONCRETE COUNTY MONUMENT W/ BRASS CAP
- {XXX} = RECORDED AS

LEGEND

- ⊕ = MANHOLE AND/OR CATCH BASIN LOCATION
- ═══ = CATCH BASIN IN CURB LOCATION
- ʊ = HYDRANT LOCATION
- ——— = UNDERGROUND STORM SEWER LINE
- ——— = UNDERGROUND SANITARY SEWER LINE
- —·—·— = UNDERGROUND WATERMAIN LINE

NOTE: COPIES OF THIS MAP TO WHICH THE FOLLOWING CERTIFICATE WILL APPLY SHO
THE SURVEYOR'S ORIGINAL SEAL AND SIGNATURE IN RED INK. COPIES BY ANY OTHE
MEANS MAY HAVE ALTERATIONS WHICH DO NOT REPRESENT THE SURVEYOR'S WORK
PRODUCT.

I HEREBY CERTIFY THAT THE ABOVE DESCRIBED PROPERTY HAS BEEN SURVEYED UND
MY DIRECTION AND THAT THE ABOVE MAP IS A TRUE REPRESENTATION THEREOF AND
SHOWS THE SIZE AND LOCATION OF THE PROPERTY, ITS EXTERIOR BOUNDARIES, THE
LOCATION OF ALL VISIBLE STRUCTURES, AND DIMENSIONS OF ALL PRINCIPLE
BUILDINGS THEREON, BOUNDARY FENCES, APPARENT EASEMENTS, ROADWAYS, AND
VISIBLE ENCROACHMENTS, IF ANY. THIS SURVEY IS MADE FOR THE USE OF THE
PRESENT OWNERS OF THE PROPERTY, AND ALSO THOSE WHO PURCHASE, MORTGAGE,
GUARANTEE THE TITLE THERETO WITHIN ONE YEAR FROM THE DATE HEREOF.

DATED: JUNE 1, 2016

PETER S. GORDON P.L.S. 2101

WISCONSIN
PETER S. GORDON
S-2101
ELKHORN, WI
LAND SURVEYOR

100 90 80 70 60 50 40 30 20 10 0 50 100
MAP SCALE IN FEET ORIGINAL 1" = 50'

PLAT OF SURVEY

VILLAGE OF GENOA CITY, WALWORTH COUNTY, WISCONSIN

– WORK ORDERED BY –
SUPER MIX USA – SUPER AGGREGATES
5435 BULL VALLEY ROAD, SUITE 330
McHENRY, IL 60050

FARRIS, HANSEN & ASSOCIATES, INC.
Engineering, Architecture, Surveying
7 Ridgway Court P.O. Box 437
ELKHORN, WISCONSIN 53121
Office: (262) 723-2098
Fax: (262) 723-5886

REVISIONS

PROJECT NO. 9152.N
DATE 3/9/201
SHEET NO.