PREPARED FOR
LAKE GENEVA AREA
REALTY


ORDERED BY
LINDA DYER

PLAT OF SURVEY

- OF -

LOTS 2, 3 AND 4 IN FREEMAN'S SECOND ADDITION TO VILLAGE OF GENOA-BLOOMFIELD IN THE SOUTHEAST 1/4 OF SECTION 35, TOWNSHIP 1 NORTH, RANGE 18 EAST, IN THE VILLAGE OF GENOA CITY, WALWORTH COUNTY, WISCONSIN.

PATHFINDER SURVEYING
(a NMB Company)
P.O BOX 322
LAKE GENEVA, WI. 53147
WWW.PATHFINDERSURVEYING.NET
262-248-8303

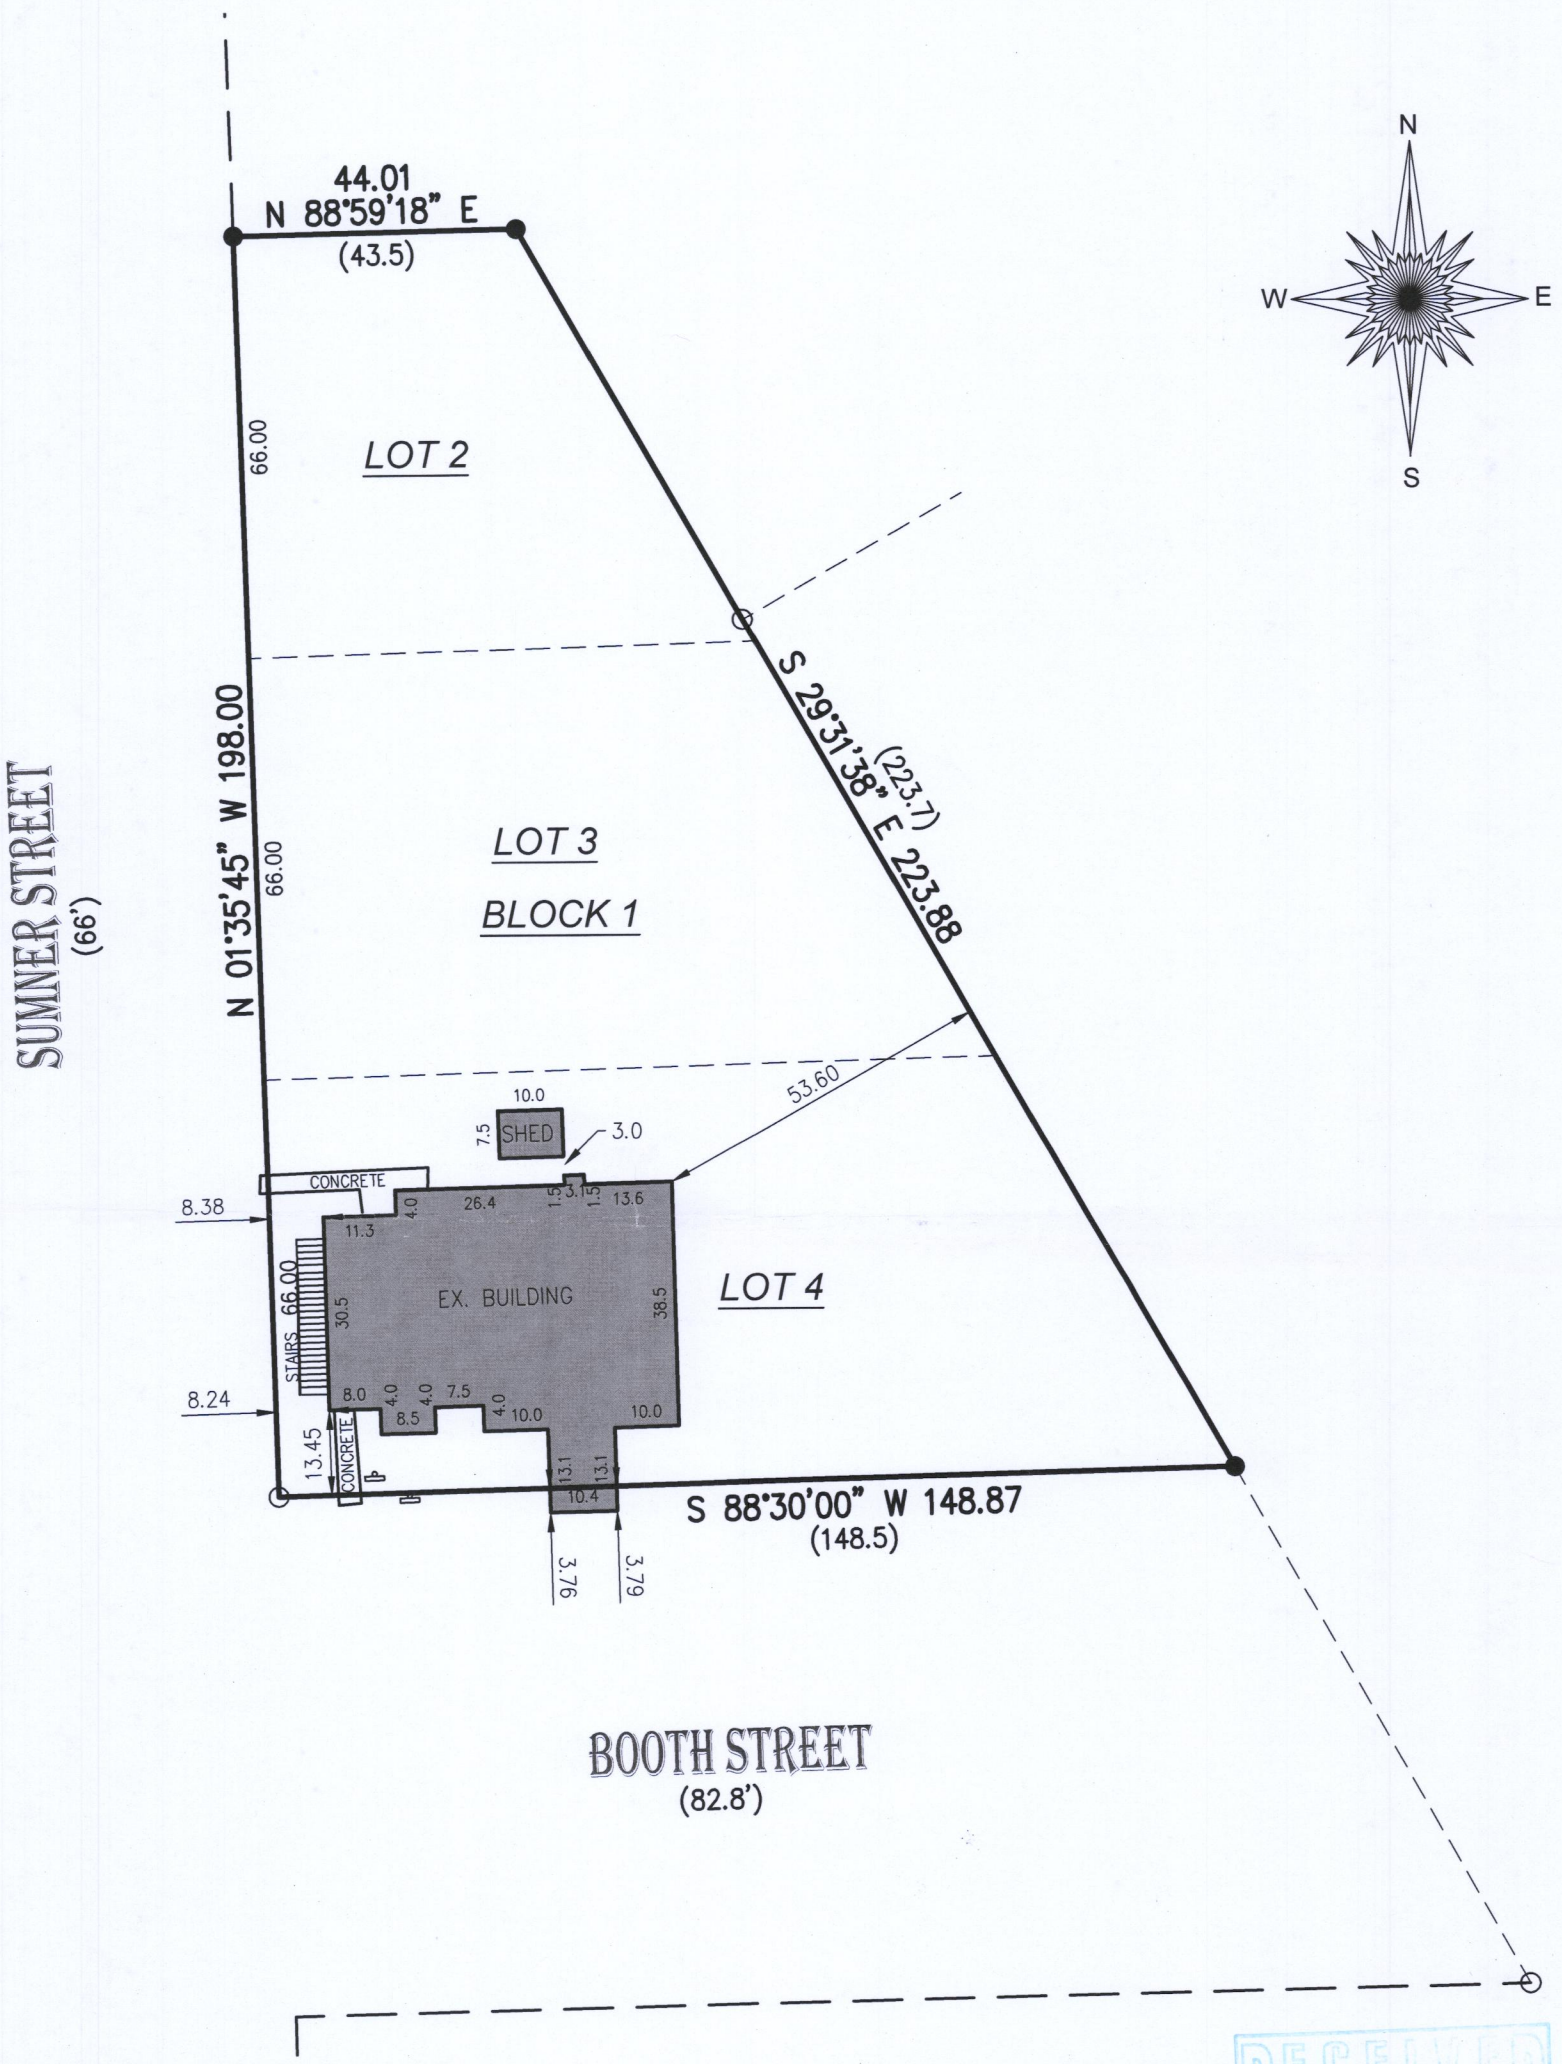

( ) = recorded as
= electric pedestal
= found iron pipe
= pad mount transformer
= communication box
= hydrant
= set 5/8" rebar

SCALE 1" = 30'

JOB # 2017.0209.01

TAX ID # TFR2 00001

BASIS OF BEARING OF THIS PLAT: THE US STATE PLANE COORDINATE SYSTEM SOUTH ZONE, NAD 83. WISCORS.

I hereby certify that I have surveyed the above- described property and the above map is a is a true representation thereof and shows the size and location of the property, its exterior boundaries, the location and dimensions of all structures thereon, fences, apparent easements and roadways and visible encroachments if any.

This survey is made for the present owners of the property, and those who purchase, mortgage, or guarantee the title thereto, within one year from the date hereof.

DATED THIS 17TH DAY OF OCTOBER, 2017.

RECEIVED
APR 11 2018
By Jan

WISCONSIN
MARK R. MADSEN
S-2271
RACINE, WI
LAND SURVEYOR

MARK R. MADSEN S - 2271
Wisconsin Professional Land Surveyor

TFR2-1 006-1351