



PLAT OF SURVEY
FOR THE GODFREY LAW FIRM
OF LAND LOCATED IN THE SW 1/4 OF SEC. 35, T1N, R18E
WALWORTH COUNTY, WIS.

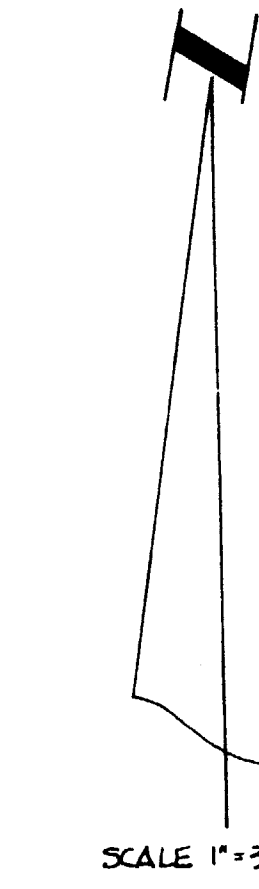


SCALE 1"=30'

LEGEND -
O - IRON PIPE FOUND
• - IRON ROD FOUND
X - P.K. NAIL FOUND

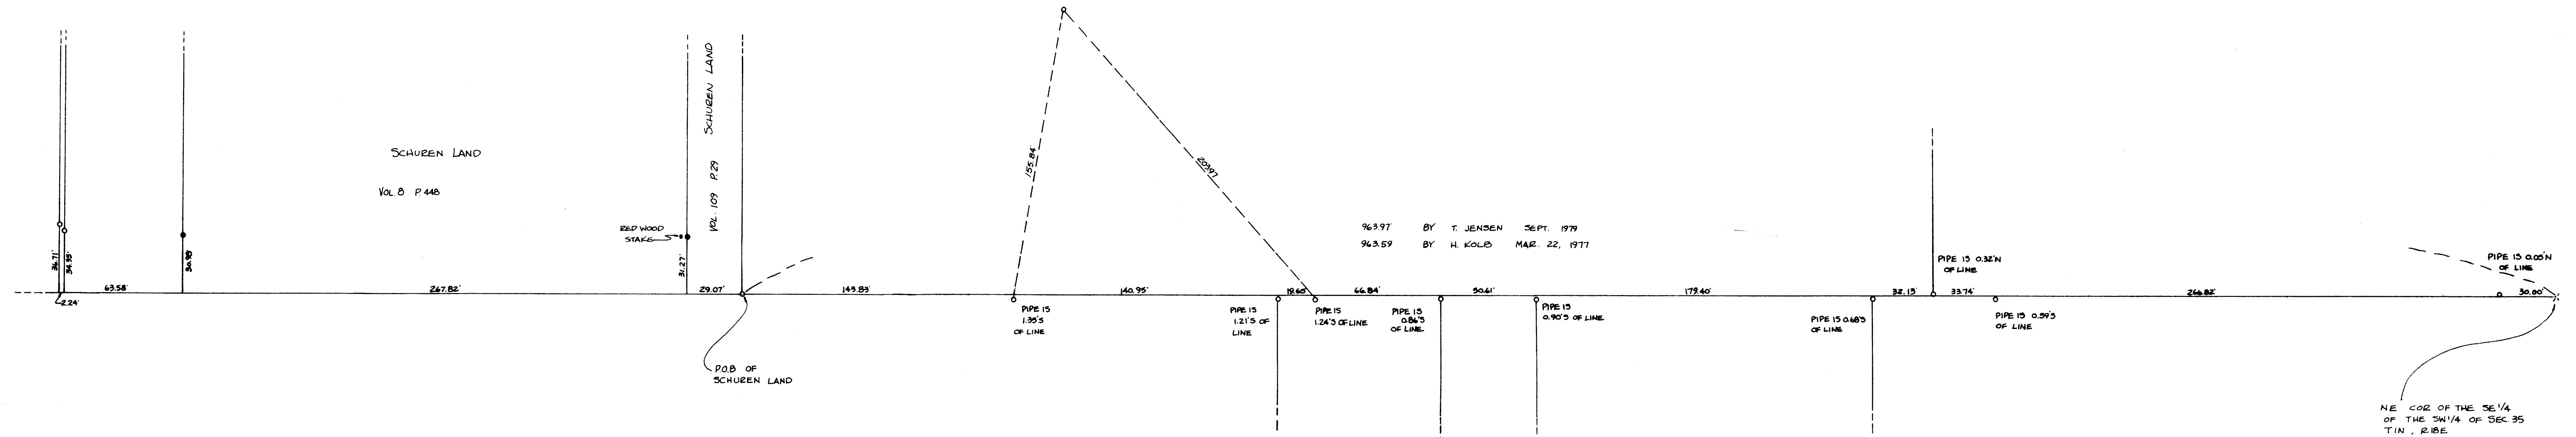

I HEREBY CERTIFY THAT I HAVE SURVEYED THE ABOVE
DESCRIBED LINES AND THAT THE PLAT SHOWN HEREON IS AN
ACCURATE SURVEY AND A TRUE REPRESENTATION THERE OF
AND CORRECTLY SHOWS THE BOUNDARY LINES AS MONUMENTED
OF SAID PROPERTY

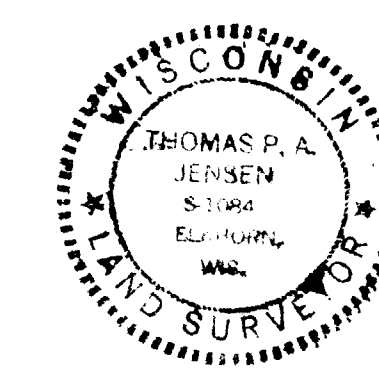

Thomas P. Jensen
T.P.A. JENSEN S-1084
WISCONSIN REGISTERED LAND SURVEYOR
JENSEN SURVEYING & MAPPING
ELKHORN, WIS.