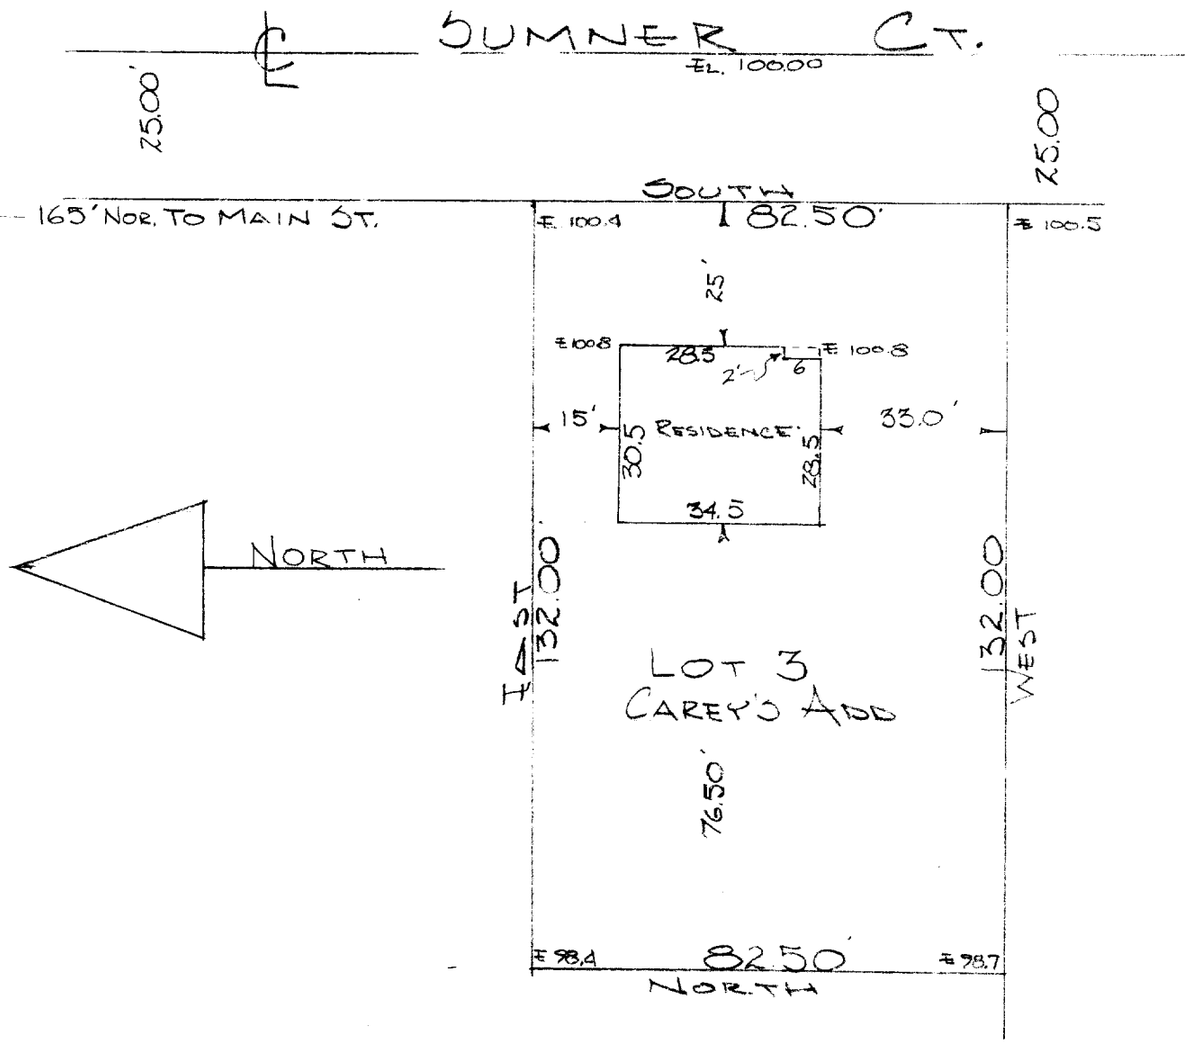

DESCRIPTION: Lot #3 of Carey's Addition to Genoa Junction, now the Village of Genoa City, Walworth County, Wisconsin.

CERTIFICATE: I, James F. Biagi, surveyor, do hereby certify that I have surveyed the property hereon described and that the Location of all the improvements are as shown on the drawing above.

January 17, 1962.

James F. Biagi

James F. Biagi, RLS 272.

TC-3

6-13B