
67-72

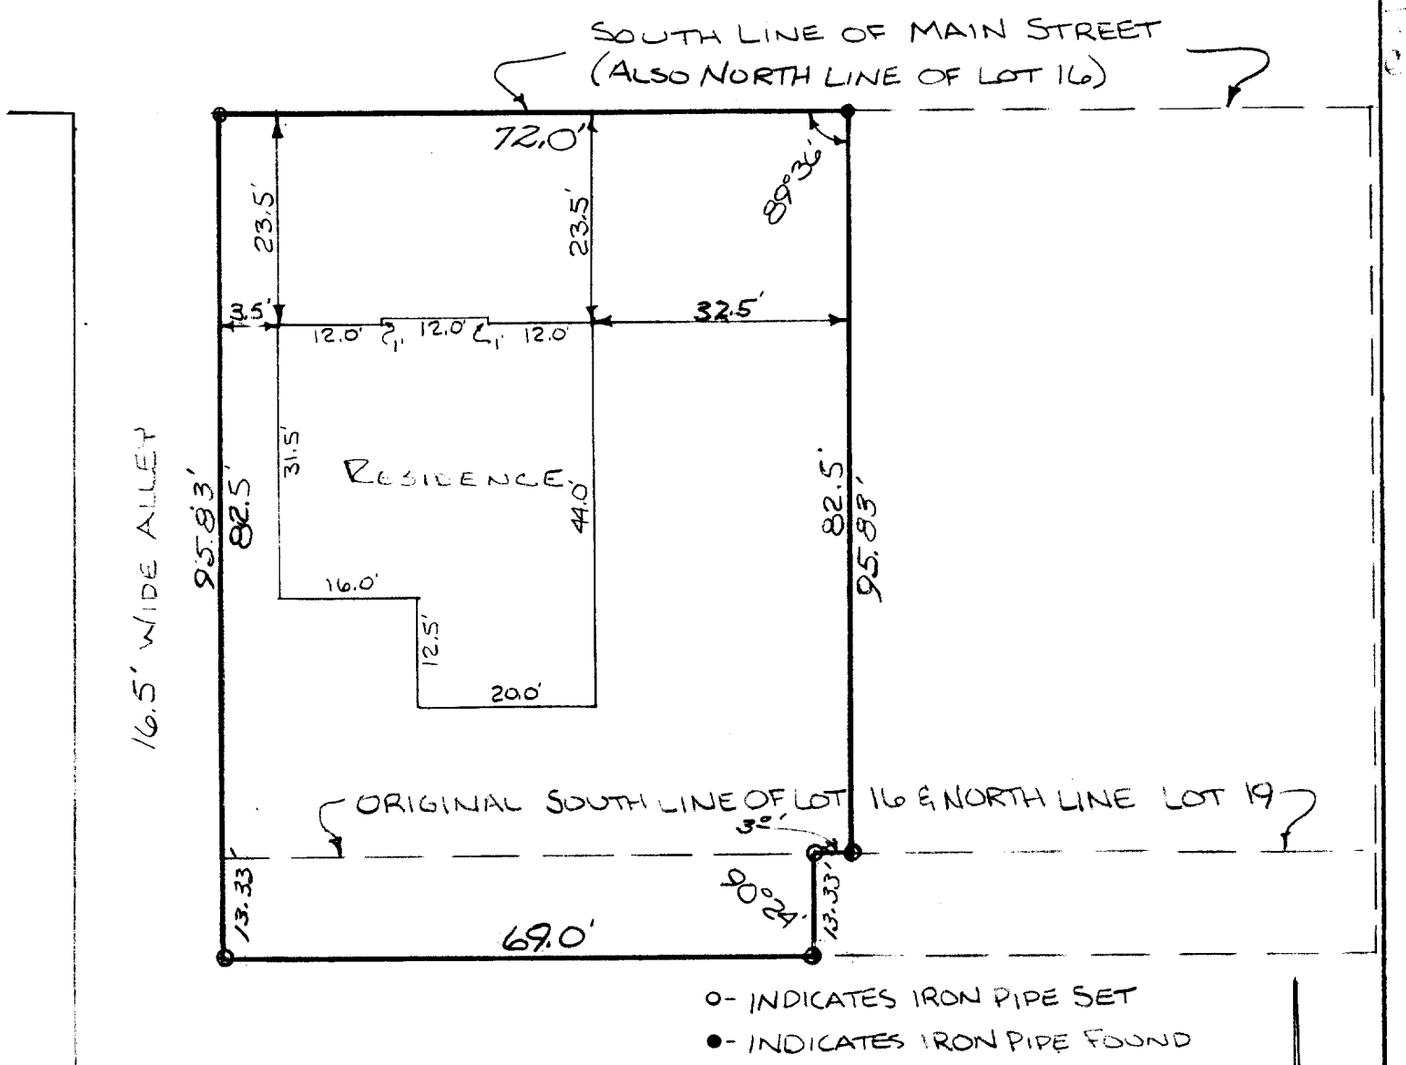

DESCRIPTION:
A parcel of land located in the Village of Genoa City, Walworth County, Wisconsin described as follows to-wit; The West 72.0 feet of lot 16, and the North 13.33feet of the West 69.0 feet of lot 19, located in the Original Plat of the Village of Genoa City, Walworth County, Wisconsin.

CERTIFICATE:
I, James F. Biagi, surveyor, do hereby certify that I have surveyed the property hereon described.

DATE:
June 9, 1972

James F. Biagi R.L.S. 272

WISCONSIN JAMES F. BIAGI MILWAUKEE, WIS. REGISTERED SURVEYOR

Re-sert
October 12th 1972.

Top-2

6-14B