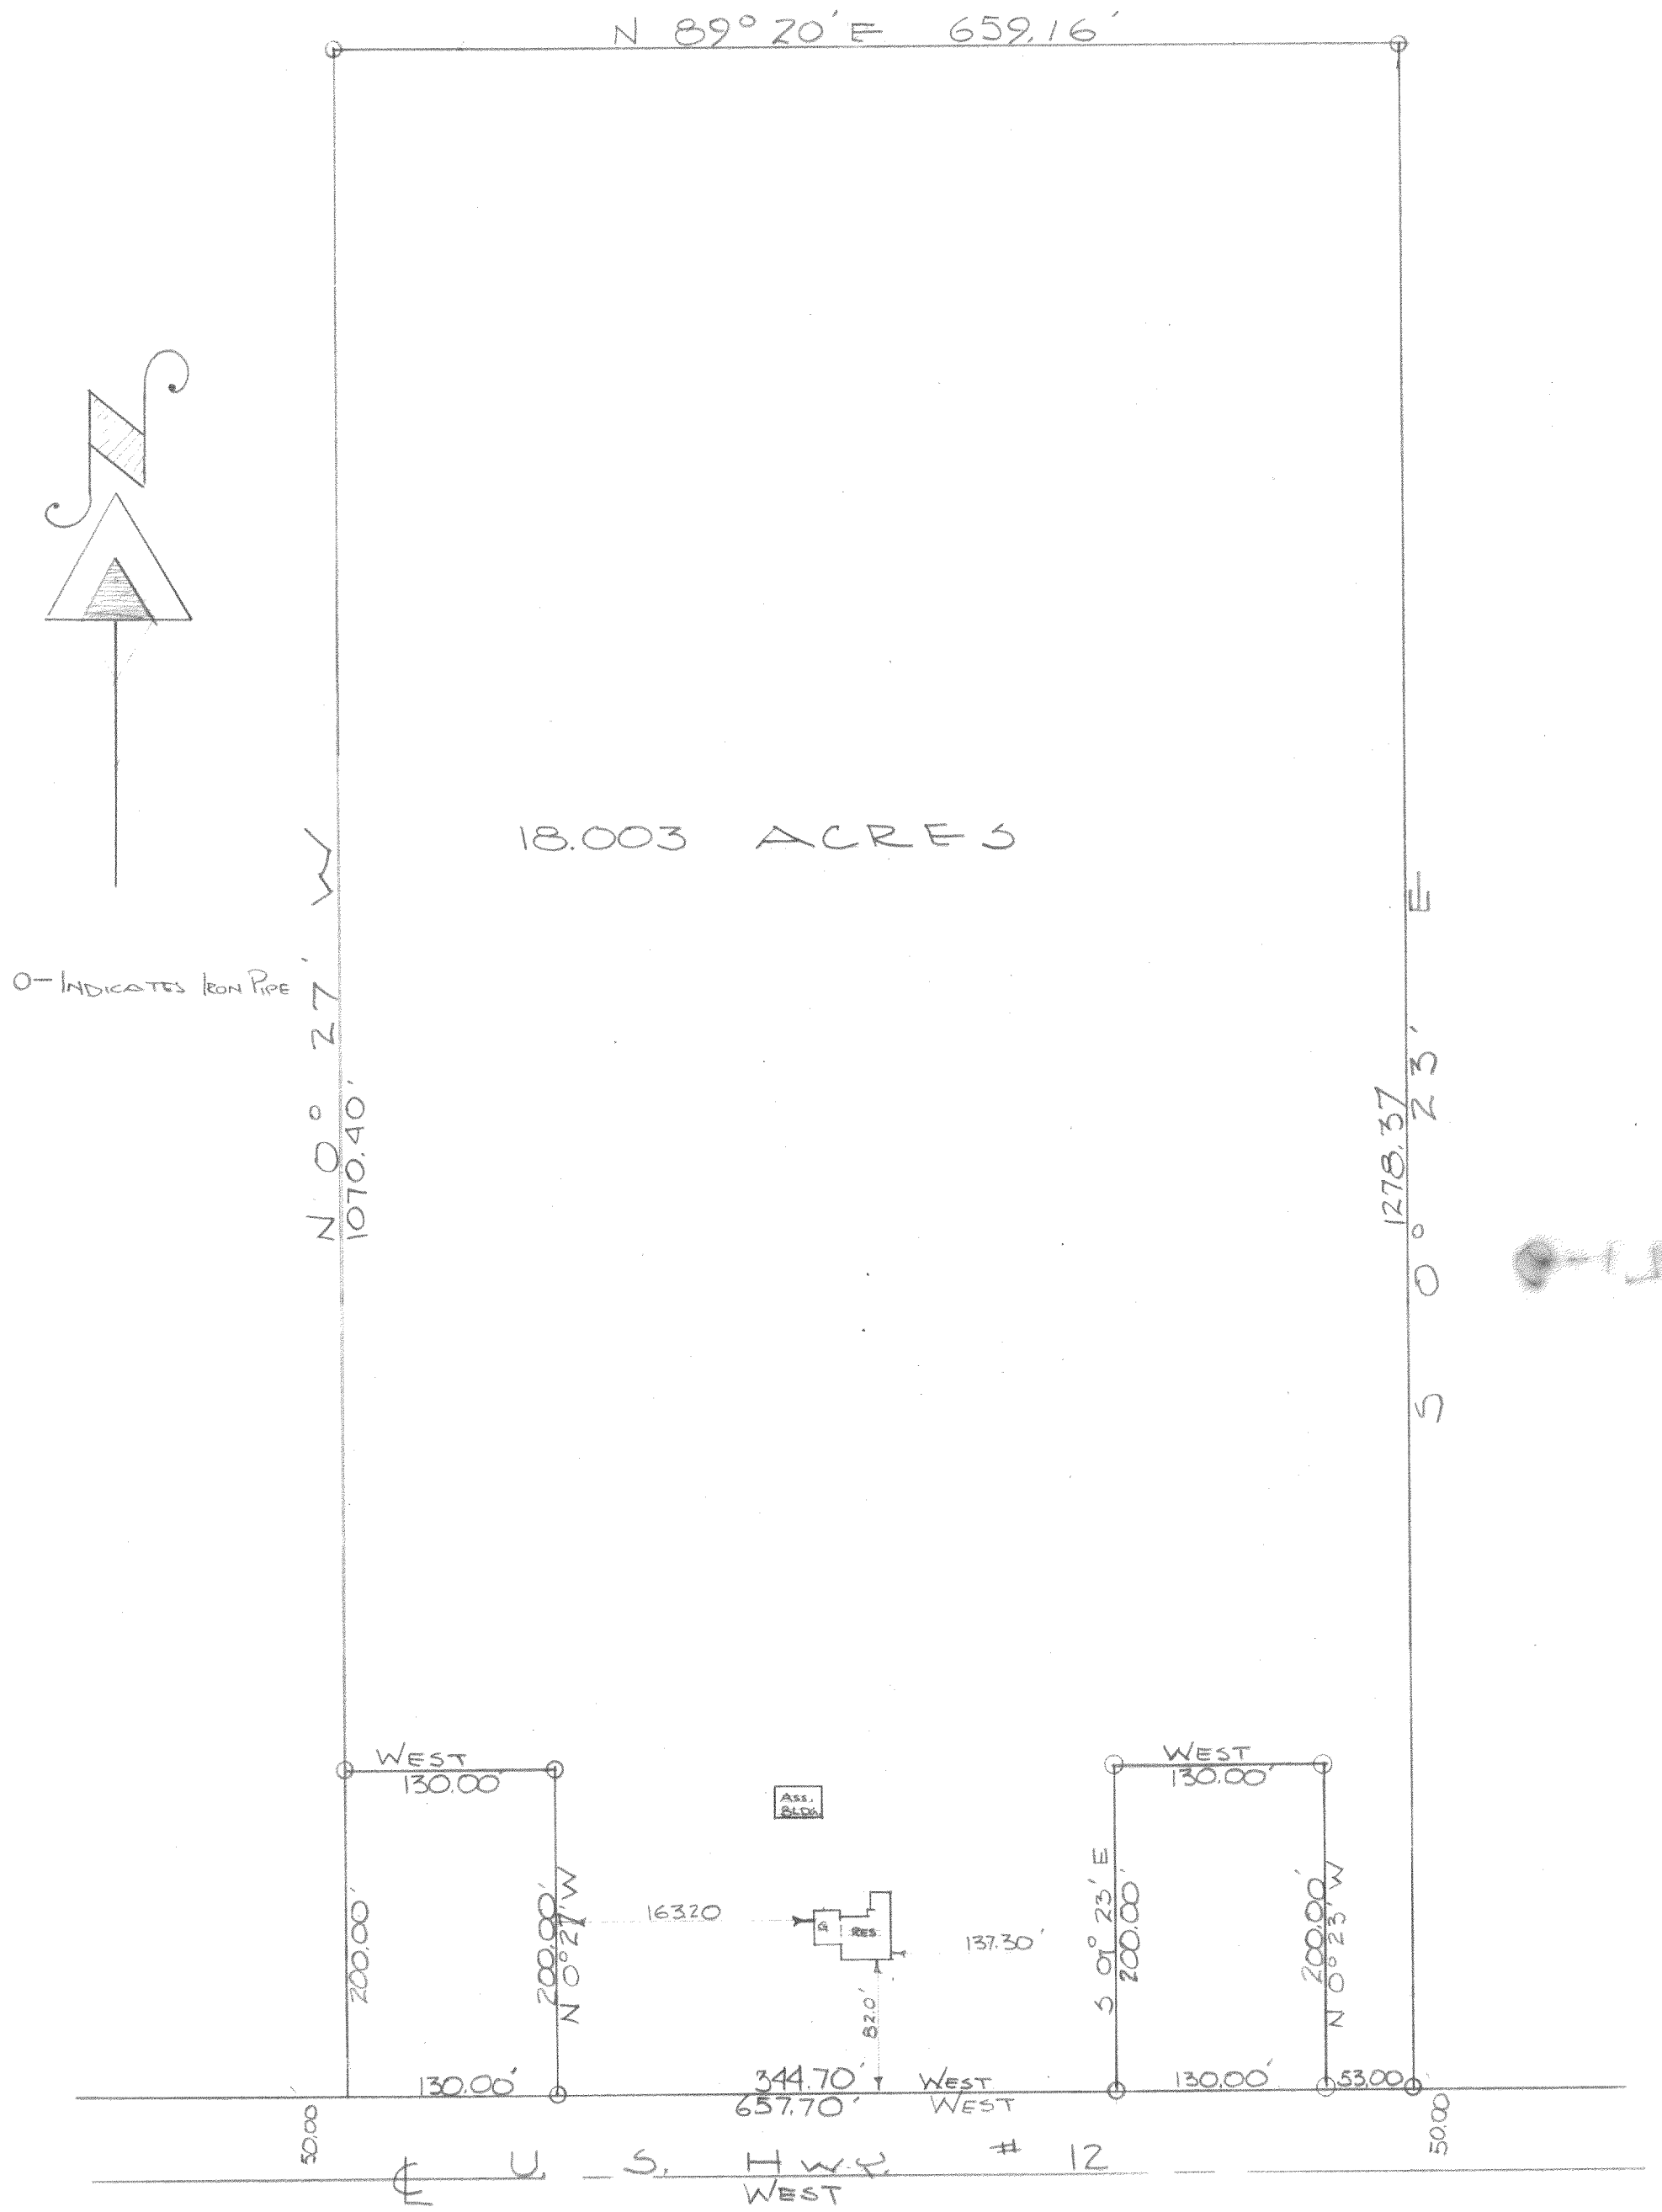

DESCRIPTION: The E.½ of the N.W.¼ of the S.W.¼ of Section 36, T. 1 N., R. 18 E. in Walworth County, Wisconsin, excepting therefrom that part lying within the premises described as beginning at a point on the N. line of U.S. Highway 12, 53.00 feet W. of the E. line of said E.½; thence N. parallel to said E. line 200.00 feet to a point, thence W. parallel to the N. line of said highway 12, 130.00 feet to a point, thence S. parallel to said E. line 200.00 feet to a point, thence E. 130.00 feet to the place of beginning. Also excepting therefrom that part lying within the premises described as beginning at the intersection of the N. line of Highway 12 and the W. line of said E.½, thence N. along the W. line 200.00 feet to a point, thence E. parallel to the N. line of said highway 12, 130.00 feet to a point, thence S. parallel to the W. line of said E.½ 200.00 feet to a point, thence W. 130.00 feet to the place of beginning.

CERTIFICATE: I, James F. Biagi, surveyor, do hereby certify that I have surveyed the property hereon described and that the location of all the improvements are as shown on the drawing above.

July 31, 1961.

James F. Biagi RLS 272

VGC-87, 87A + 87B

WISCONSIN JAMES F. BIAGI MILWAUKEE, WIS. LAND SURVEYOR

6-17B