
RECEIVED
OCT 14 1986

PLAT OF SURVEY
OF

DESC. — LOT 6 BLK 5 GIFFORD ADD. TO GENOA CITY, WAL. CO. WI
ALSO BEGIN AT SW CORNER SAID LOT 6 THENCE
WEST 20.5 FEET, THENCE NORTH 66 FEET; THENCE
EAST 20.5 FEET TO THE NW CORNER OF SAID LOT 6;
THENCE SOUTH TO BEGINNING.

SURVEYED FOR:
REALTY WORLD
P.O. BOX 727
TWIN LAKES, WIS.
53181

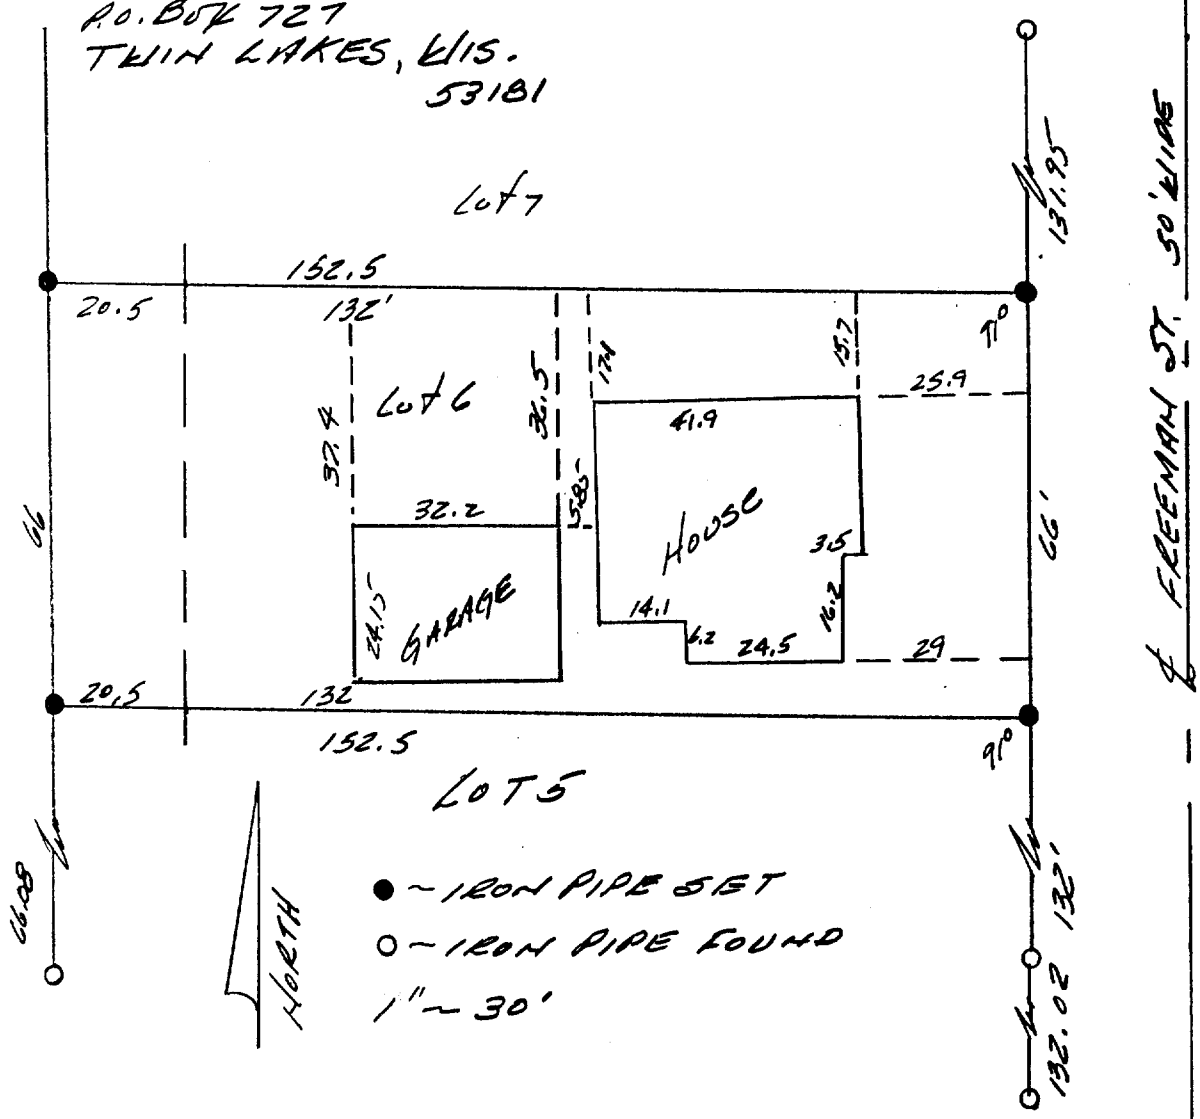

I, Thomas P.A. Jensen, Wisconsin Registered Land Surveyor, do hereby certify that this survey was performed by me, or under my direction, in full compliance with the owner's/agent's instructions and chapter A-E 5 of the Wisconsin Administrative Code "Minimum Standards For Property Surveys"; and that this map is an accurate representation thereof to the best of my knowledge and belief.

WISCONSIN
THOMAS P. A.
JENSEN
S-1084
ELKHORN,
WIS.
LAND SURVEYOR

Thomas P.A. Jensen S-1084
Jensen Surveying & Mapping S.C.
45 S. Wisconsin St.
Elkhorn, Wisconsin. 53121
(414) 723-3434

1986.037X
6-193