
#13 - 66

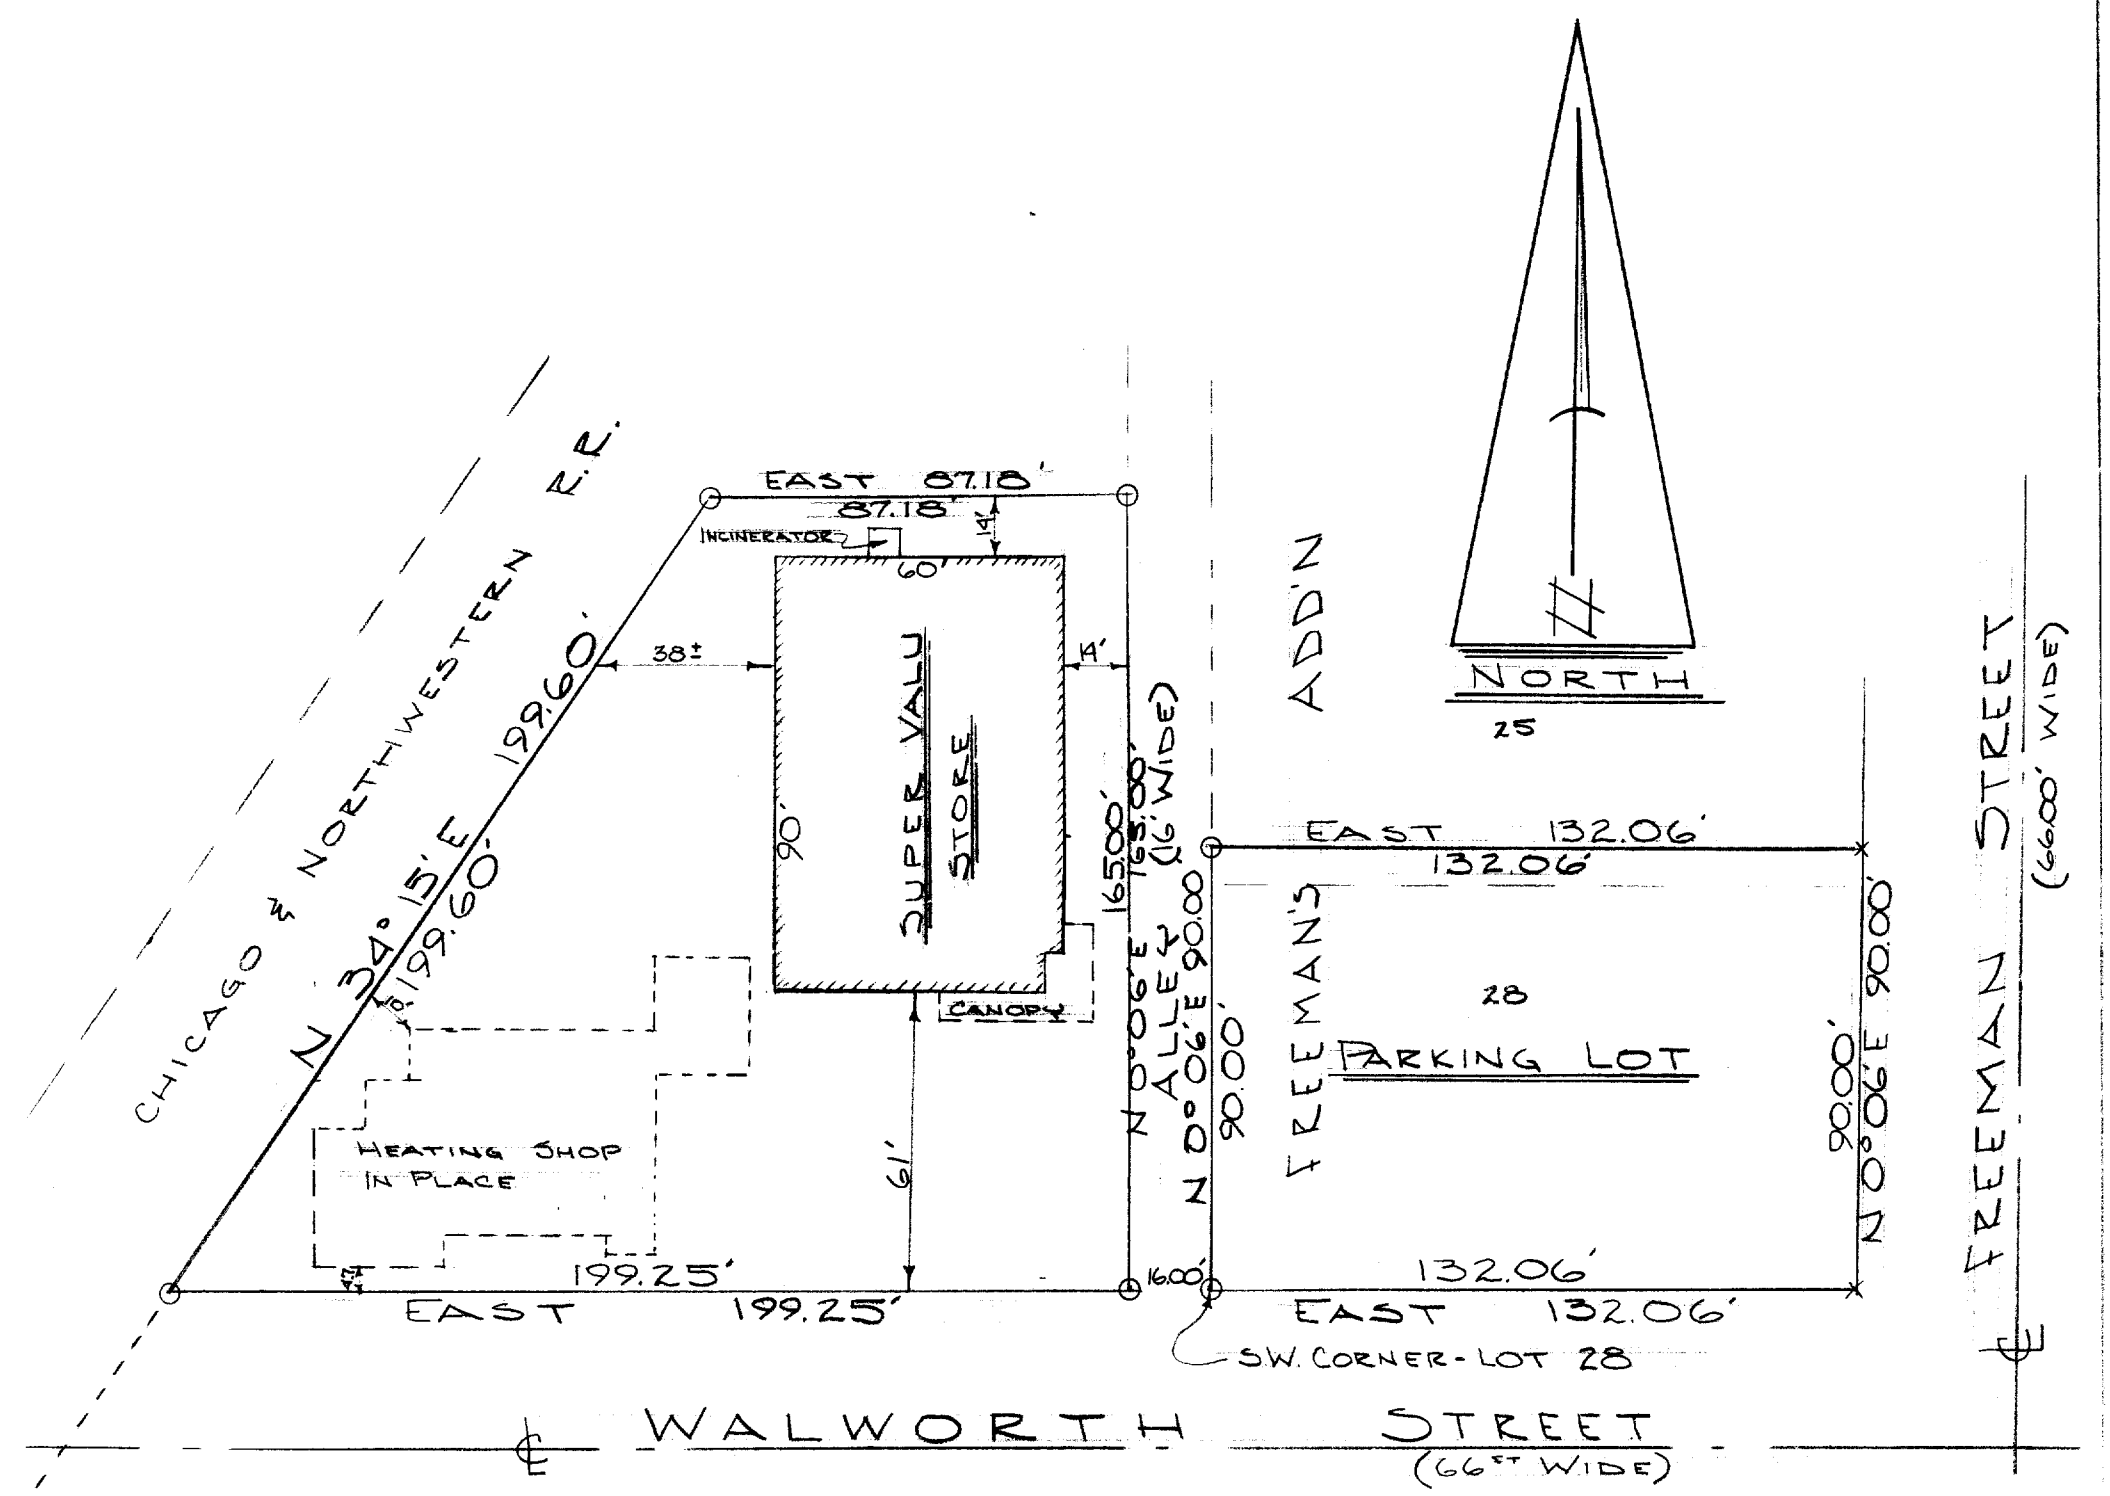

DESCRIPTION:

Lot 28 and part of Lot 25, Freemans Addition to the Village of Genoa City, Walworth County, Wisconsin and described as follows, to wit: Beginning at the Southwest corner of said Lot 28, thence N. 00° 06' E. 90.00 feet; thence East 132.06 feet; thence S. 00° 06' W. 90.00 feet; thence West 132.06 feet to the place of beginning.

Also a parcel of land in the Northwest $\frac{1}{4}$ of the Southeast $\frac{1}{4}$ of Section 35, T. 1 N., R. 18 E. in the Village of Genoa City, Walworth County, Wisconsin and described as follows, to wit: Commencing at the Southwest corner of said Lot 28; thence West 16.00 feet to the place of beginning; thence continue West 199.25 feet; thence N. 34° 15' E. 199.60 feet; thence East 87.18 feet; thence S. 00° 06' W. 165.00 feet to the place of beginning.

CERTIFICATE:

I, James F. Biagi, surveyor, do hereby certify that the location of the improvements on the above described lands are as shown and wholly within the boundaries of this survey.

January 29, 1966

James F. Biagi

James F. Biagi, R.L.S. 272

Engineers Associated, Inc.
Elkhorn, Wisconsin

WISCONSIN JAMES F. BIAGI MILWAUKEE CO. LAND SURVEYOR

JFB-21 32, 39 TUG-47 47A