
WALWORTH STREET 66' WIDE

MILL STREET 66' WIDE

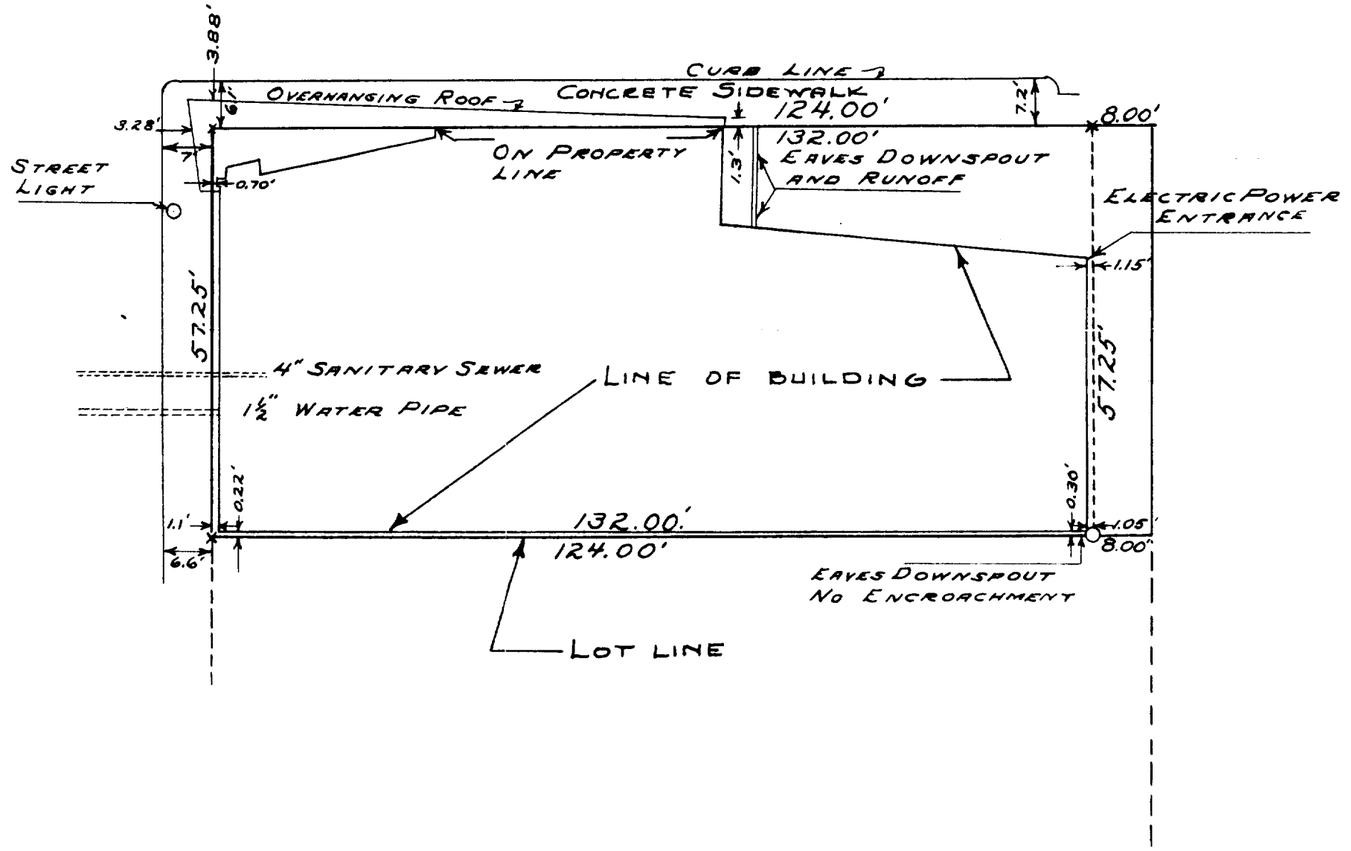

N

SCALE – 1" = 20'
X = CROSS IN CONCRETE
O = IRON PIPE

I HEREBY CERTIFY:

(1) THAT I HAVE SURVEYED THE FOLLOWING DESCRIBED PROPERTY: THE NORTH 57 FEET AND 3 INCHES OF LOT 1 OF THE ORIGINAL PLAT OF THE VILLAGE OF GENOA JUNCTION BEING PART OF THE WEST ½ OF THE SOUTH EAST ¼ OF SECTION 35 TOWNSHIP 1 NORTH OF RANGE 18 EAST, WALWORTH COUNTY, WISCONSIN.

(2) THAT I HAVE LOCATED ALL IMPROVEMENTS AND SHOWN ALL ENCROACHMENTS ON ADJOINING PROPERTY.

(3) THAT THE ABOVE PLAT IS A CORRECT REPRESENTATION OF SAID SURVEY.

FEBRUARY 1, 1950

Floyd L. Jensen
SURVEYOR

OP-1

6-5 J