
N

SCALE~1"=20'
O· IRON PIPE
X CROSS IN CONC

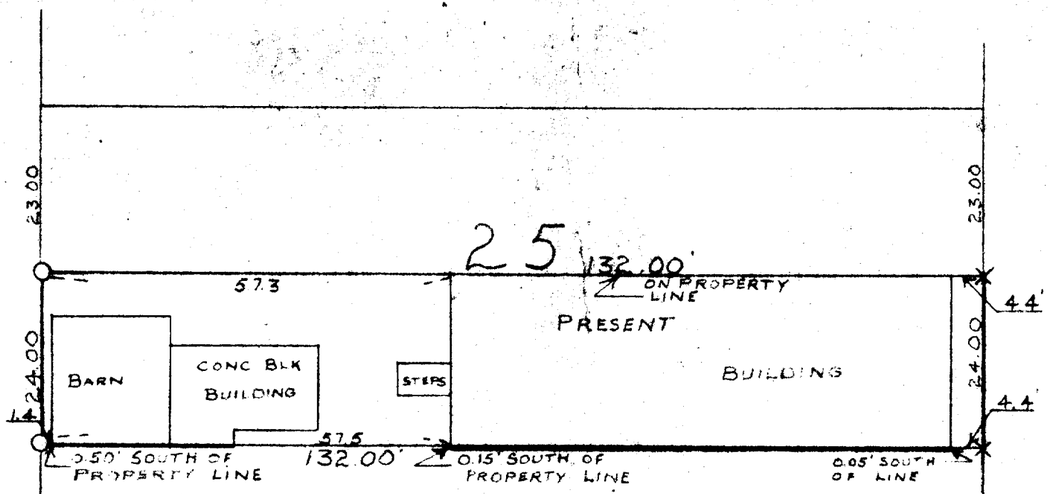

PLAT OF SURVEY OF PART OF LOT 25 FREEMANS ADDITION TO THE VILLAGE OF GENOA CITY WALWORTH COUNTY WISCONSIN
MARCH 3 1951

H.E. Johnson

TFR-23

6-8J