61-41

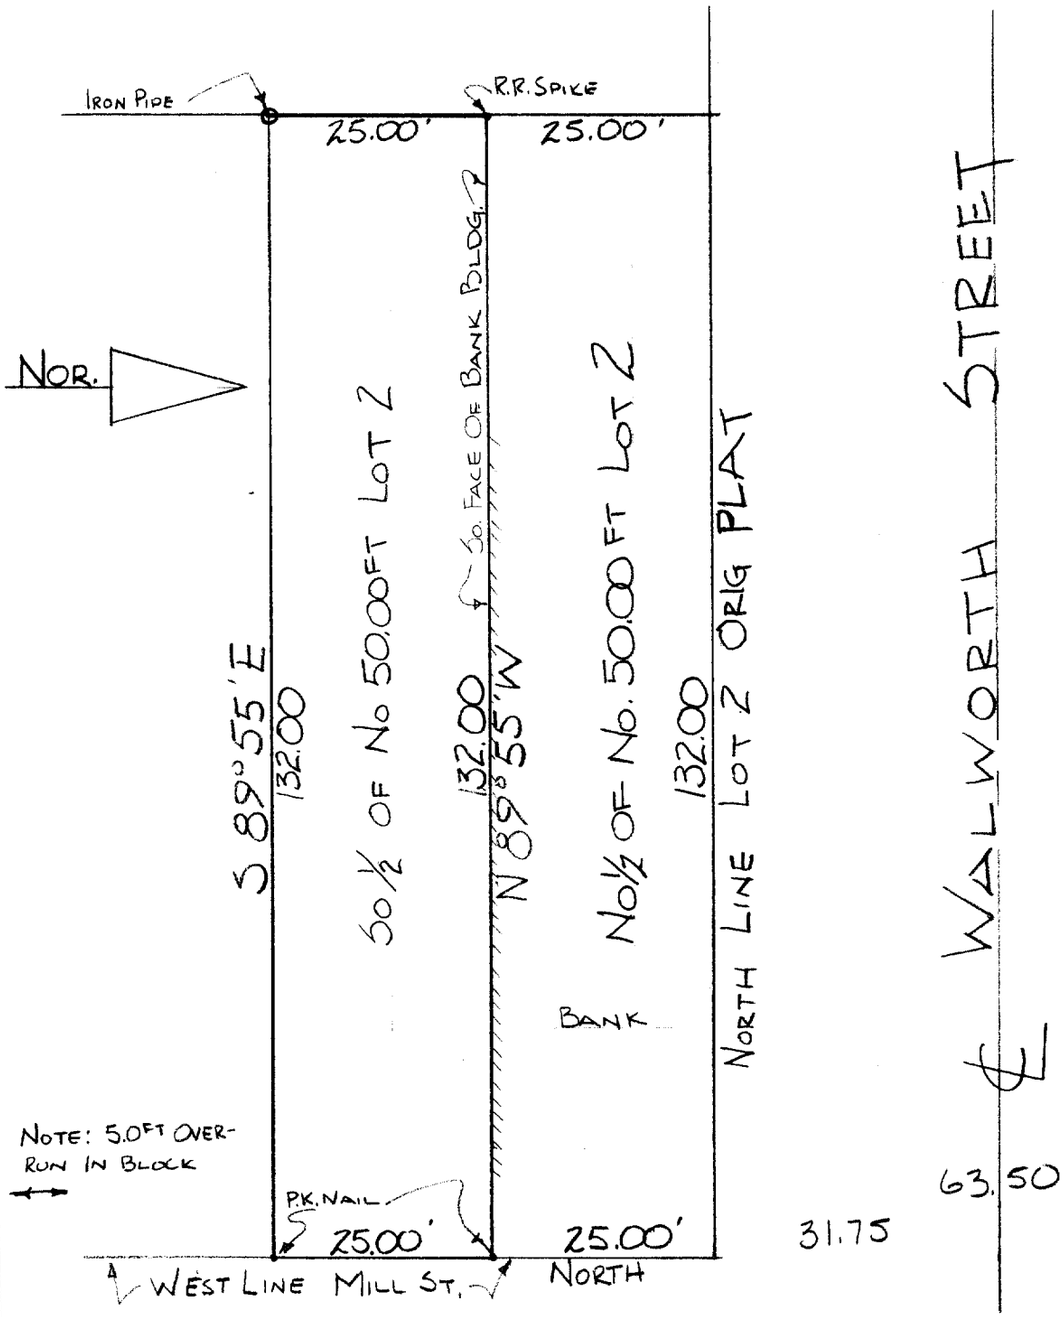

DESCRIPTION: The South 25.00 feet of the North 50.00 feet of Lot 2 of the Original Plat of the Village of Genoa City, Walworth County, Wisconsin.

CERTIFICATE: I, James F. Biagi, surveyor do hereby certify that I have surveyed the property hereon described and that the drawing shown above is a correct representation [illegible]

APRIL 21, 1961.

[illegible]

WISCONSIN MILWAUKEE WIS. LAND SURVEYOR

Top-