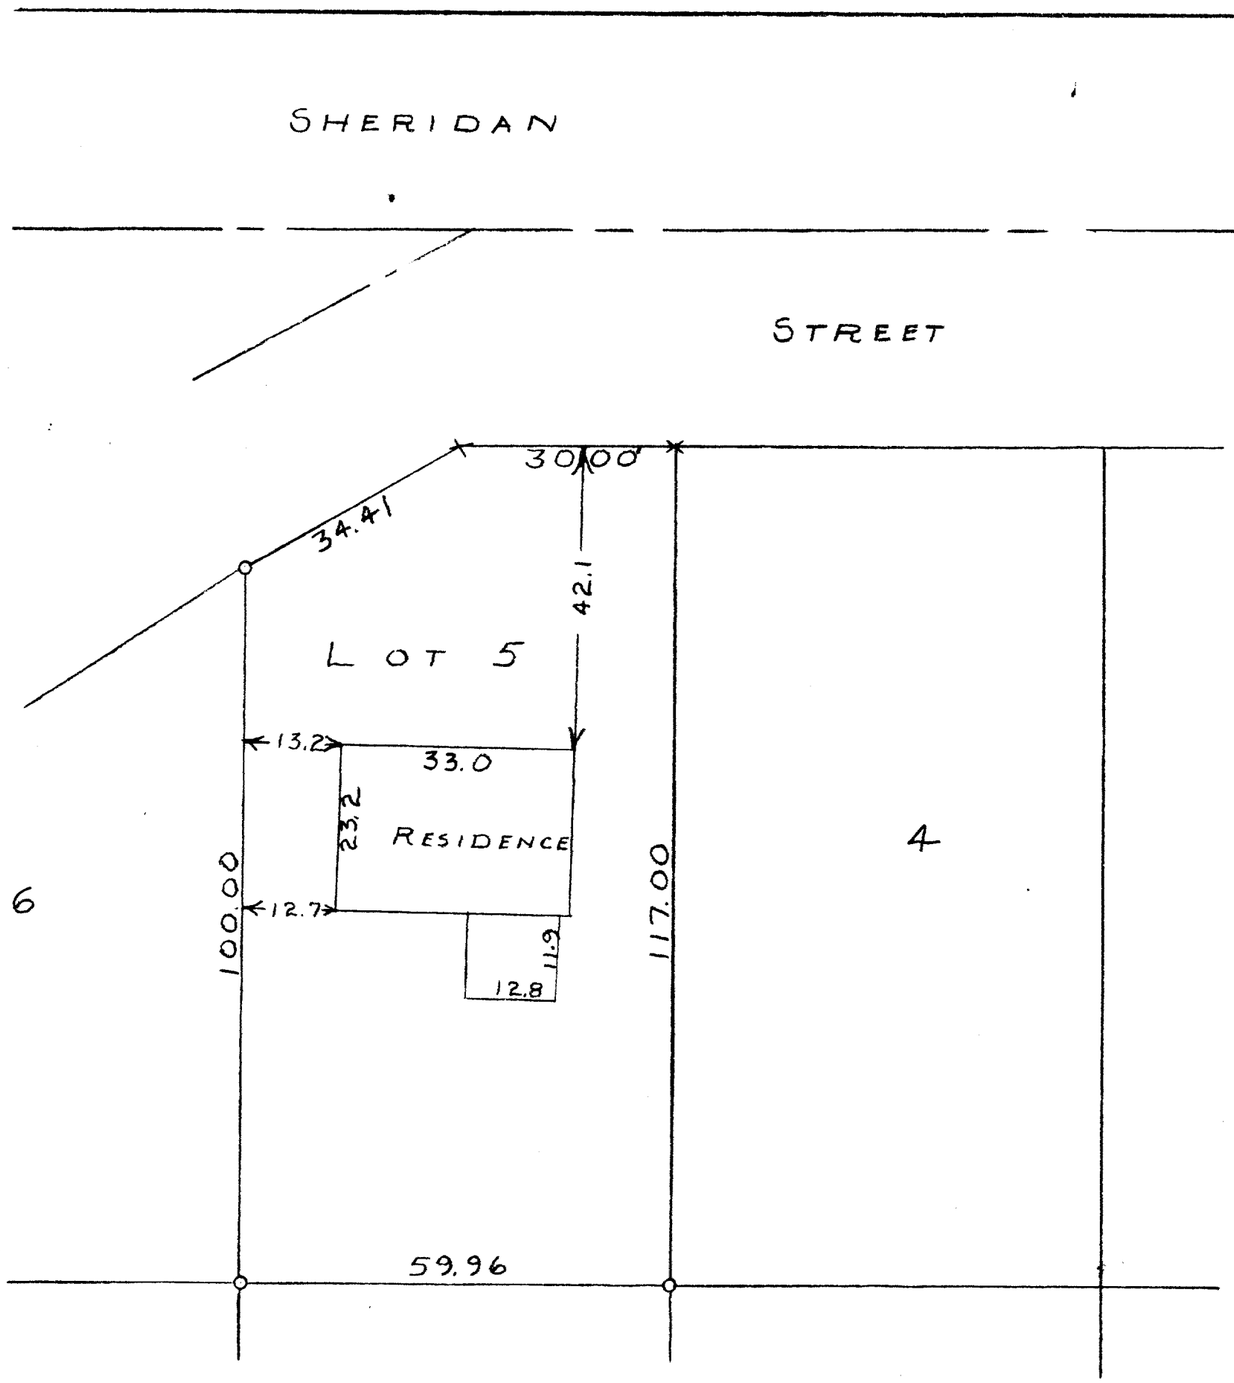


N

SCALE~1"=20'
O=IRON PIPE
X=CROSS IN CONC.

STATE OF WISCONSIN) SS
COUNTY OF WALWORTH)

I, GEORGE T. DUNHAM, DO HEREBY CERTIFY THAT I HAVE SURVEYED THE PROPERTY DESCRIBED AS FOLLOWS:

LOT 5, BLOCK 1 OF WARHURSTS SUBDIVISION LOCATED IN THE CITY OF LAKE GENEVA, WALWORTH COUNTY, WISCONSIN

AND THAT THE PLAT SHOWN ABOVE IS A CORRECT REPRESENTATION OF THE PROPERTY LINES

JANUARY 24, 1956

George T. Dunham

GEORGE T. DUNHAM, SURVEYOR
DELAVAN, WISCONSIN

7-10