
"A" - #32-63

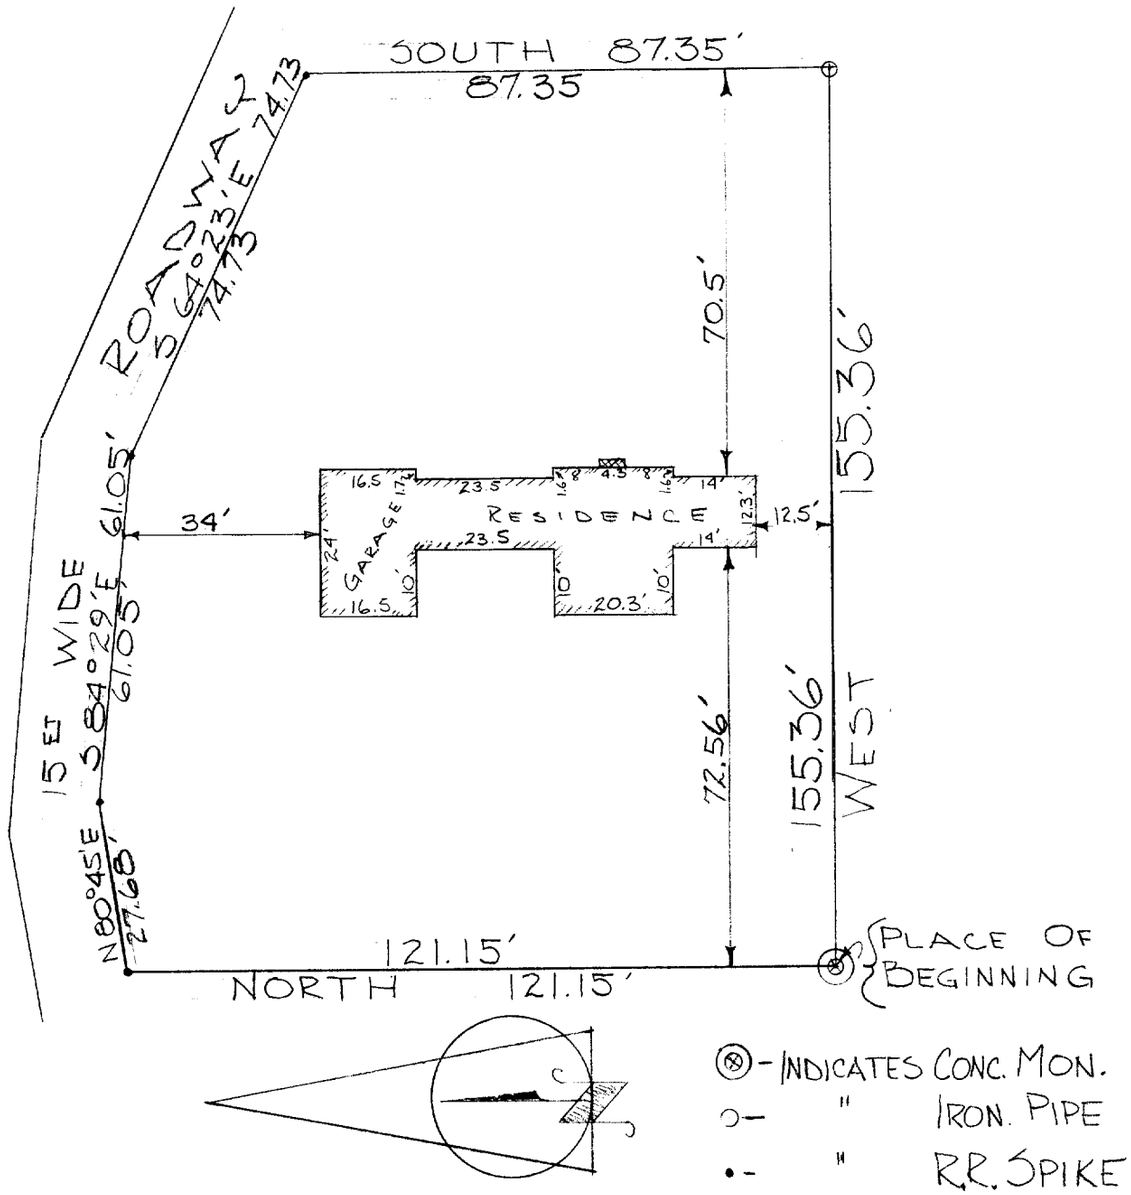

⊗ - INDICATES CONC. MON.
○ - " IRON. PIPE
• - " R.R. SPIKE

DESCRIPTION:

Commencing at a concrete monument that is 261.00 feet S. 89° 40' E., of the southwest corner of Lot 4, Lake Geneva Villa Park Subdivision, located in the N. ½ of Section 1, Town 1, north, Range 17 east, City of Lake Geneva, Walworth County, Wisconsin, thence North 121.15 feet, thence N. 80°45' E., 27.68 feet, thence S. 84°29' E., 61.05 feet, thence S. 64°23' E., 74.73 feet, thence South, 87.35 feet, thence West 155.36 feet to the place of beginning.

CERTIFICATE:

I, James F. Biagi, Surveyor, do hereby certify that I have surveyed the property hereon described and that the location of the improvements are as shown.

April 1st 1963.

Elkhorn, Wisconsin.

WISCONSIN JAMES F. BIAGI MILWAUKEE, WIS. REGISTERED LAND SURVEYOR

James F. Biagi. (RLS 7)

LP-1D

7-100B