
DESCRIPTION: Commencing at the southwest corner of Lot 4, Lake Geneva Villa Park Subdivision, located in the N. ½ of Section 1, Town 1, north, Range 17 east, City of Lake Geneva, Walworth County, Wisconsin, thence N. 36° 02' E., 137.75 feet, thence S. 81° 22' E., 67.46 feet thence N. 80° 45' E., 114.69 feet, thence South 121.15 feet, thence N. 89° 40' W., 261.00 feet to the place of beginning.

CERTIFICATE: I, James F. Biagi, Surveyor, do hereby certify that I have surveyed the property hereon described and that the location of said property is as described.

April 1st 1963
Elkhorn, Wisconsin.

James F. Biagi. (RLS 272)

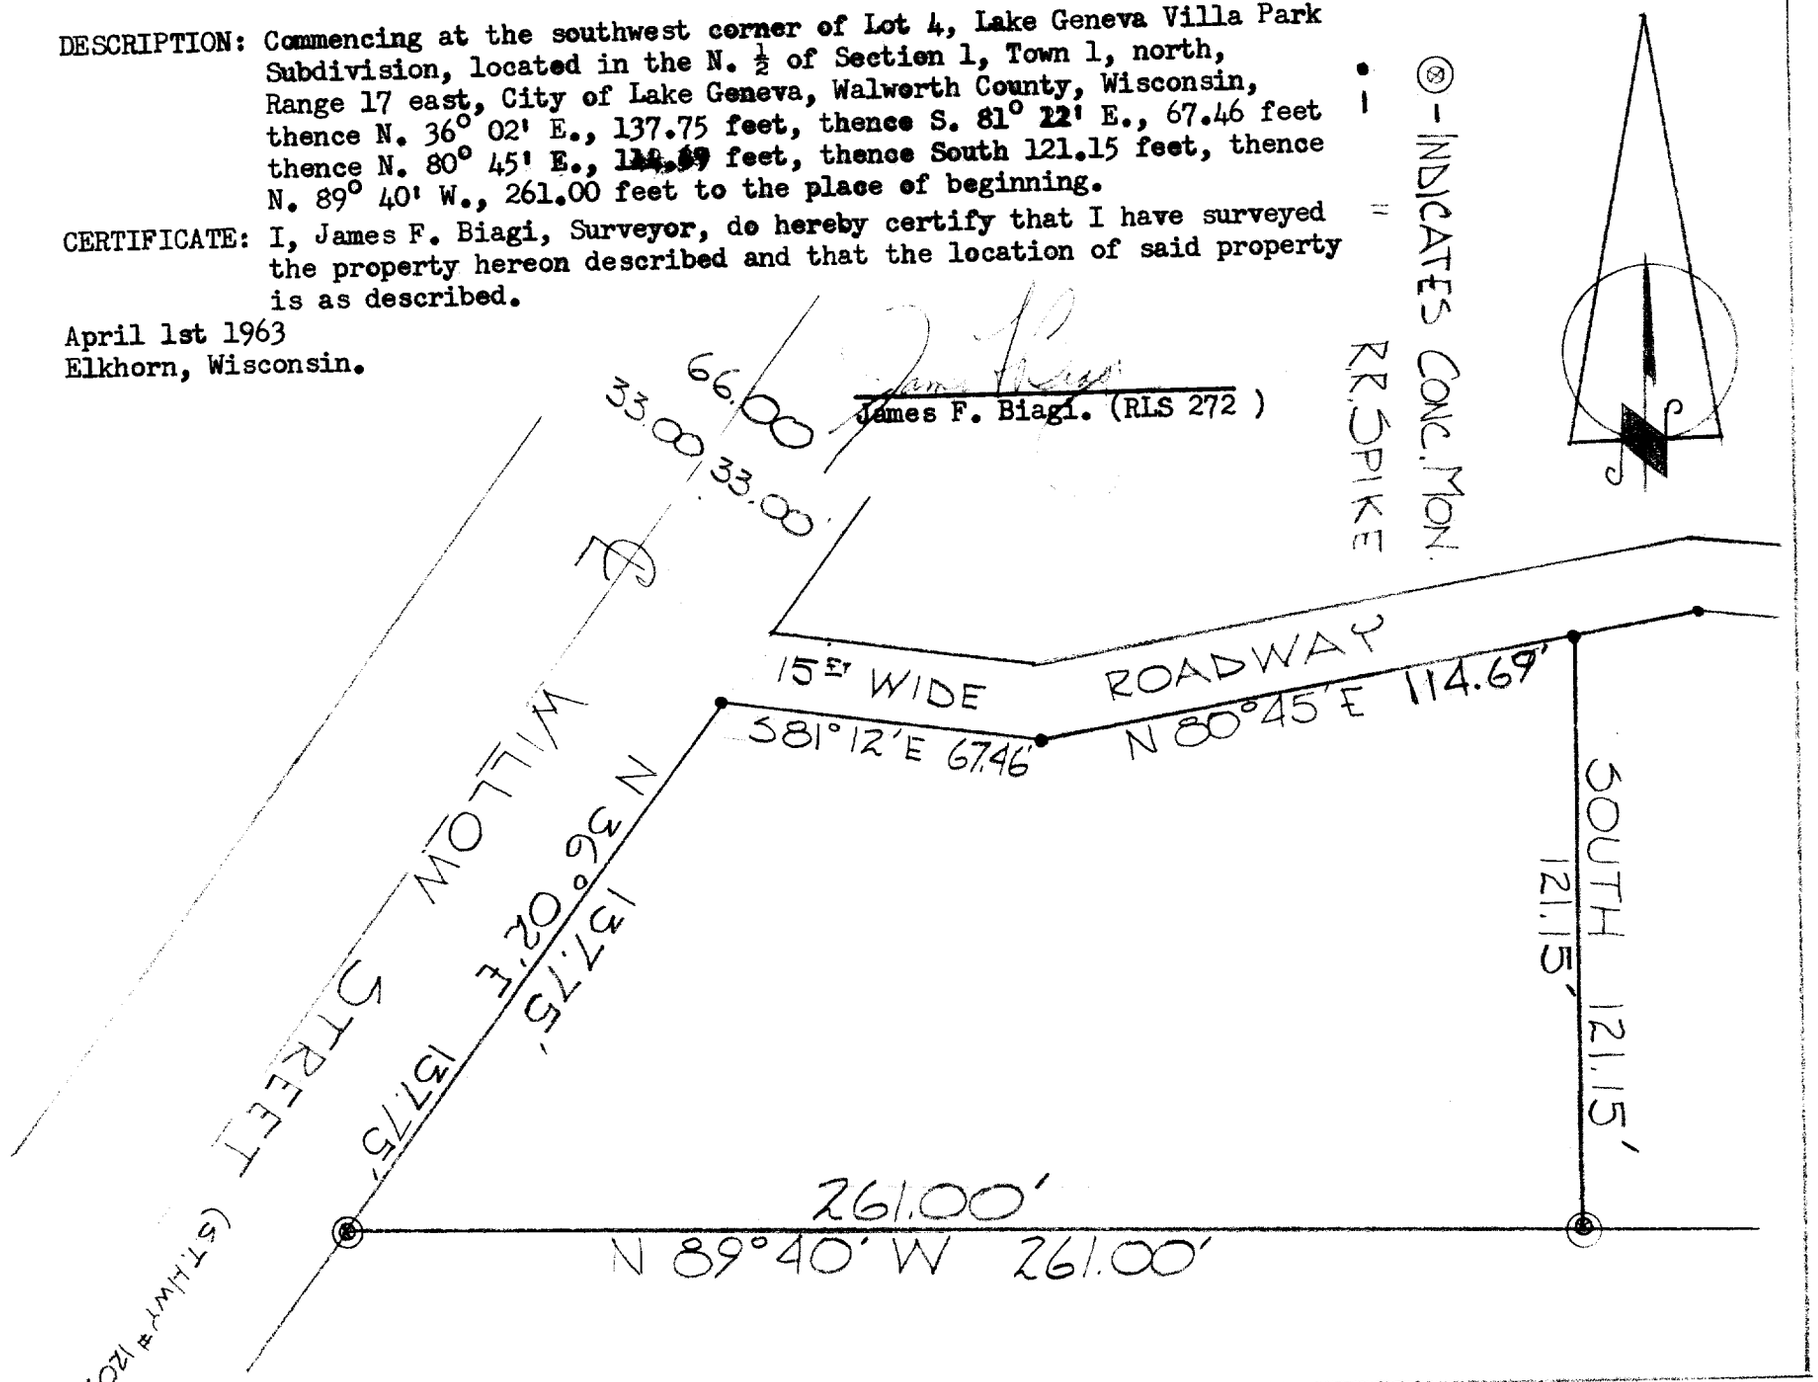

LP-1C

7 - 105 B

B - #32-63