
51-15

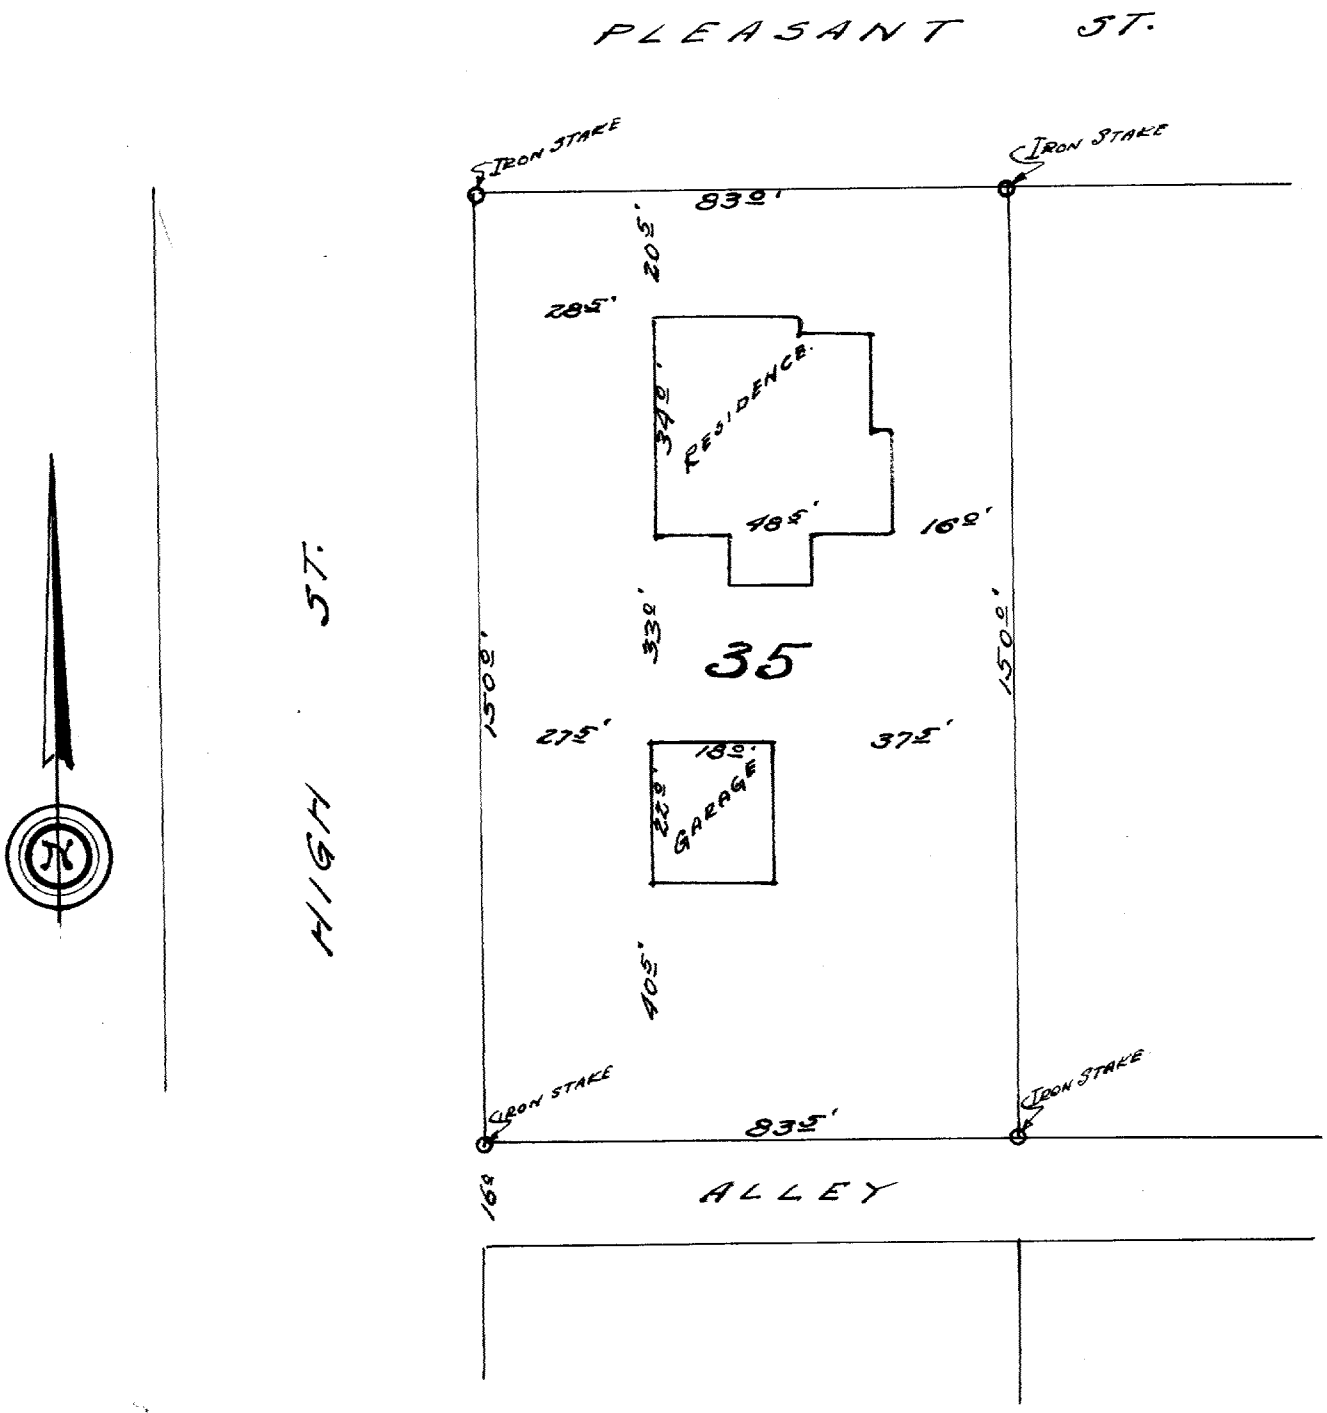

DESCRIPTION:

Lot 35 Columbian Subdivision of a portion of the City of Lake Geneva Walworth County, Wisconsin.

CERTIFICATE:

I, hereby certify that I, have on this the 12th day of July 1951, surveyed the above described property according to the official record on file in the office of the Recorder of Deeds in and for Walworth County Wisconsin, and find that the measurements and bearings of the boundary lines of said property as taken at the site on this day, substantially agree with those on said official plat and that no encroachments exist, and that the improvements on said property are in the relative locations as shown on the above portrayed plat.
SIGNED AND SEALED ON THIS THE 14TH DAY OF JULY 1951.

Joseph M. Biagi. Professional Engineer
Elkhorn Wisconsin.