
KOLB LAND CONSULTING, INC.

LAND SURVEYING · SUBDIVIDING · LAND PLANNING

LAKE GENEVA, WISCONSIN 53147 WHITEWATER, WISCONSIN 53190

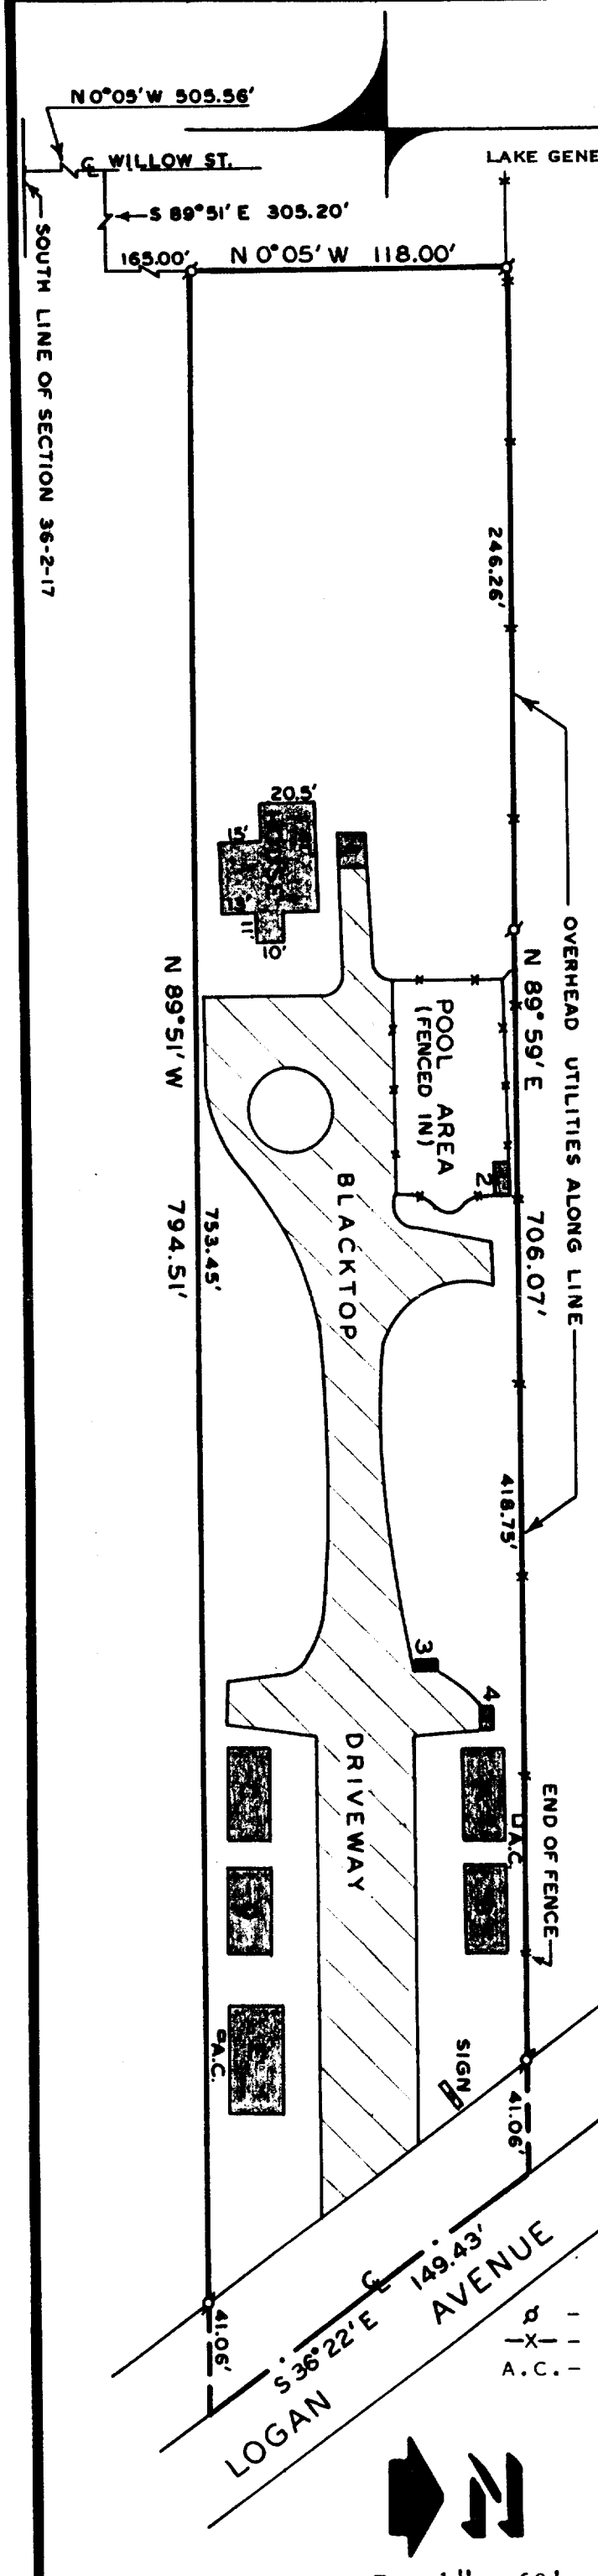

PLAT OF SURVEY OF

A PARCEL OF LAND LOCATED IN THE SOUTHEAST 1/4 OF SECTION 36, T 2 N, R 17 E, CITY OF LAKE GENEVA, WALWORTH COUNTY, WISCONSIN.

OWNERS: EUGENE E. & WINIFRED KRIWIEL
682 SOUTH WELLS STREET
LAKE GENEVA, WI 53147

NOTE: BUILDINGS A, B, C, & D ARE 16' X 33.4'

BUILDING E IS 20' X 40'

SHED 1 IS 9.9' X 13.2'

SHED 2 IS 5.3' X 12.2'

SHED 3 IS 4.2' X 8.3'

SHED 4 IS 8.2' X 12.2'

NOTE: BEARINGS ARE ASSUMED AS SHOWN ON RECORDED DEED.

RECEIVED
MAR 14 1989

LEGEND

- ø - IRON PIPE FOUND
- —X— - FENCE
- A.C.- AIR CONDITIONER

SCALE : 1" = 60'

I HEREBY CERTIFY THAT I HAVE SURVEYED THE ABOVE DESCRIBED PROPERTY AND THAT THE ABOVE MAP IS A TRUE REPRESENTATION THEREOF AND SHOWS THE SIZE AND LOCATION OF THE PROPERTY, ITS EXTERIOR BOUNDARIES, THE LOCATION OF ALL VISIBLE STRUCTURES AND DIMENSIONS OF ALL PRINCIPAL BUILDINGS THEREON, BOUNDARY FENCES, APPARENT EASEMENTS, ROADWAYS AND VISIBLE ENCROACHMENTS, IF ANY, TO THE BEST OF MY KNOWLEDGE AND BELIEF.
THIS SURVEY IS MADE FOR THE USE OF THE PRESENT OWNERS OF THE PROPERTY, AND ALSO THOSE WHO PURCHASE, MORTGAGE, OR GUARANTEE THE TITLE THERETO WITHIN ONE (1) YEAR FROM DATE HEREOF.
NOTE: SURVEY NOT VALID UNLESS SURVEYOR'S SIGNATURE IS IN RED.

HAROLD H. KOLB
WISCONSIN REGISTERED LAND SURVEYOR, S-187

DATE DECEMBER 9, 1988

ZOP-H10A

7-1113

L G 290