


DUNHAM SURVEYING, S.C.
SURVEYING & SUBDIVIDING
DELAVER, WISCONSIN 53115

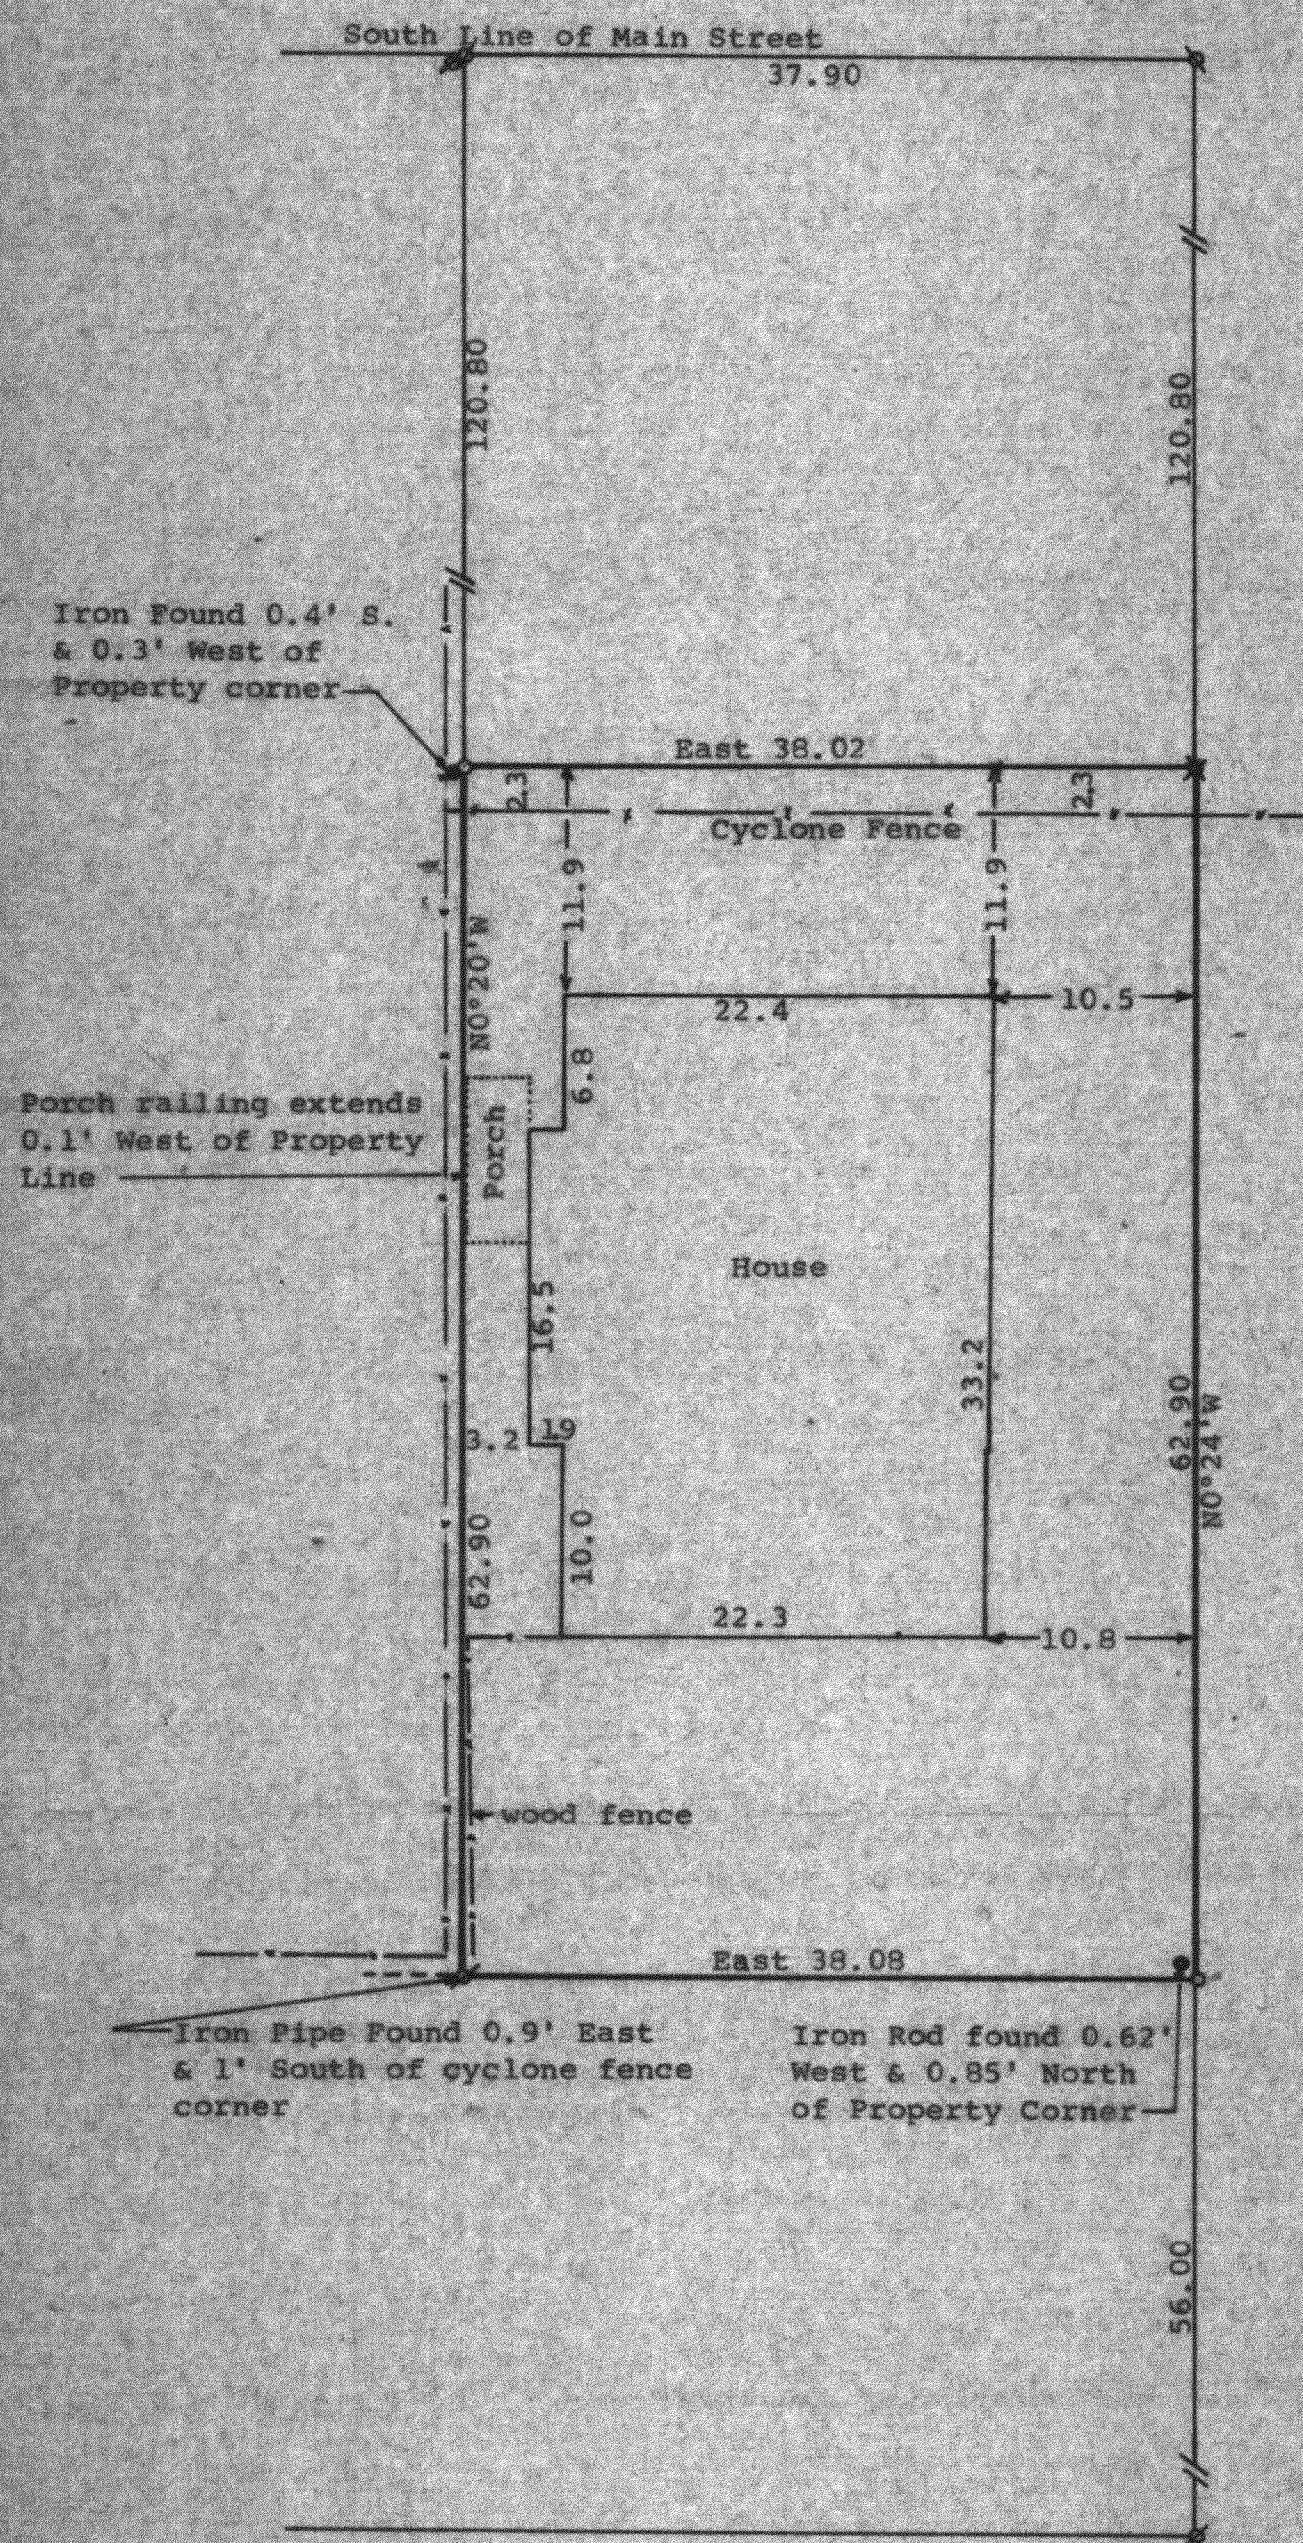

N

Scale - 1" = 10'

o = 3/4" Iron Pipe Found

o = 3/4" X 24" Iron Pipe Set

x = 1/2" X 24" Iron Pipe Set

o = 1" Iron Pipe Found

o = 1/2" Bent Iron Rod Found and pulled

Bearings referenced to the previously assumed bearing of East along the north line of the 16' wide alley in Block 2


--- Fence Line

Survey ordered by:

Realty World, Carmin Realty

811 East Geneva Street

Delavan, WI 53115

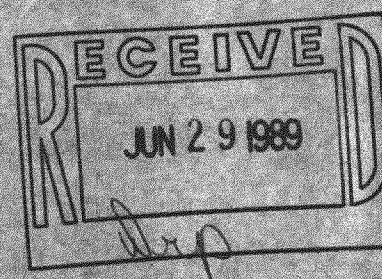

STATE OF WISCONSIN)
COUNTY OF WALWORTH) SS

I, George T. Dunham, Surveyor, certify that I have surveyed the property described as follows:

The South 63 feet of the North 184 feet of the East 1/4 of Lot 1, Block 2 of E. D. Phillip's Subdivision located in the City of Lake Geneva, Walworth County, Wisconsin.

and the plat shown hereon is a correct representation thereof and shows the size and location of the property, its exterior boundaries, the location of all visible structures and dimensions of all principal buildings thereon, boundary fences, apparent easements, roadways and visible encroachments, if any and that I have surveyed the property hereon described according to the official records, to the best of my knowledge and belief.

January 3, 1989

George T. Dunham
George T. Dunham, Surveyor

