


**SURVEYING & SUBDIVIDING
DELAN, WISCONSIN**

Rim of Manhole Elev. = 100.00
Flow Line Elev. = 92.75

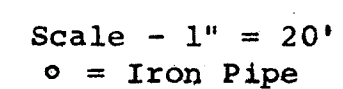

George T. Dunham
George T. Dunham, Surveyor