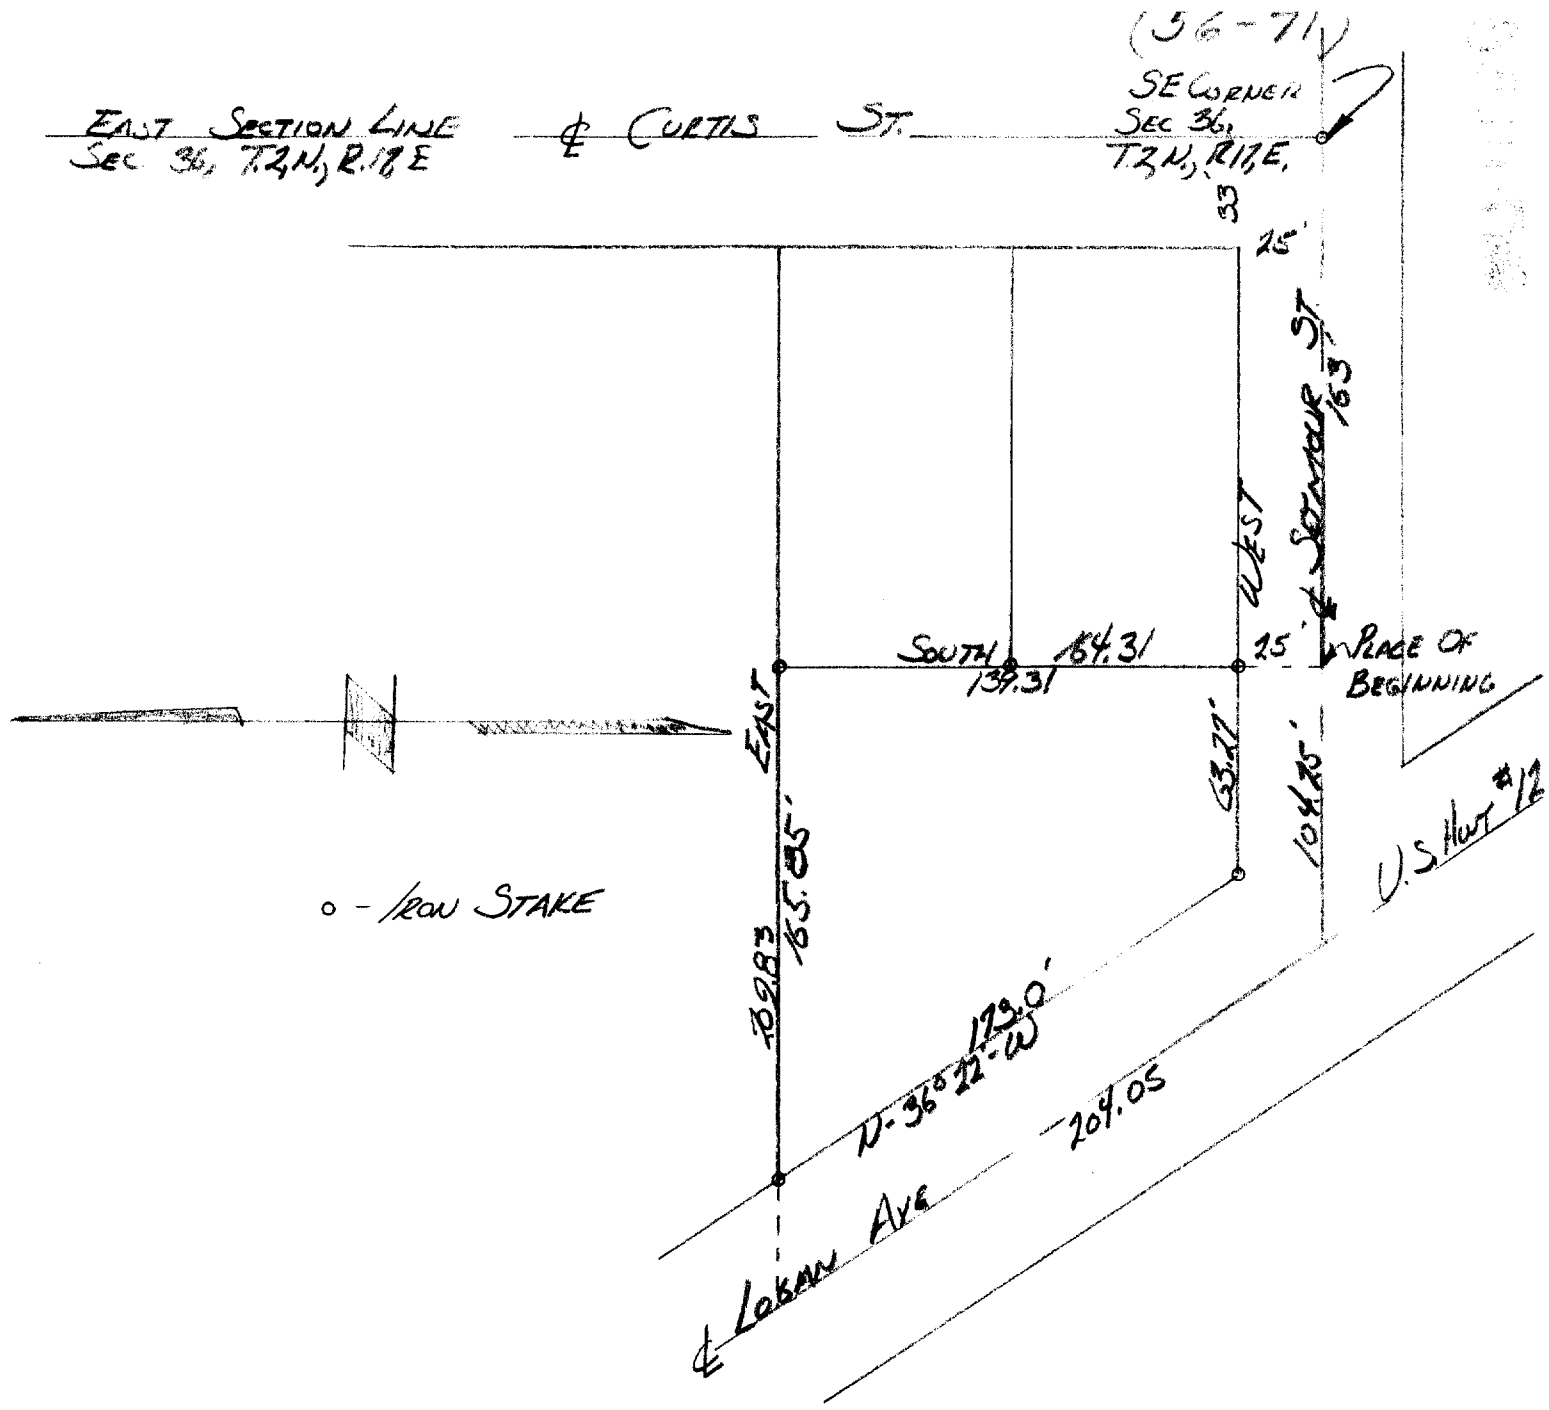

DESCRIPTION: Commencing at a point in the South line of Section 36, T.2,N., R.17,E. of the 4th Principal Meridian, in the City of Lake Geneva, Wisconsin, which is 163.0 feet West of the S. E. corner of said Section, thence West 104.25 feet along the South line of said Section to a point in the centerline of Logan Ave. thence N. 36° 22' W. along the centerline of Logan Ave. 204.05 feet to a point, thence East parallel with the South line of said Section 209.83 feet to an iron stake, thence South parallel with the East line of said Section 164.31 feet to the Place of Beginning.

CERTIFICATE: I hereby certify that I have on this the 23rd day of February, 1956 surveyed the above described land and the above drawing is an accurate portrayal of the survey.

SIGNED AND SEALED ON THIS THE 24TH DAY OF FEBRUARY, 1956.

Joseph M. Biagi
Reg. Land Surveyor
Elkhorn, Wisconsin

~~37~~-118B.2

OP-399
OP-~~1399~~D