
46-25

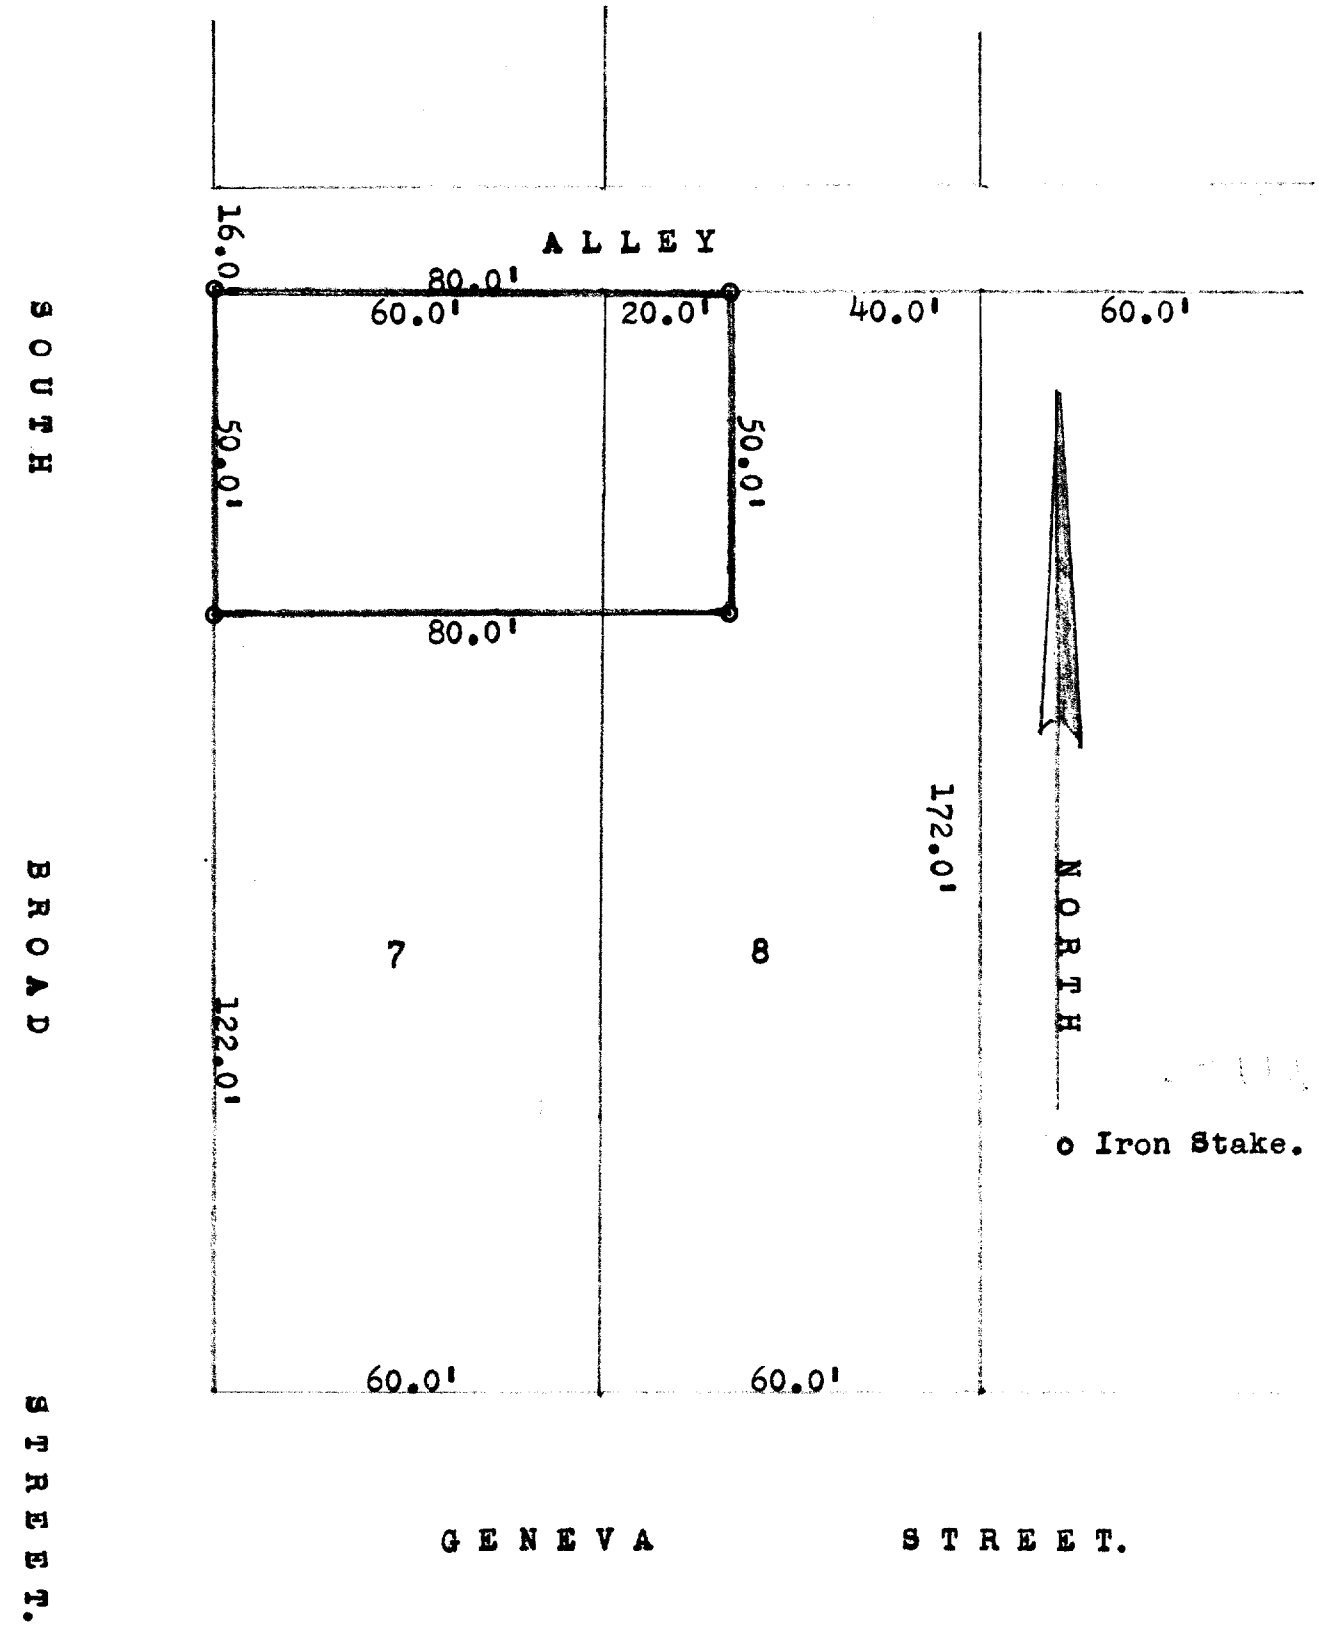

DESCRIPTION:

The North fifty feet of Lot 7 and the West twenty feet of the North fifty feet of Lot 8, all in Block 16, of the Original Plat of the Village (now city) of Lake Geneva Walworth County, Wisconsin.

CERTIFICATE:

I, hereby certify that I have on this the 30th day of September 1946. surveyed the above described property according to the official records on file in the office of the Recorder of Deeds in and for Walworth County Wisconsin, and find that no encroachments exist.

SIGNED AND SEALED THIS 1ST DAY OF OCTOBER 1946.

Joseph M. Biagi.

Joseph M. Biagi. Professional Engineer
Elkhorn Wisconsin.

OP-157A

7-119B 3