


REGISTERED PROFESSIONAL LAND SURVEYOR
LAKE GENEVA, WISCONSIN

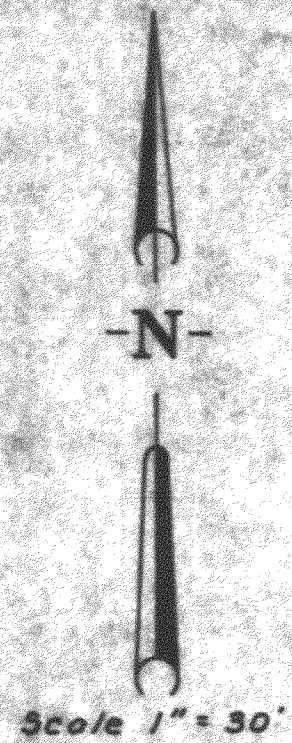


PLAT OF SURVEY OF

Lots 3 and 4, Block One, Geneva Bay Estates,
City of Lake Geneva, Walworth County, Wisconsin.

Harold H. Kolb

Harold H. Kolb, Wisconsin Surveyor, S-187

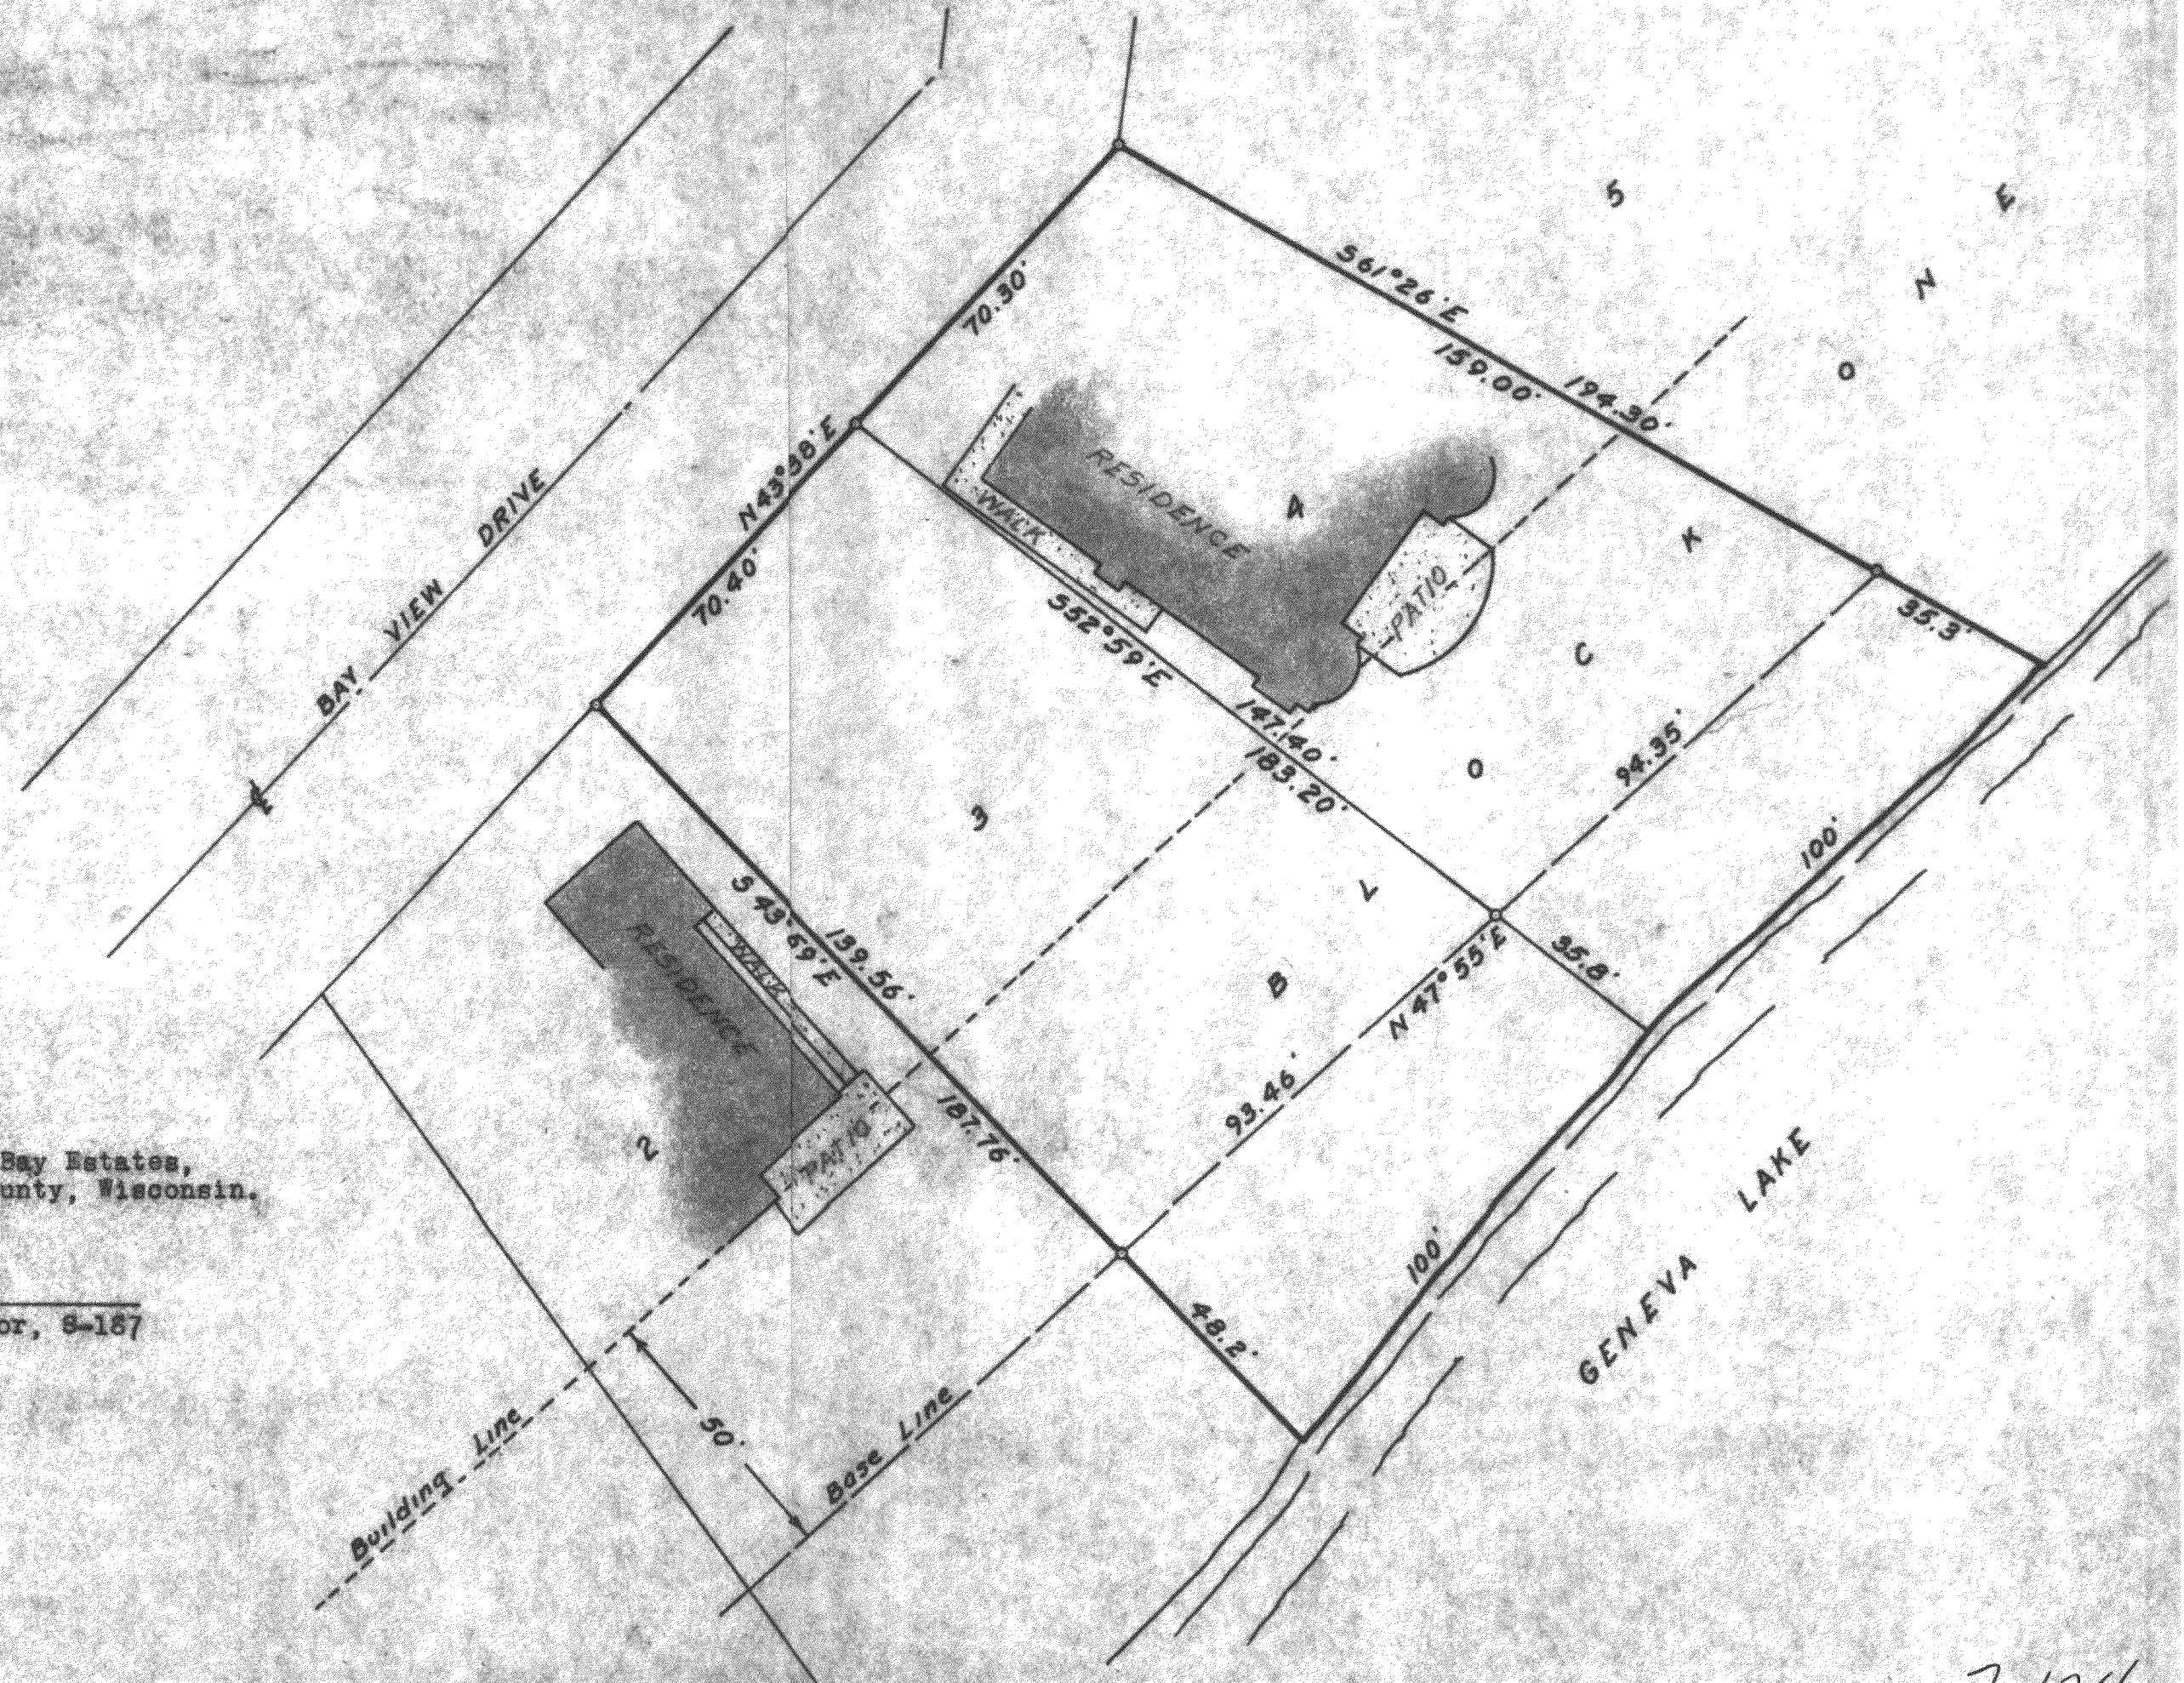

2003, 4
o - Iron Pipe

7-124