


N
SCALE : 1" = 40'
LEGEND

- - IRON PIPE
- - RAILROAD SPIKE
- - UTILITY POLE
- - OVERHEAD UTILITY LINES
- - MANHOLE
- - HYDRANT

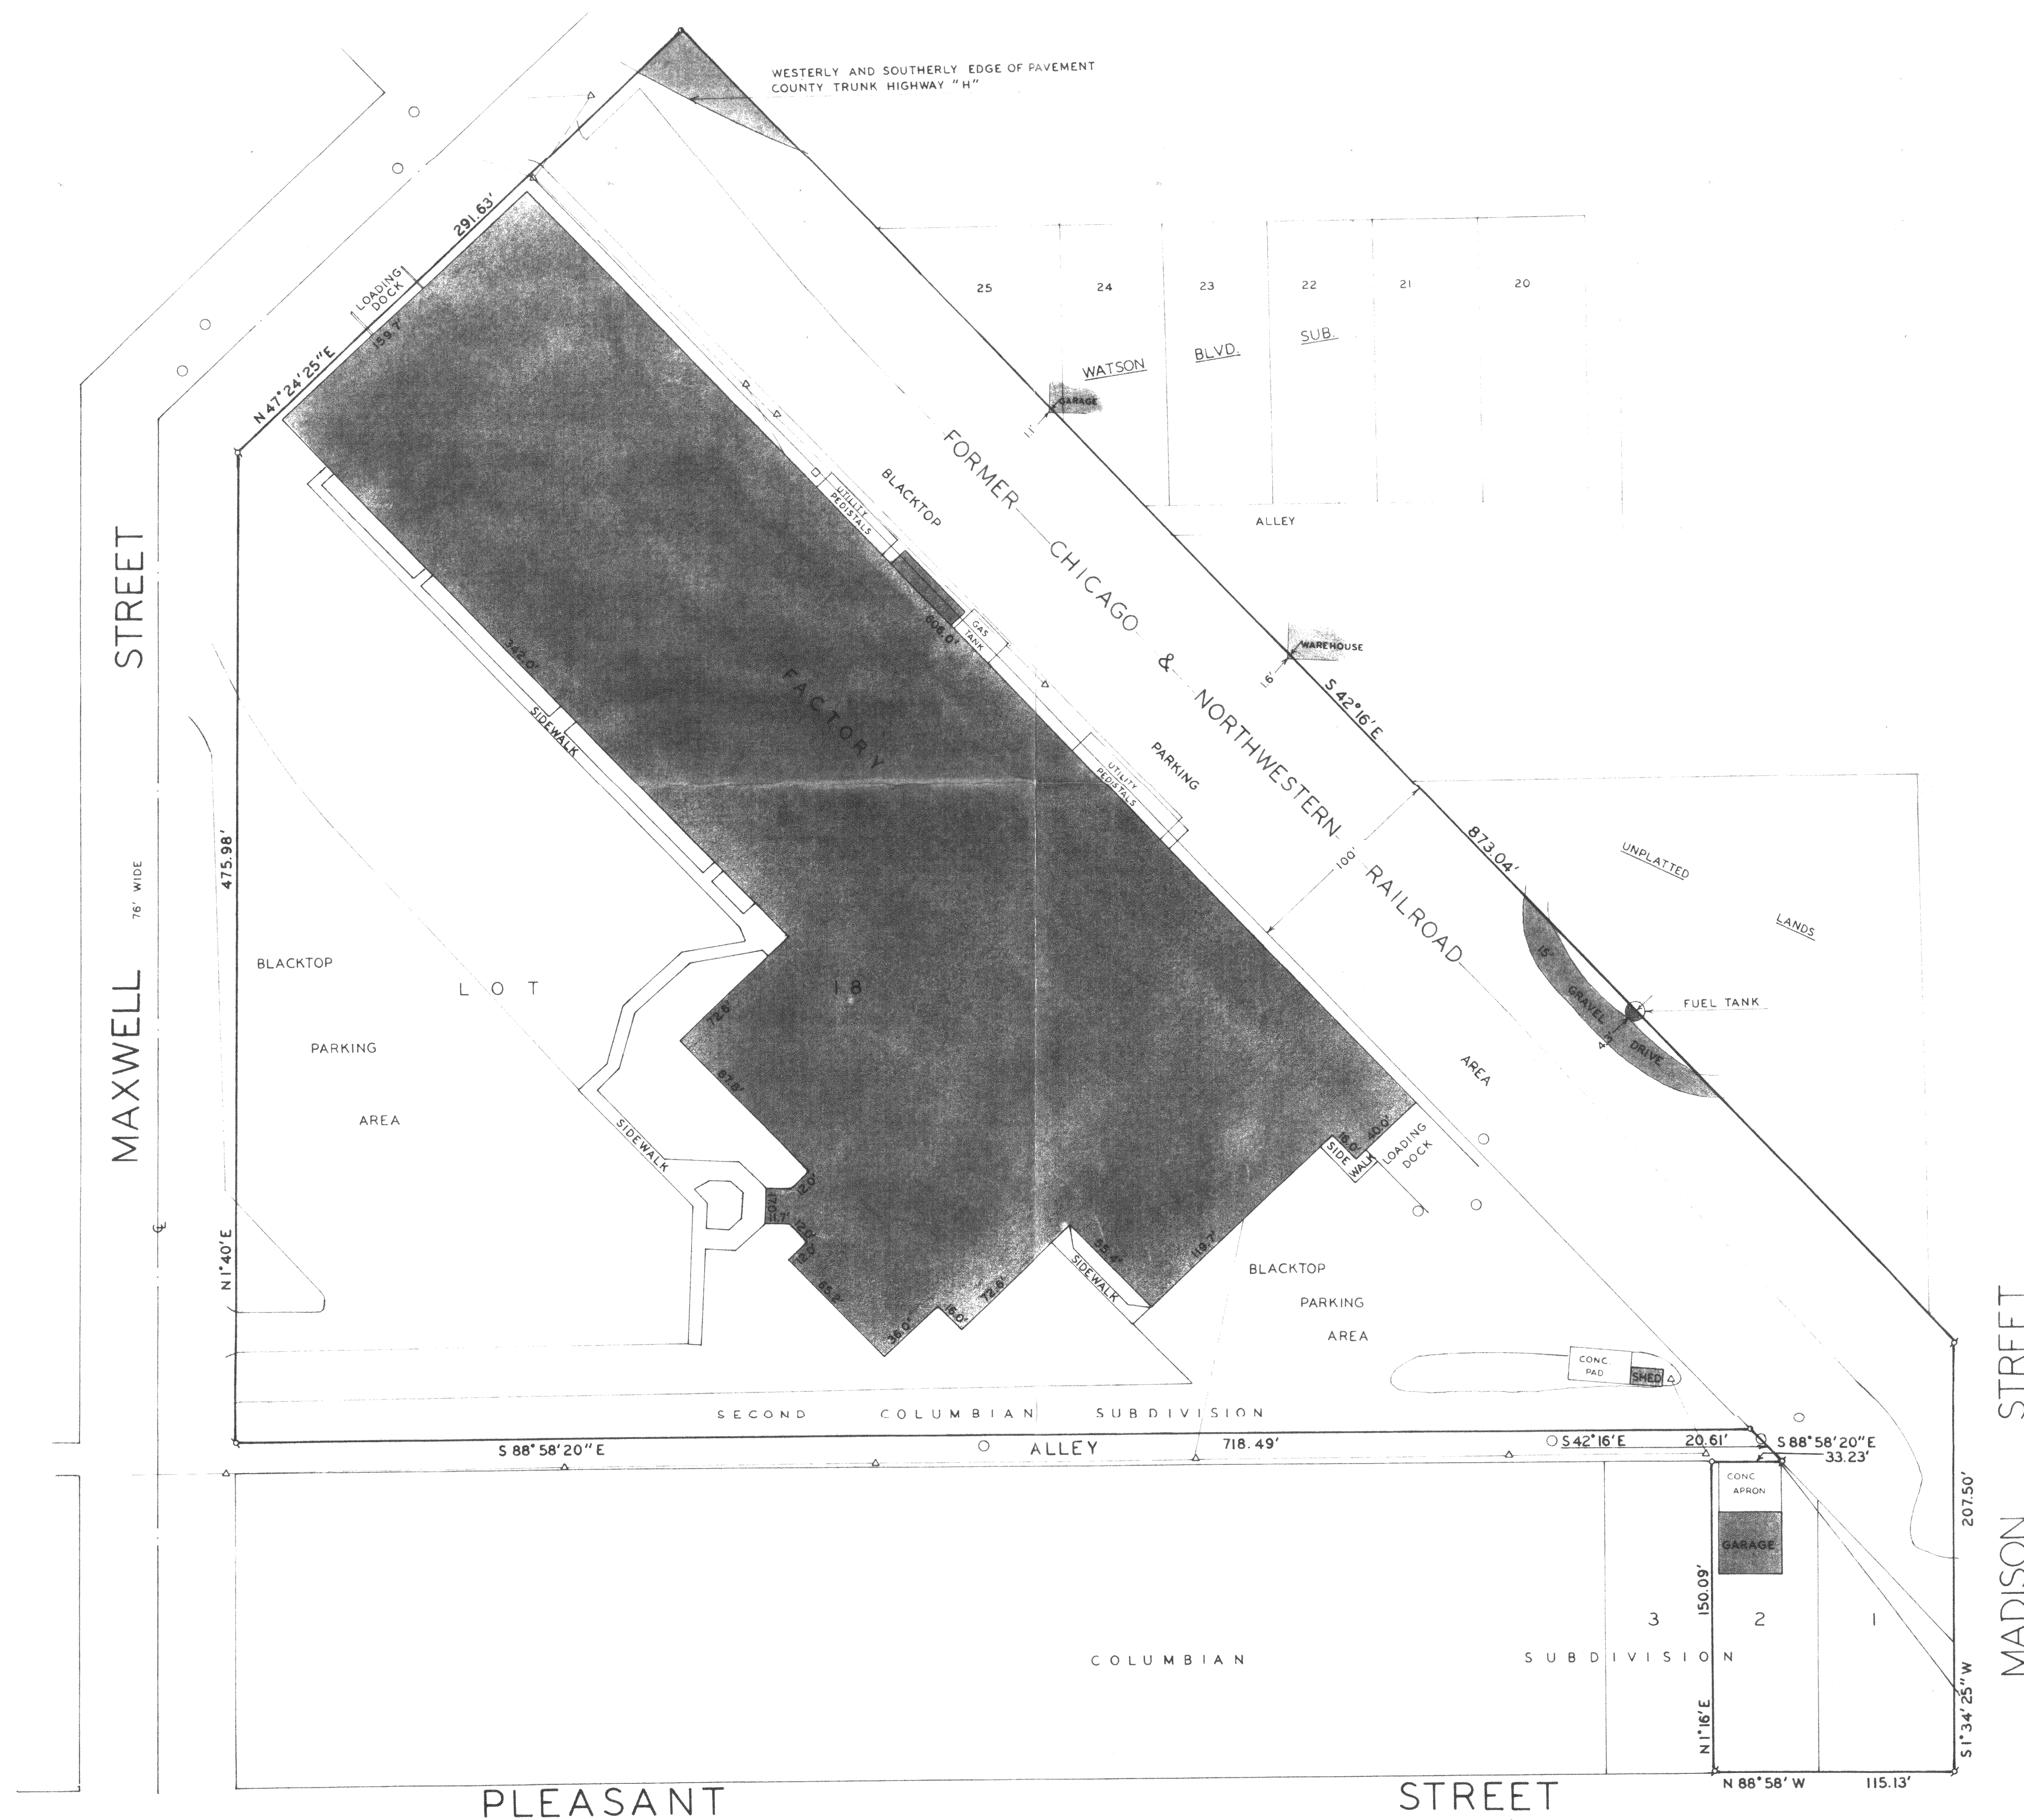

PLAT OF SURVEY OF
LOT 18 OF THE SECOND COLUMBIAN SUBDIVISION AND
LOTS 1 AND 2 OF THE COLUMBIAN SUBDIVISION AND A
PARCEL OF LAND BEING PART OF THE FORMER CHICAGO
AND NORTHWESTERN RAILROAD ALL LOCATED IN THE CITY
OF LAKE GENEVA, WISCONSIN.

ORDERED BY: ALBERT TROSTEL PACKING, INC.
901 MAXWELL STREET
LAKE GENEVA, WI. 53147

NOTE: BEARINGS ARE ASSUMED AS SHOWN ON EXISTING
SURVEY RECORDS.

I HEREBY CERTIFY THAT I HAVE SURVEYED THE
ABOVE DESCRIBED PROPERTY AND THAT THE ABOVE
MAP IS A TRUE REPRESENTATION THEREOF AND
SHOWS THE SIZE AND LOCATION OF THE PROPERTY,
ITS EXTERIOR BOUNDARIES, THE LOCATION OF ALL
VISIBLE STRUCTURES AND SUPERVISIONS OF ALL
PRINCIPAL BUILDINGS THEREON, BOUNDARY FENCES,
APPARENT EASEMENTS, ROADWAYS AND VISIBLE
ENCROACHMENTS, IF ANY, TO THE BEST OF MY
KNOWLEDGE AND BELIEF.
THIS SURVEY IS MADE FOR THE USE OF THE
PRESENT OWNERS OF THE PROPERTY AND ALSO
THOSE WHO PURCHASE, HERITAGE OR GUARANTEE
THE TITLE THEREIN WITHIN ONE (1) YEAR FROM
DATE HEREOF.
SURVEY NOT VALID UNLESS SURVEYOR'S SIGNATURE
IS IN RED.

HAROLD H. KOLB
WISCONSIN REGISTERED LAND SURVEYOR, S-187

DATE: NOVEMBER 27, 1989

