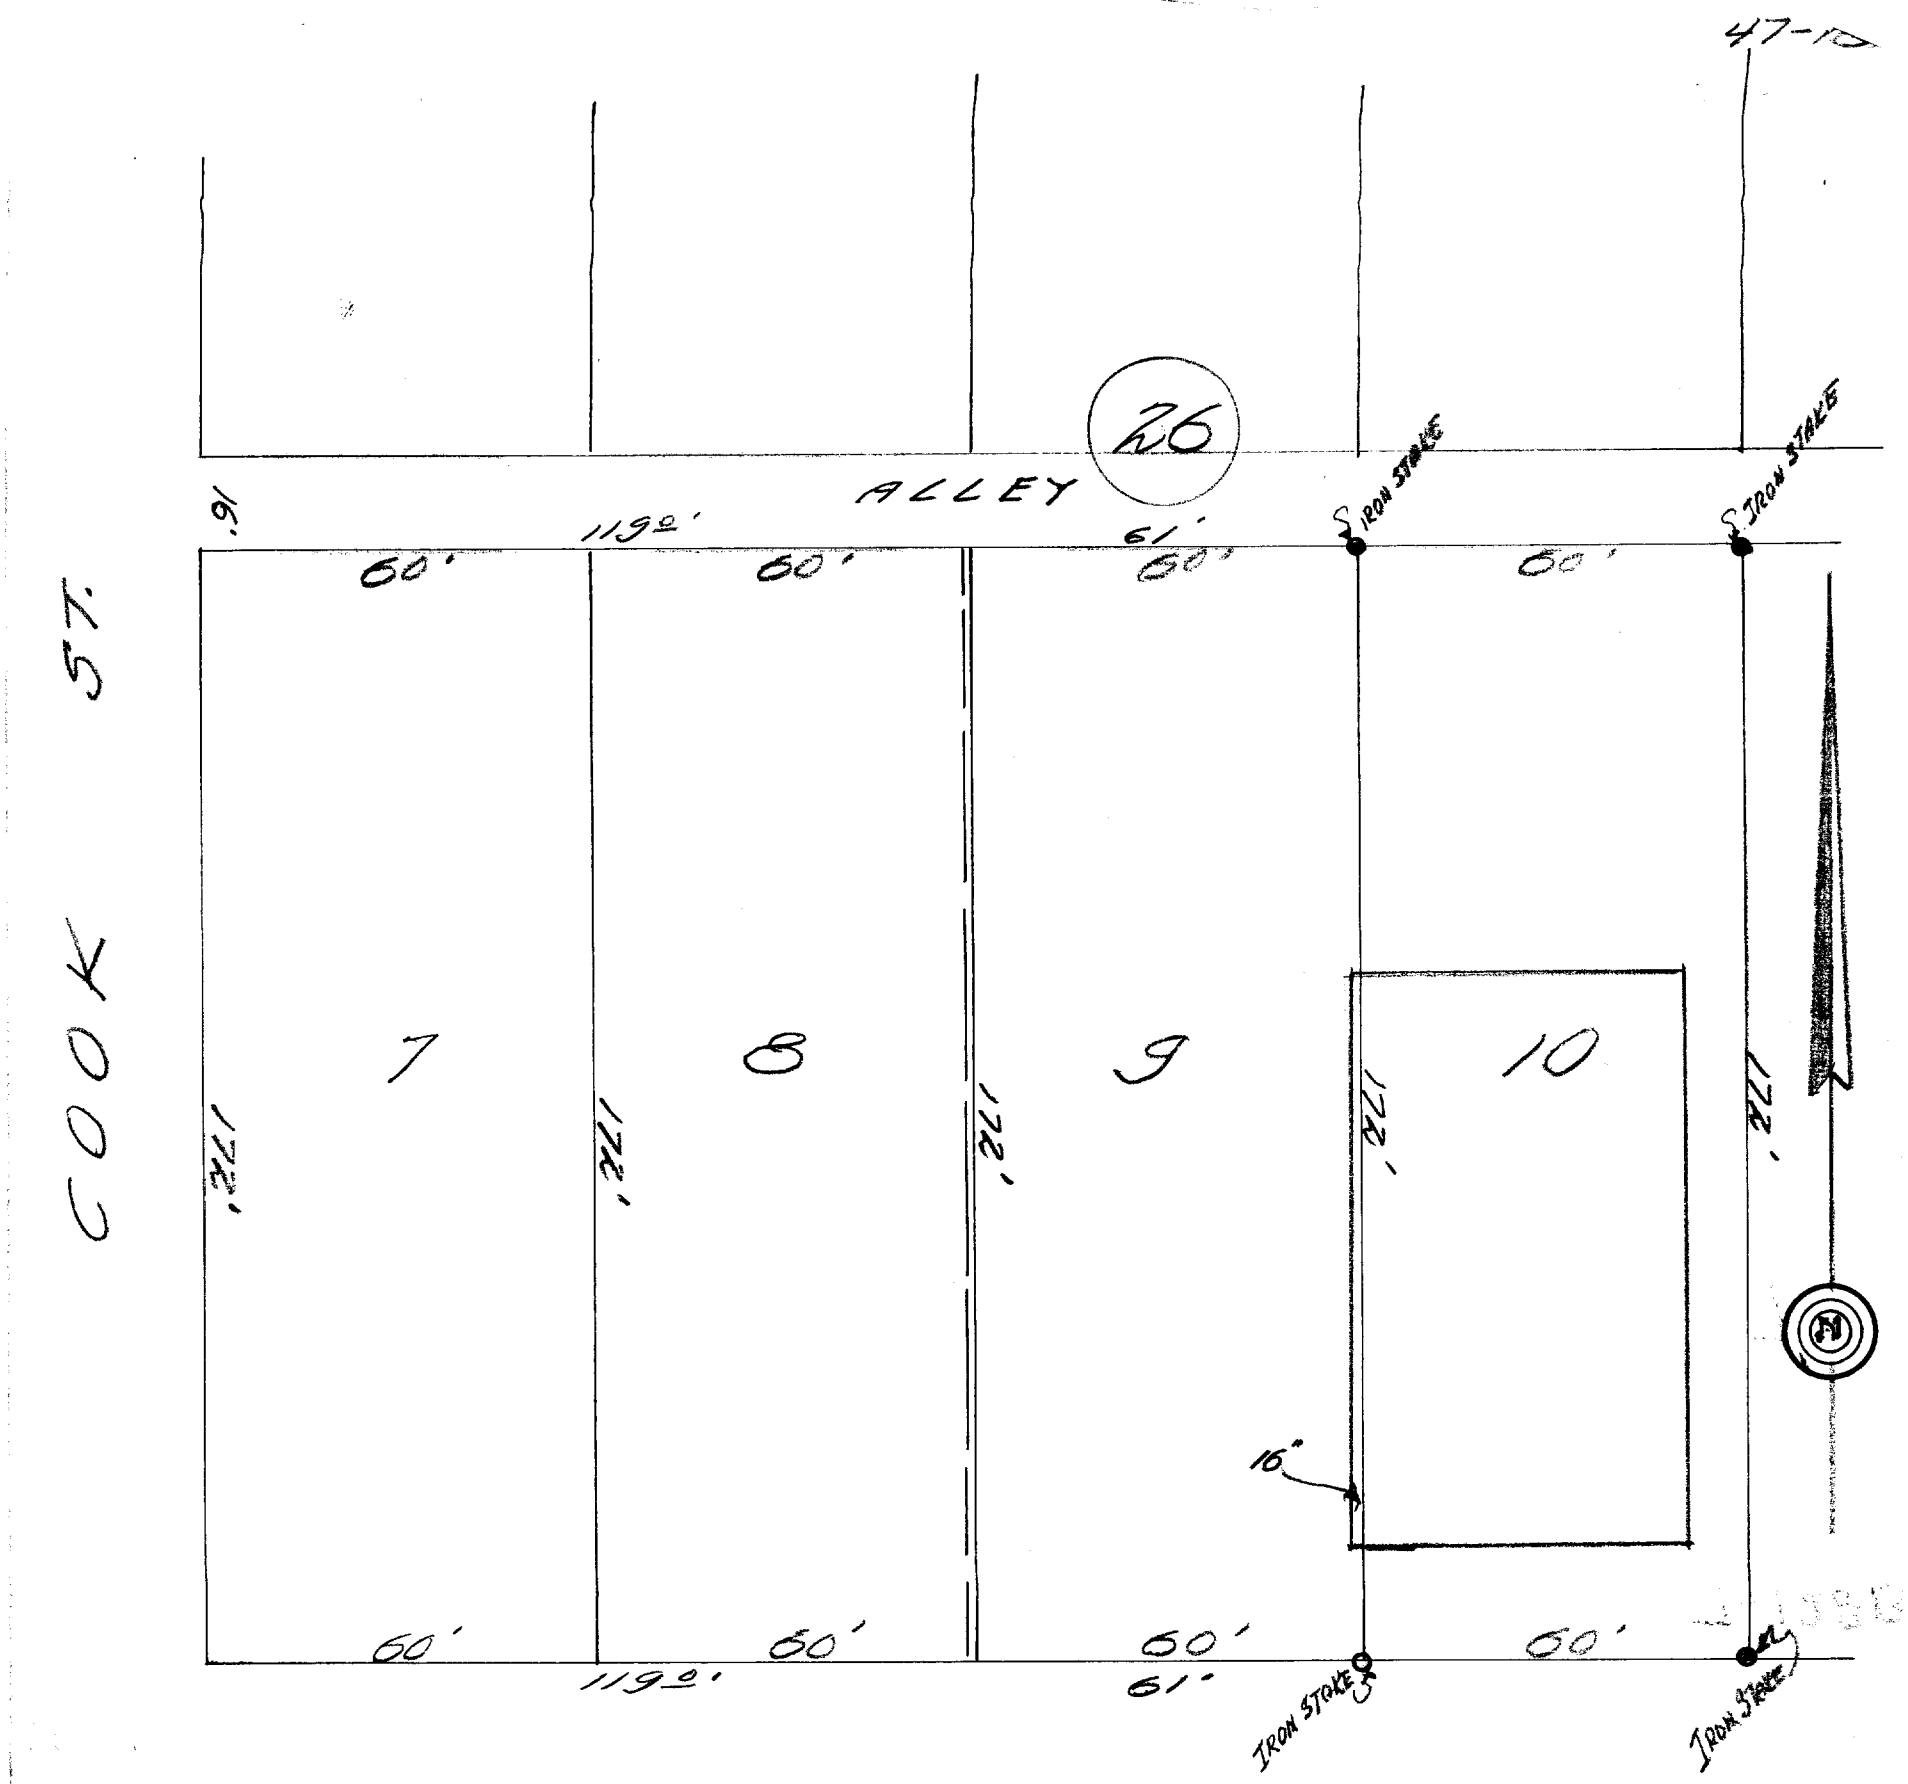


DESCRIPTION:

Lot10 Block26, Original Plat of the Village (now city) of Lake Geneva, Walworth County, Wisconsin.

CERTIFICATE:

I, Joseph M. Biagi, do hereby certify that I have on this the 6 th day of June 1947, surveyed the above described property according to the official records on file in the office of the Recorder of Deeds in and for Walworth County Wisconsin and find that the measurements and bearings of the boundary lines of said property as taken at the site on this day, substantially agree with those on the above plat, and that the eaves on the house on said lot10 encroach upon lot 9 in said block 26 by 16 inches.

SIGNED AND SEALED THIS 8TH DAY OF JUNE 1947.

Joseph M. Biagi.
Professional Engineer
Elkhorn Wisconsin.

7-1281B

08-355