


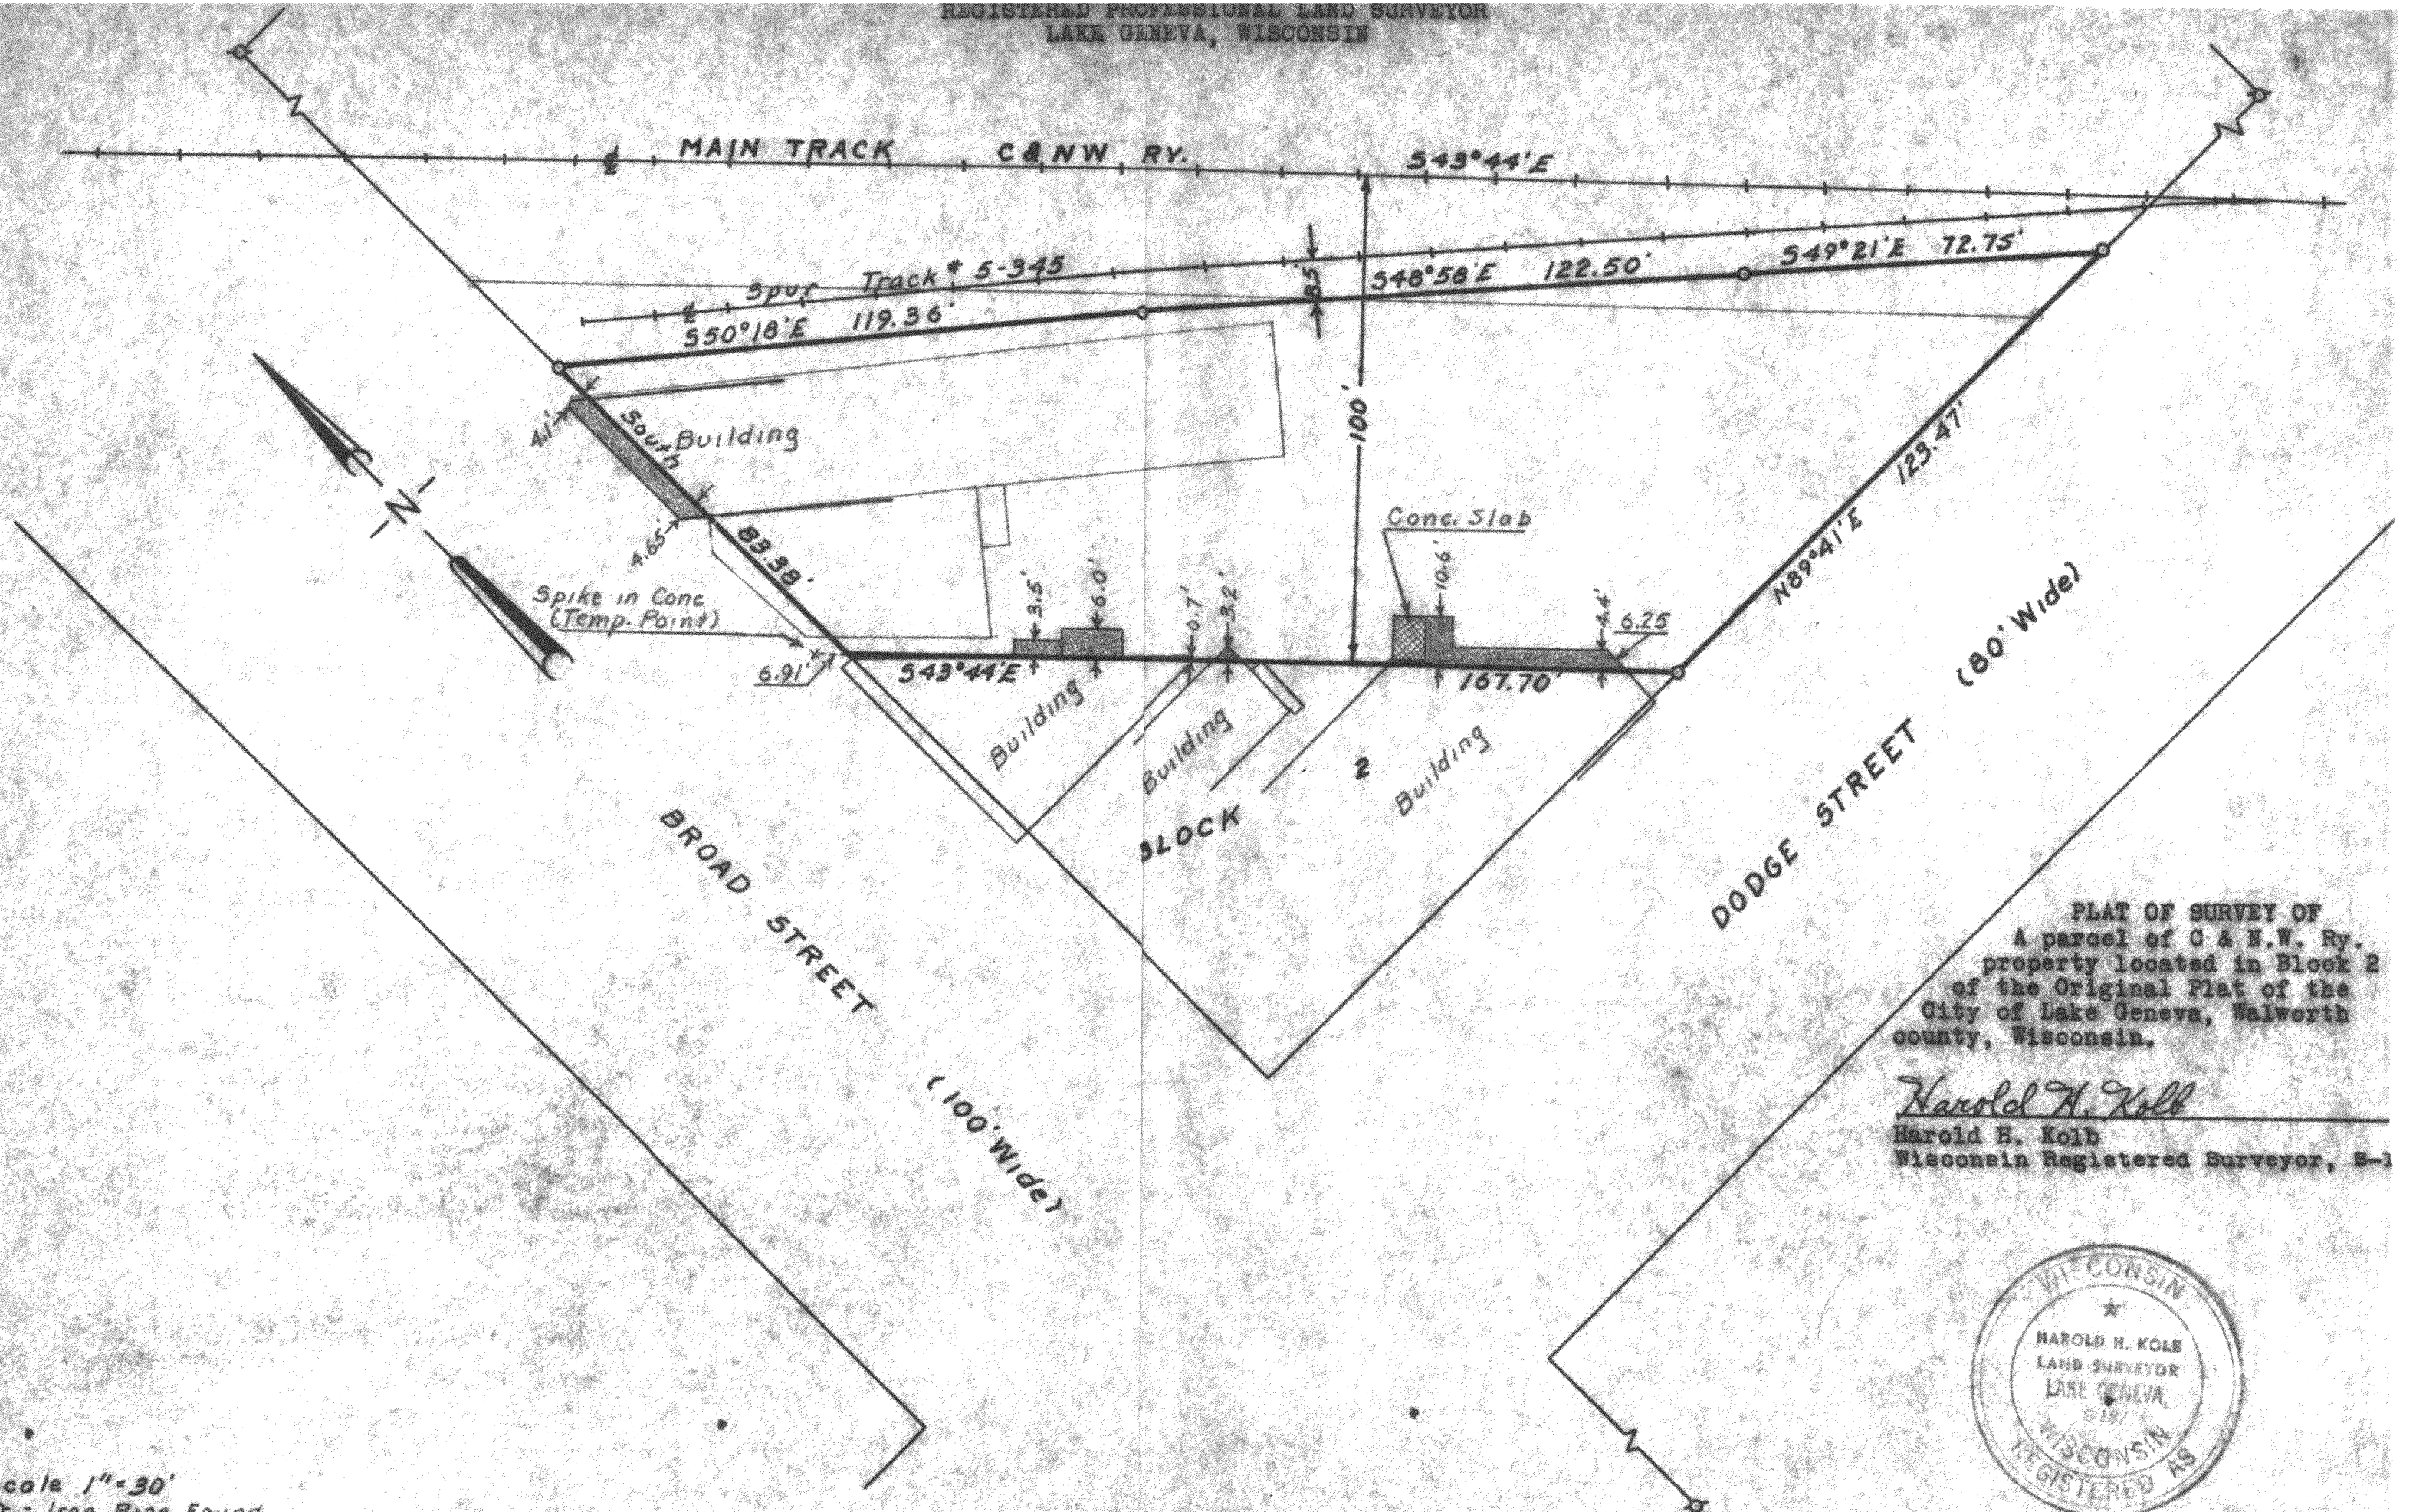

PLAT OF SURVEY OF
A parcel of C & N.W. Ry.
property located in Block 2
of the Original Plat of the
City of Lake Geneva, Walworth
County, Wisconsin.

Harold H. Kolb
Harold H. Kolb
Wisconsin Registered Surveyor, S-1



Scale 1"=30'
 ○ - Iron Pipe Found
 ○ - Iron Pipe Placed
 6-29-62

6P-33A

OP-29 + OP-32

7-131

7-60