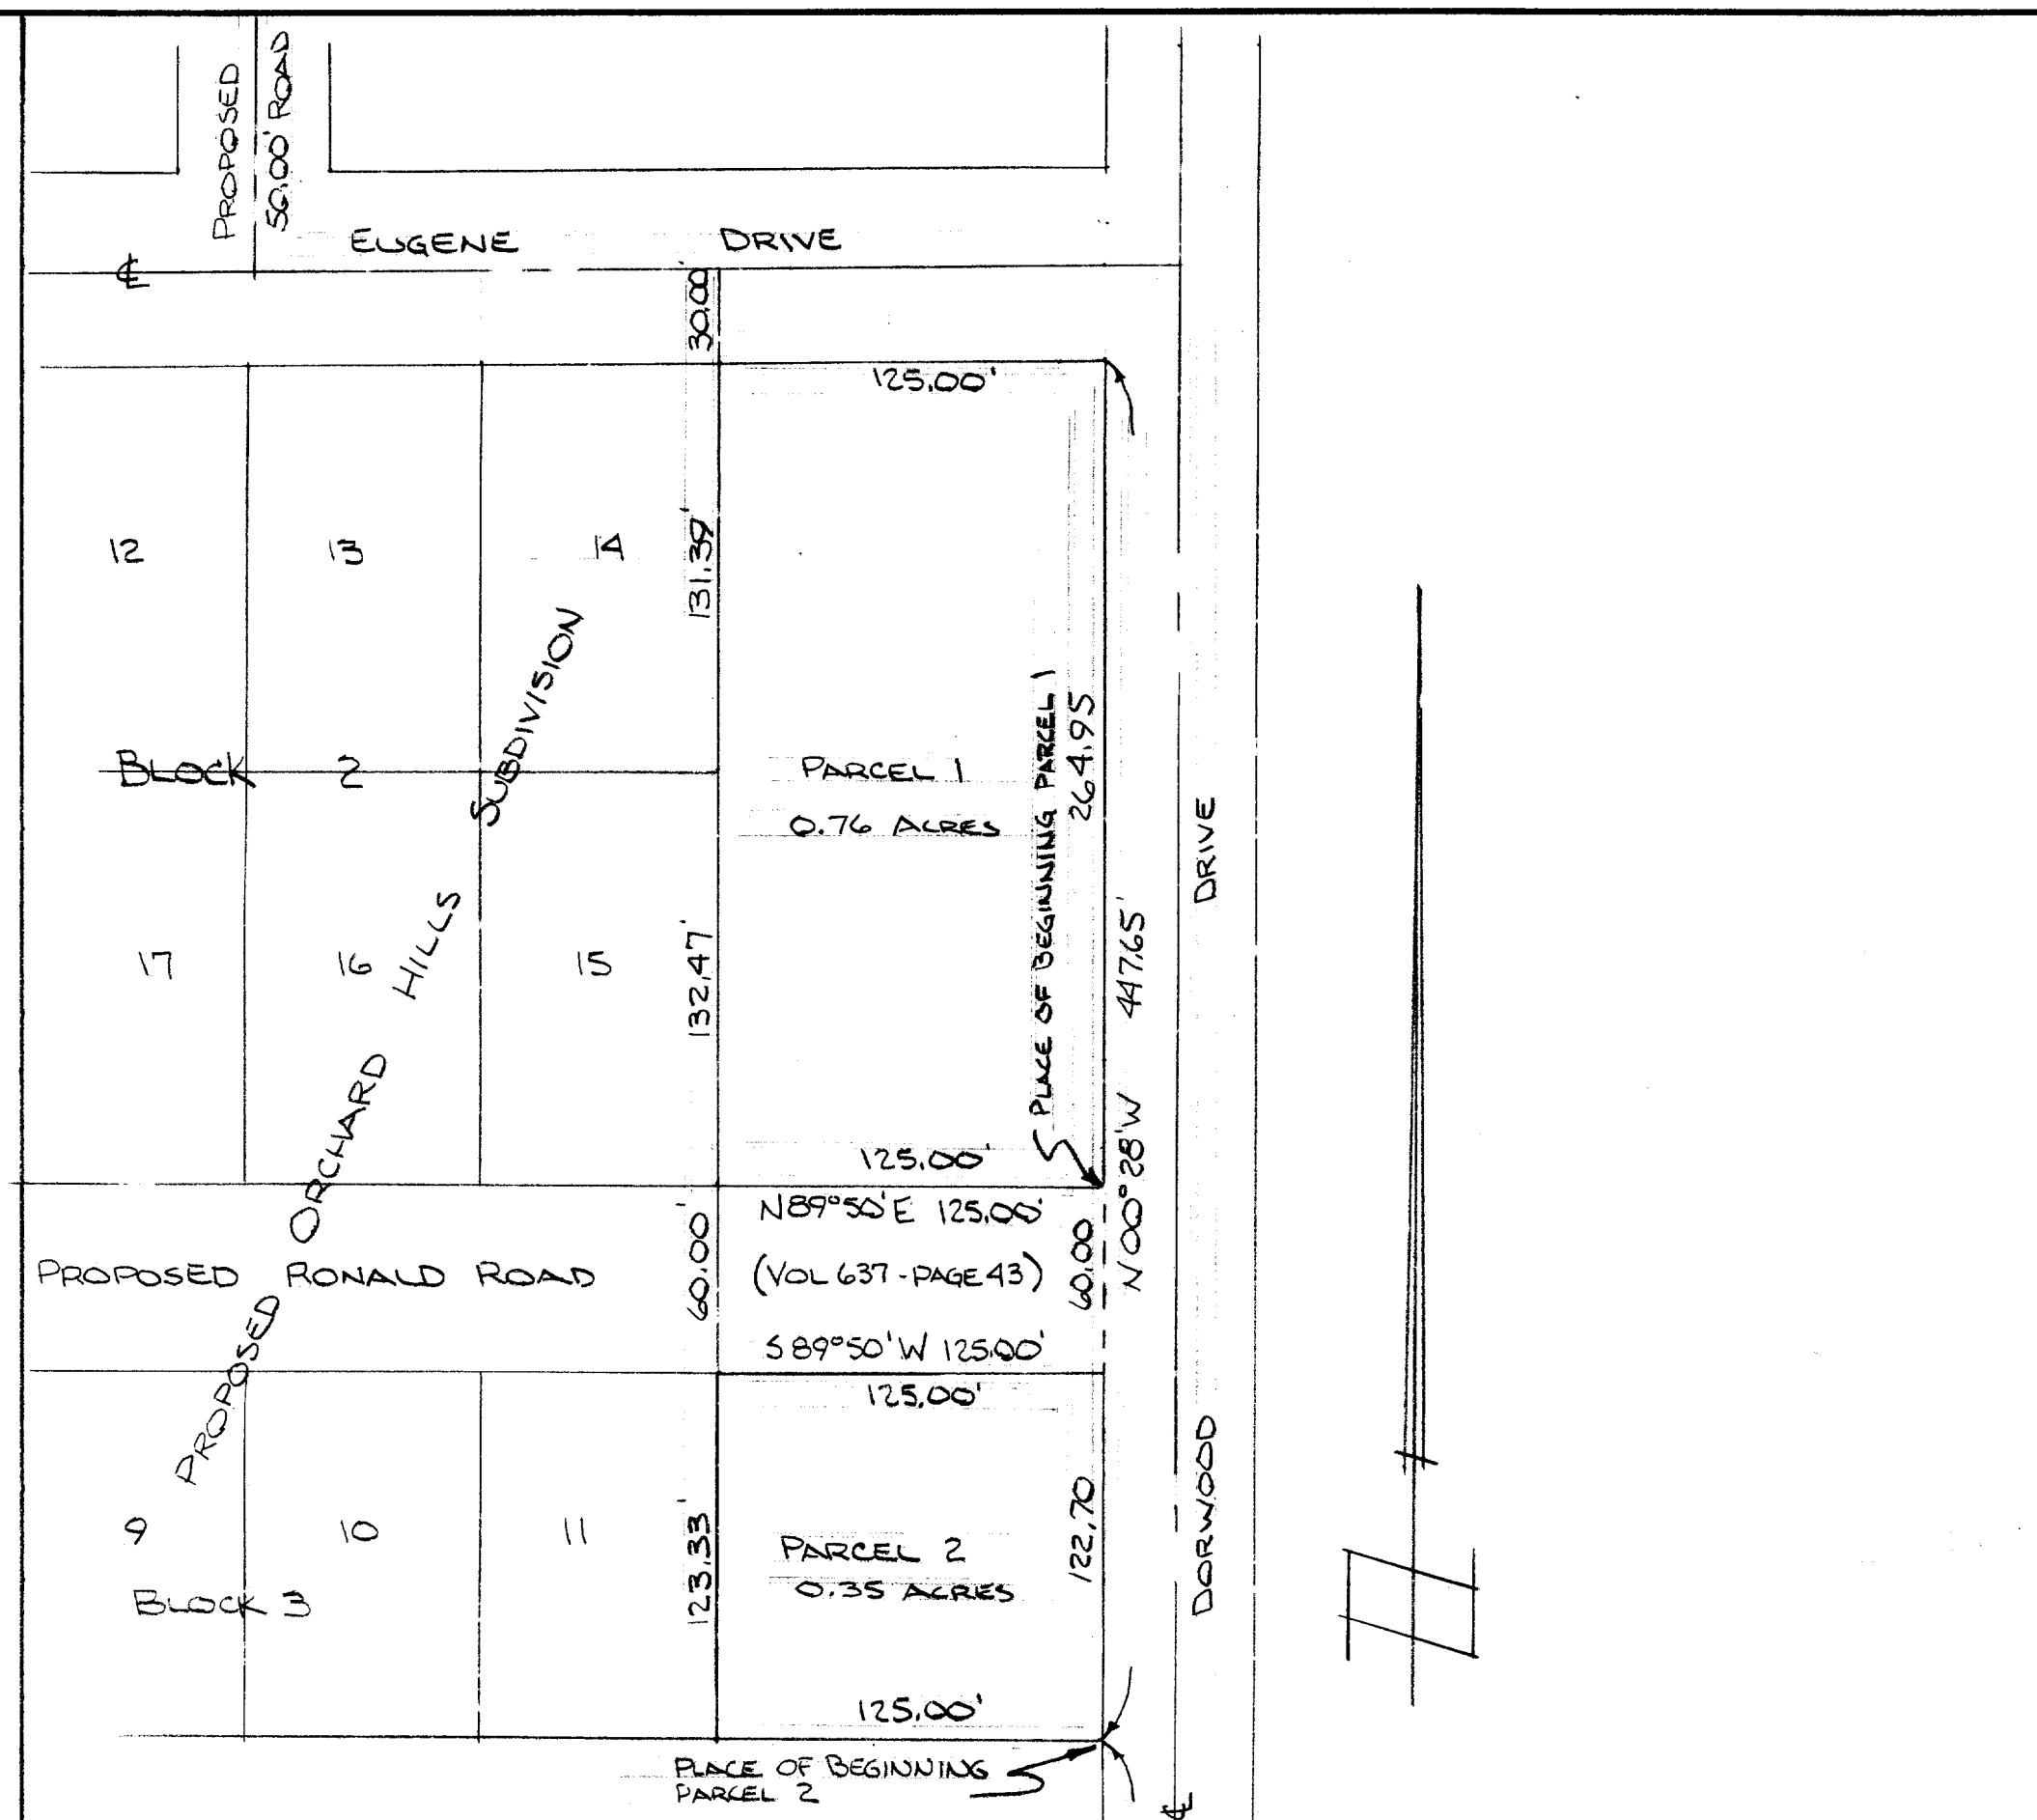


DESCRIPTIONS:

PARCEL 1:

Commencing at the East ¼ corner of Section 1, T1N, R17E, Walworth County, Wisconsin; thence S 89°46' W 1125.96 feet along the E-W ¼ line of said Section to it's point of intersection with the West line of Dorwood Drive thence N 00°28' W 1102.45 feet along said West line of Dorwood Drive to the Place of Beginning of the lands hereinafter described to-wit: thence continue N 00°28' W 447.65 feet along said road line to the South line of Eugene Drive, thence W'ly along said road line 125.00 feet to the NE corner of Lot 14, Block 2 of proposed Orchard Hills Subd., thence S'ly along the East line of said Block 2 of proposed Orchard Hills Subd., to a point in the North line of a proposed 60.00 feet wide road, thence N 89°50' E 125.00 feet along said road line to the Place of Beginning, containing 0.76 acres of land, more or less.

PARCEL 2:

Commencing at the East ¼ corner of Section 1, T1N, R17E, Walworth County, Wisconsin; thence S 89°46' W 1125.96 feet along the E-W ¼ line of said Section to it's point of intersection with the West line of Dorwood Drive, thence N 00°28' W 919.75 feet along said West line of Dorwood Drive to the Place of Beginning of the lands hereinafter described to-wit; thence continue N 00°28' W 122.70 feet along said road line to a point in the South line of a proposed 60.00 feet wide road, thence S 89°50' W 125.00 feet along said road line to the NE corner of Lot 11, Block 3 of proposed Orchard Hills Subd. thence S'ly along said Lot line to the SE corner of said lot, thence E'ly 125.00 feet to the Place of Beginning, containing 0.35 acres of land, more or less.

CERTIFICATE:

I, Joseph M. Biagi, surveyor, do hereby certify that I have surveyed the lands hereon described.

DATE:

January 25, 1974

UP - 121/A
" 121-1A
" 121-A2

Joseph M. Biagi
Elkhorn, Wisconsin

RLS #12

PLAT OF SURVEY FOR
ALVIN WEST

SCALE: 1" = 60'	APPROVED BY:	DRAWN BY GW
DATE: 1-25-74		REVISED
		DRAWING NUMBER

7-146B