
#116-73

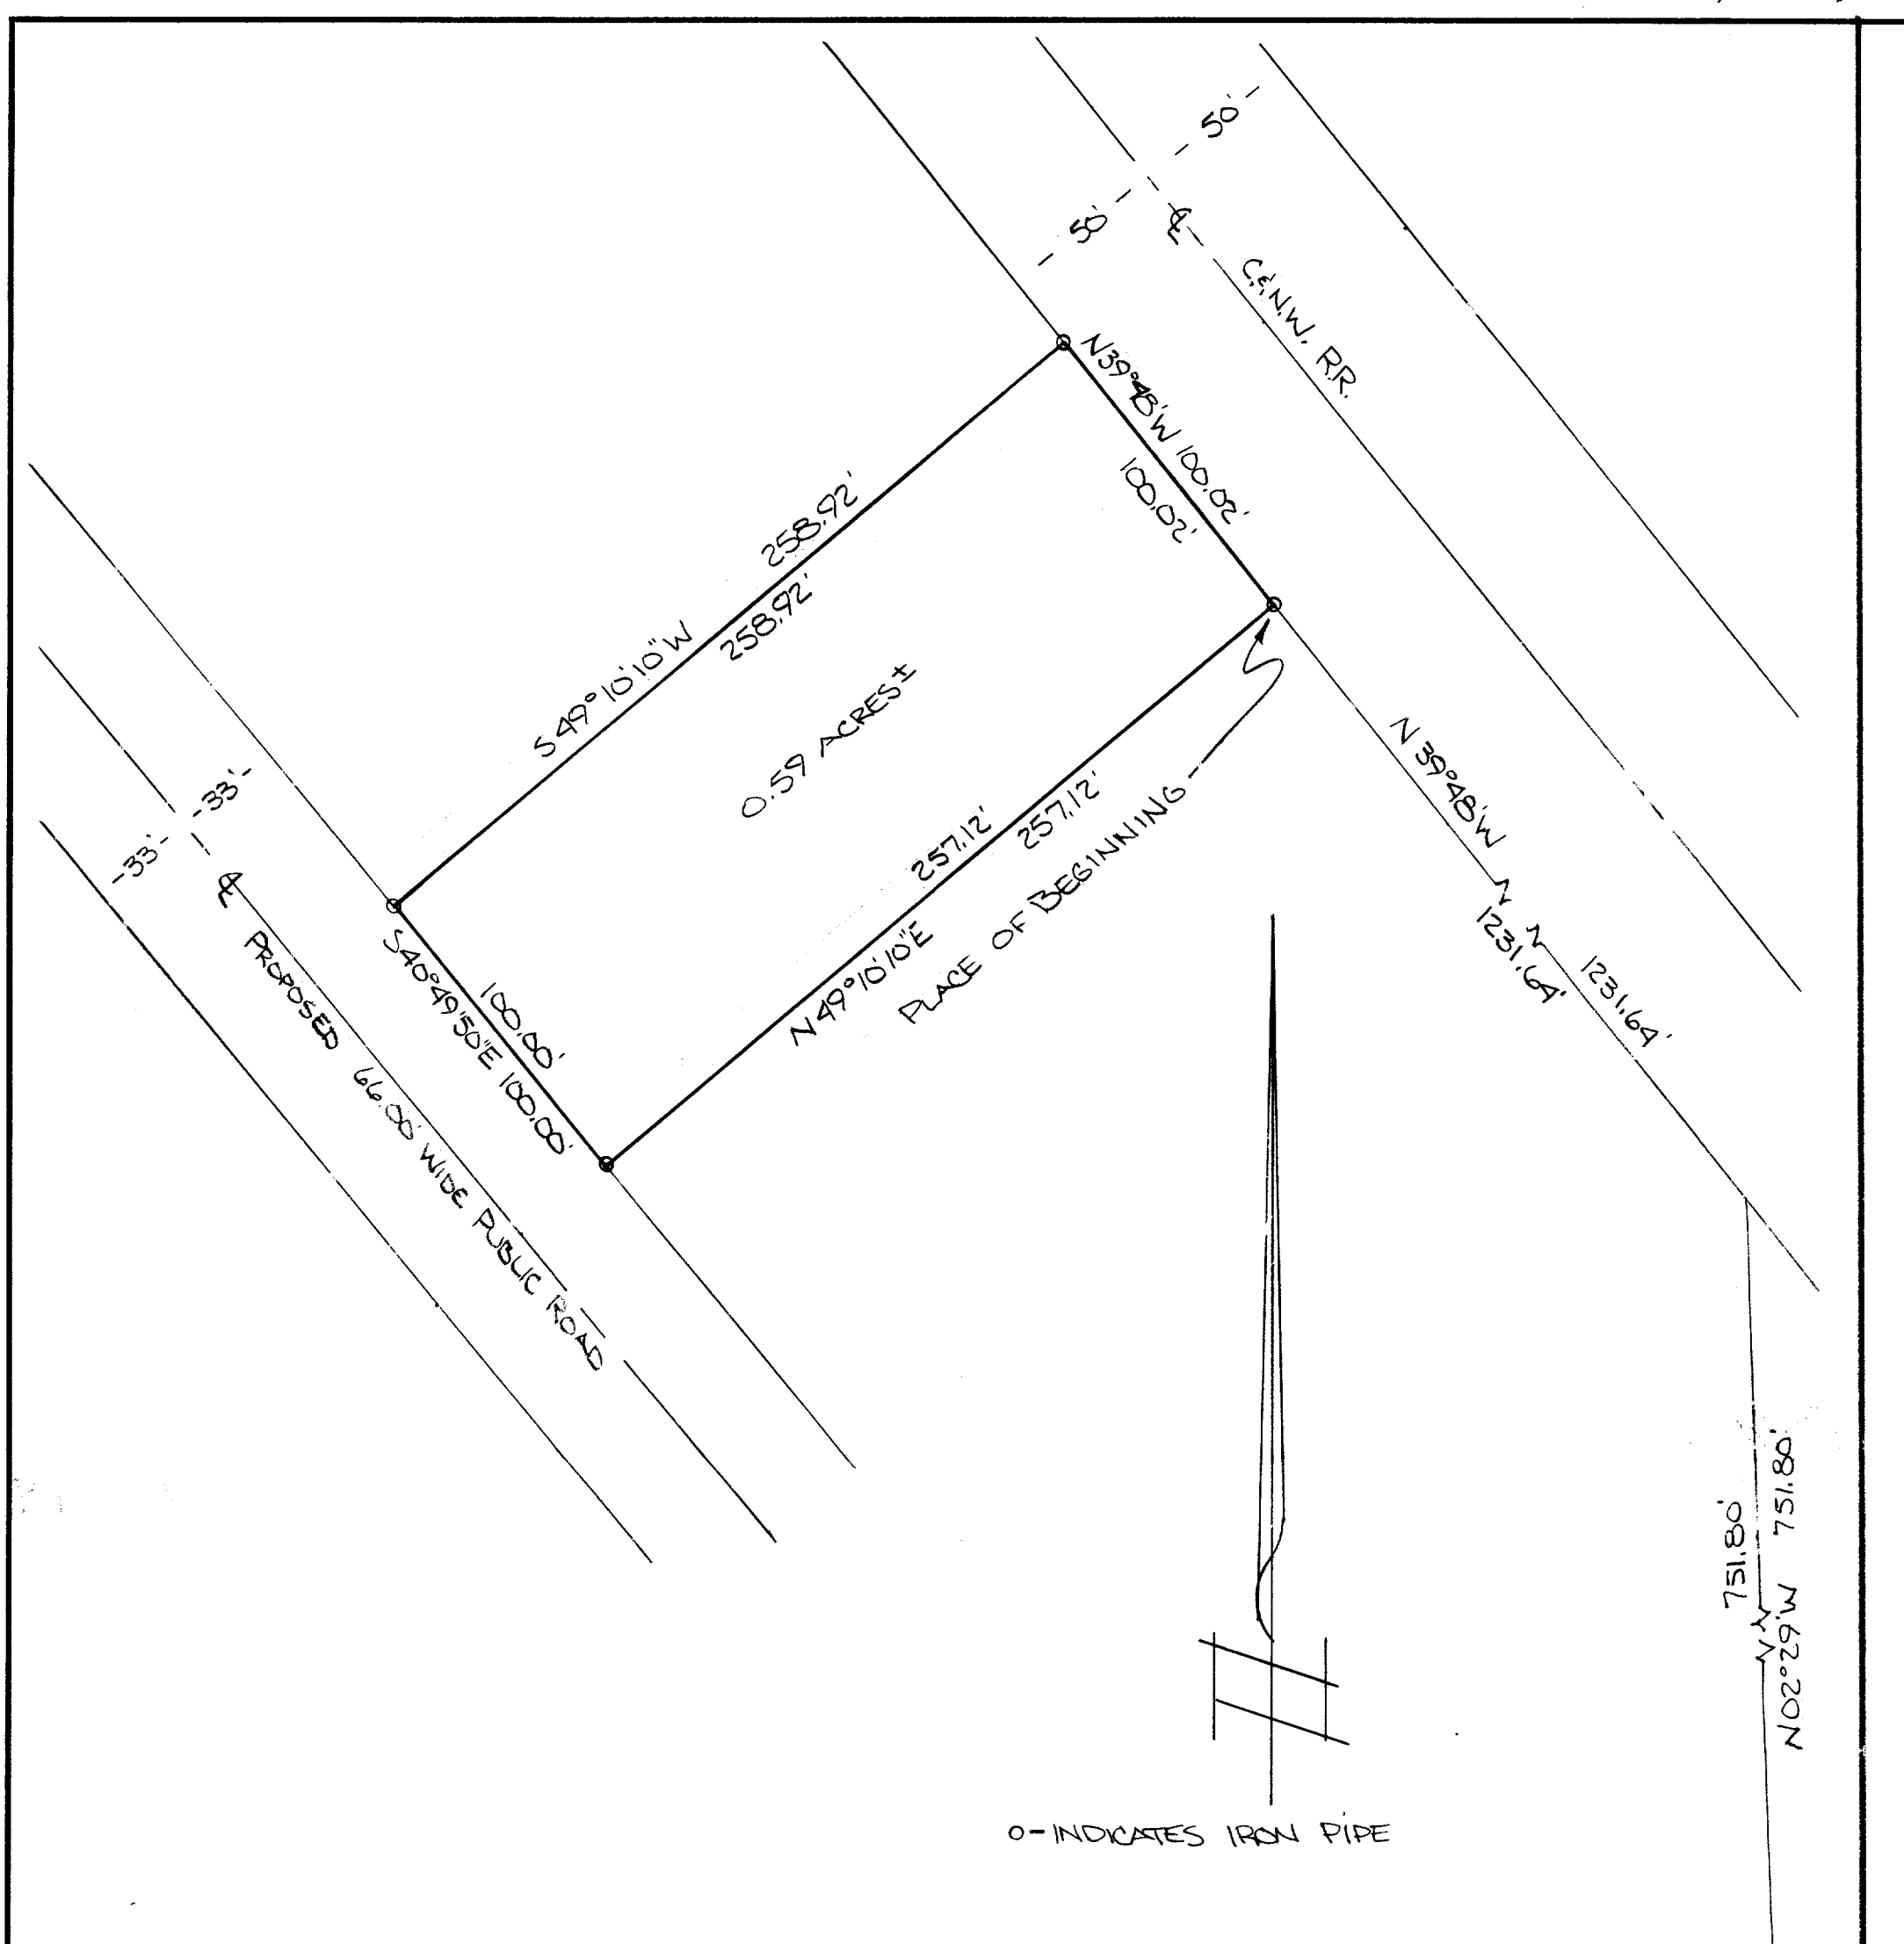

SE. COR. OF THE NW¼ OF SEC. 6, T1N, R18E

DESCRIPTION:
Commencing at the SE corner of the NW¼ of Section 6, T1N, R18E, Walworth County, Wisconsin; thence N 02°29' W 751.80 feet to the SW'ly line of the C.&N.W. R.R. R.O.W., thence N 39°48'W 1231.64 feet to the Place of Beginning of the lands hereinafter described to-wit: thence continue N 39° 48' W 100.02 feet, thence S 49°10'10" W 258.92 feet to a point in the NE'ly line of a proposed road, thence S 40° 49'50" E along said road line 100.00 feet, thence N 49° 10'10" E 257.12 feet to the Place of Beginning, containing 0.59 acres of land, more or less.

CERTIFICATE:
I, Joseph M. Biagi, surveyor, do hereby certify that I have surveyed the lands hereon described.

DATE:
October 2, 1973

Joseph M. Biagi RLS #12
Elkhorn, Wisconsin

UP-145C

18X24 PRINTED ON NO. 1000H CLEARPRINT

7-149B