
47-15

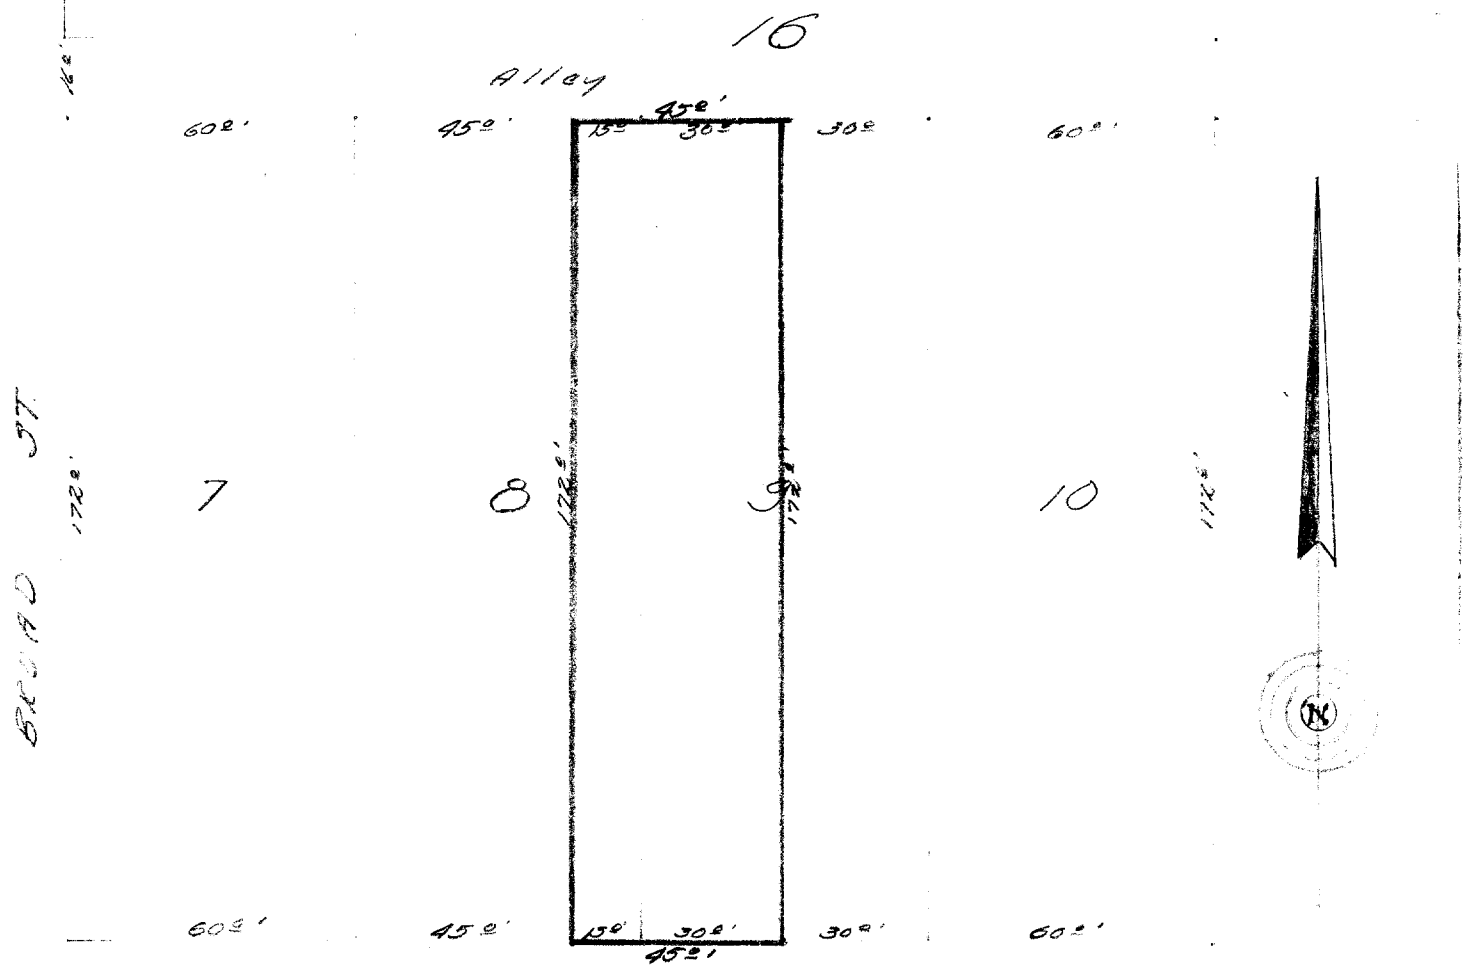

DESCRIPTION:

The East 15 feet of Lot 8, Block 16 and the West ½ of Lot 9, Block 16 of the Original Plat of the Village (now city) of Lake Geneva, Walworth County Wisconsin.

CERTIFICATE:

I, hereby certify that I have on this the 27th day of October, 1947, surveyed the above described property according to the official records on file in the office of the Recorder of Deeds in and for Walworth County, Wisconsin, and find that the measurements and bearings of the boundary lines of said property as taken at the site on this day, substantially agree with those in the above description, and that no encroachments exist.
SIGNED AND SEALED THIS 27TH DAY OF OCTOBER 1947.

Joseph M. Biagi.
Professional Engineer
Elkhorn Wisconsin.

OP-158

7-14B