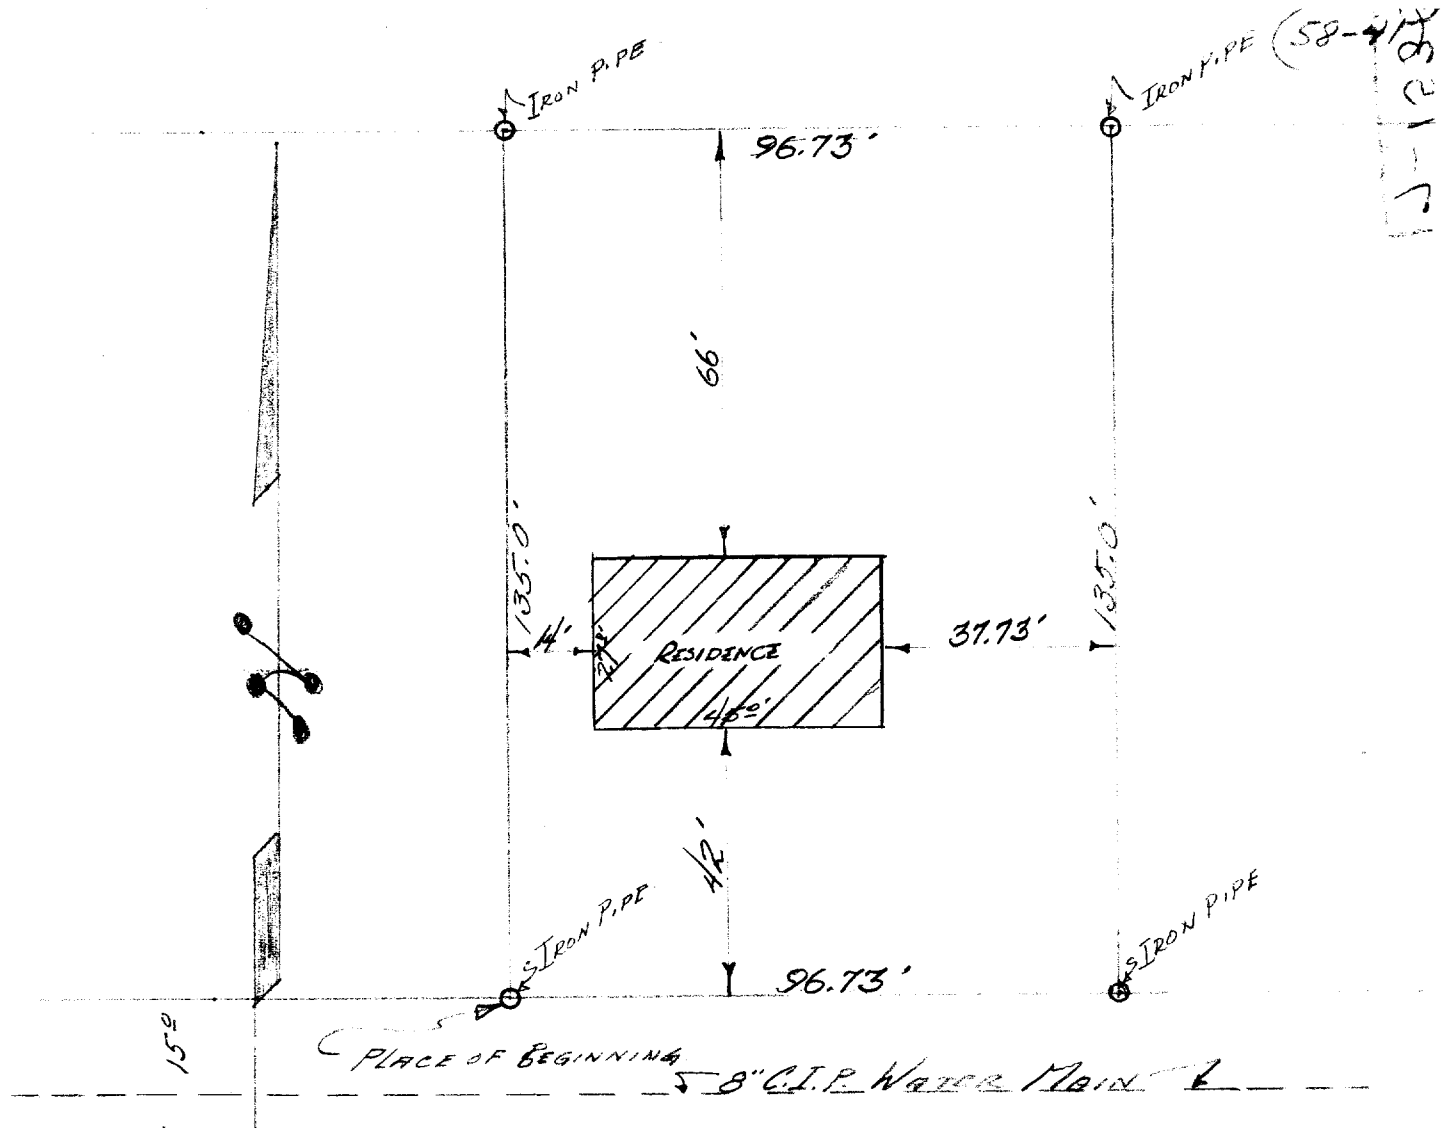


DESCRIPTION: Commencing at a point in the east extension of the north line of South Street of the City of Lake Geneva, Walworth County, Wisconsin, that is 446.96 feet, east of the west line of Section 6, Town 1, north, Range 18 east of the 4th Principal Meridian, thence North 135.0 feet to an iron stake, thence East 96.73 feet, to an iron stake, thence South 135.0 feet to a point in the aforsaid north line of South Street, thence West, 96.73 feet along the north line of South Street to the place of beginning.

CERTIFICATE: I, hereby certify that I have on this the 28th day of May, 1958, surveyed the above described property and find that no encroachments exist.

SIGNED AND SEALED ON THIS THE 29TH DAY OF MAY, 1958.

Joseph M. Biagi. Registered Surveyor.
Elkhorn, Wisconsin.

UP-132 A

7-153 B