
4/8-34

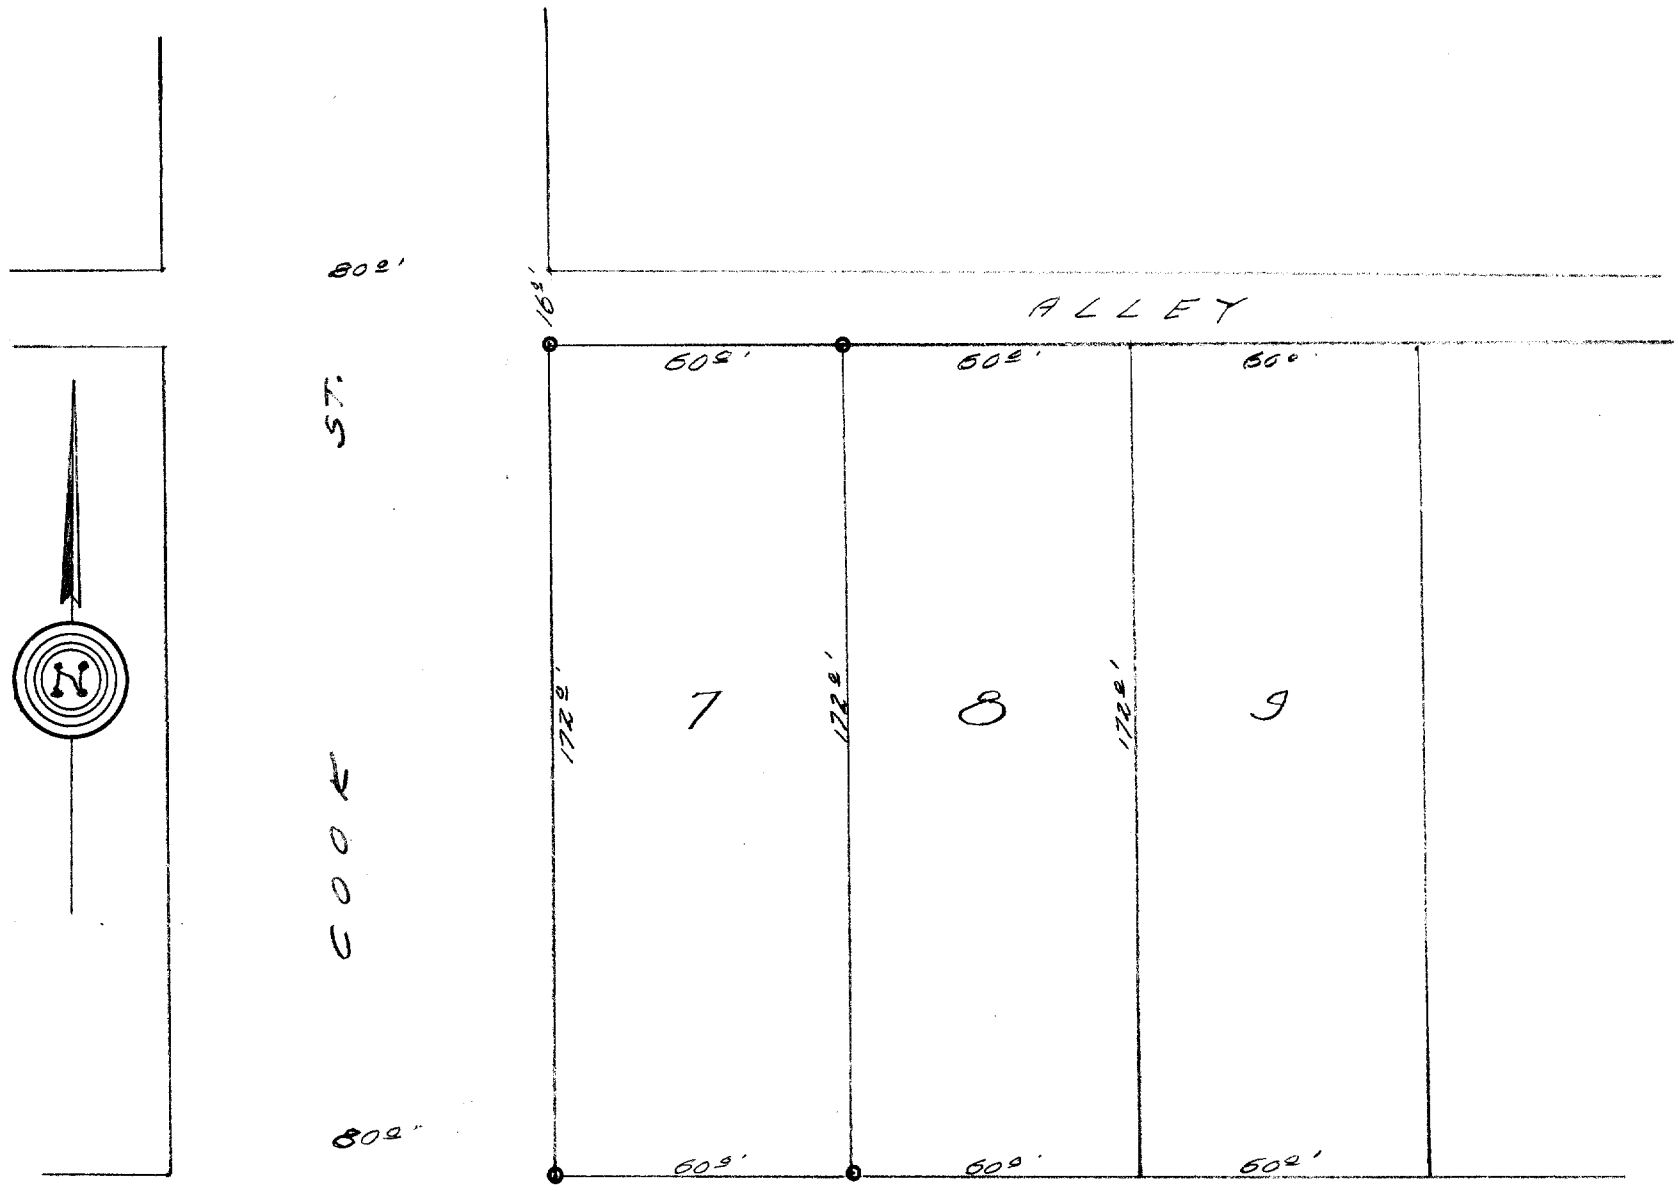

80'

WISCONSIN ST.

80'

DESCRIPTION:

Lot 7, Block 12; Original Plat of the Village of (now City of) Lake Geneva, Walworth County, Wisconsin.

CERTIFICATE: I, hereby certify that I have on this the 24th day of August 1948, surveyed the above described property according to the official record in the office of the Recorder of Deeds in and for Walworth County, Wisconsin, and find that the measurements and bearings of the boundary lines of said property as taken at the site on this day, substantially agree with those in the above description and that there are no encroachments upon this property.
SIGNED AND SEALED THIS 26TH DAY OF AUGUST 1948.

Joseph M. Biagi. Professional Engineer.
Elkhorn Wisconsin.

708.100

7-155B