


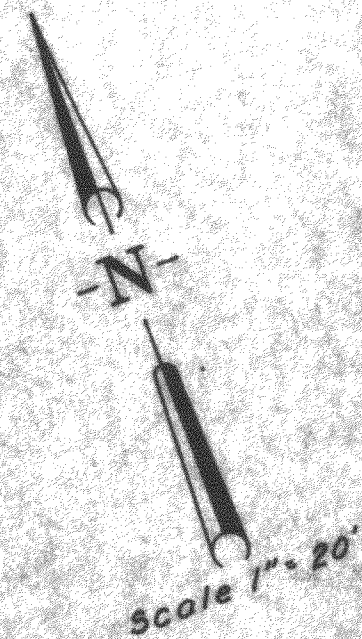


PLAT OF SURVEY OF

Lots 11 & 12, Block 1, Geneva Bay Estates, City of Lake Geneva, Walworth County, Wis.

Harold H. Kolb
Harold H. Kolb
Wisconsin Surveyor, 9-187

Elevations tied to Railroad Commission Benchmark No. 437B, located at the outlet of Geneva Lake. Elevation - 100.00
Geneva Lake Elevations
High water elev. 96.22
Low water elev. 94.90

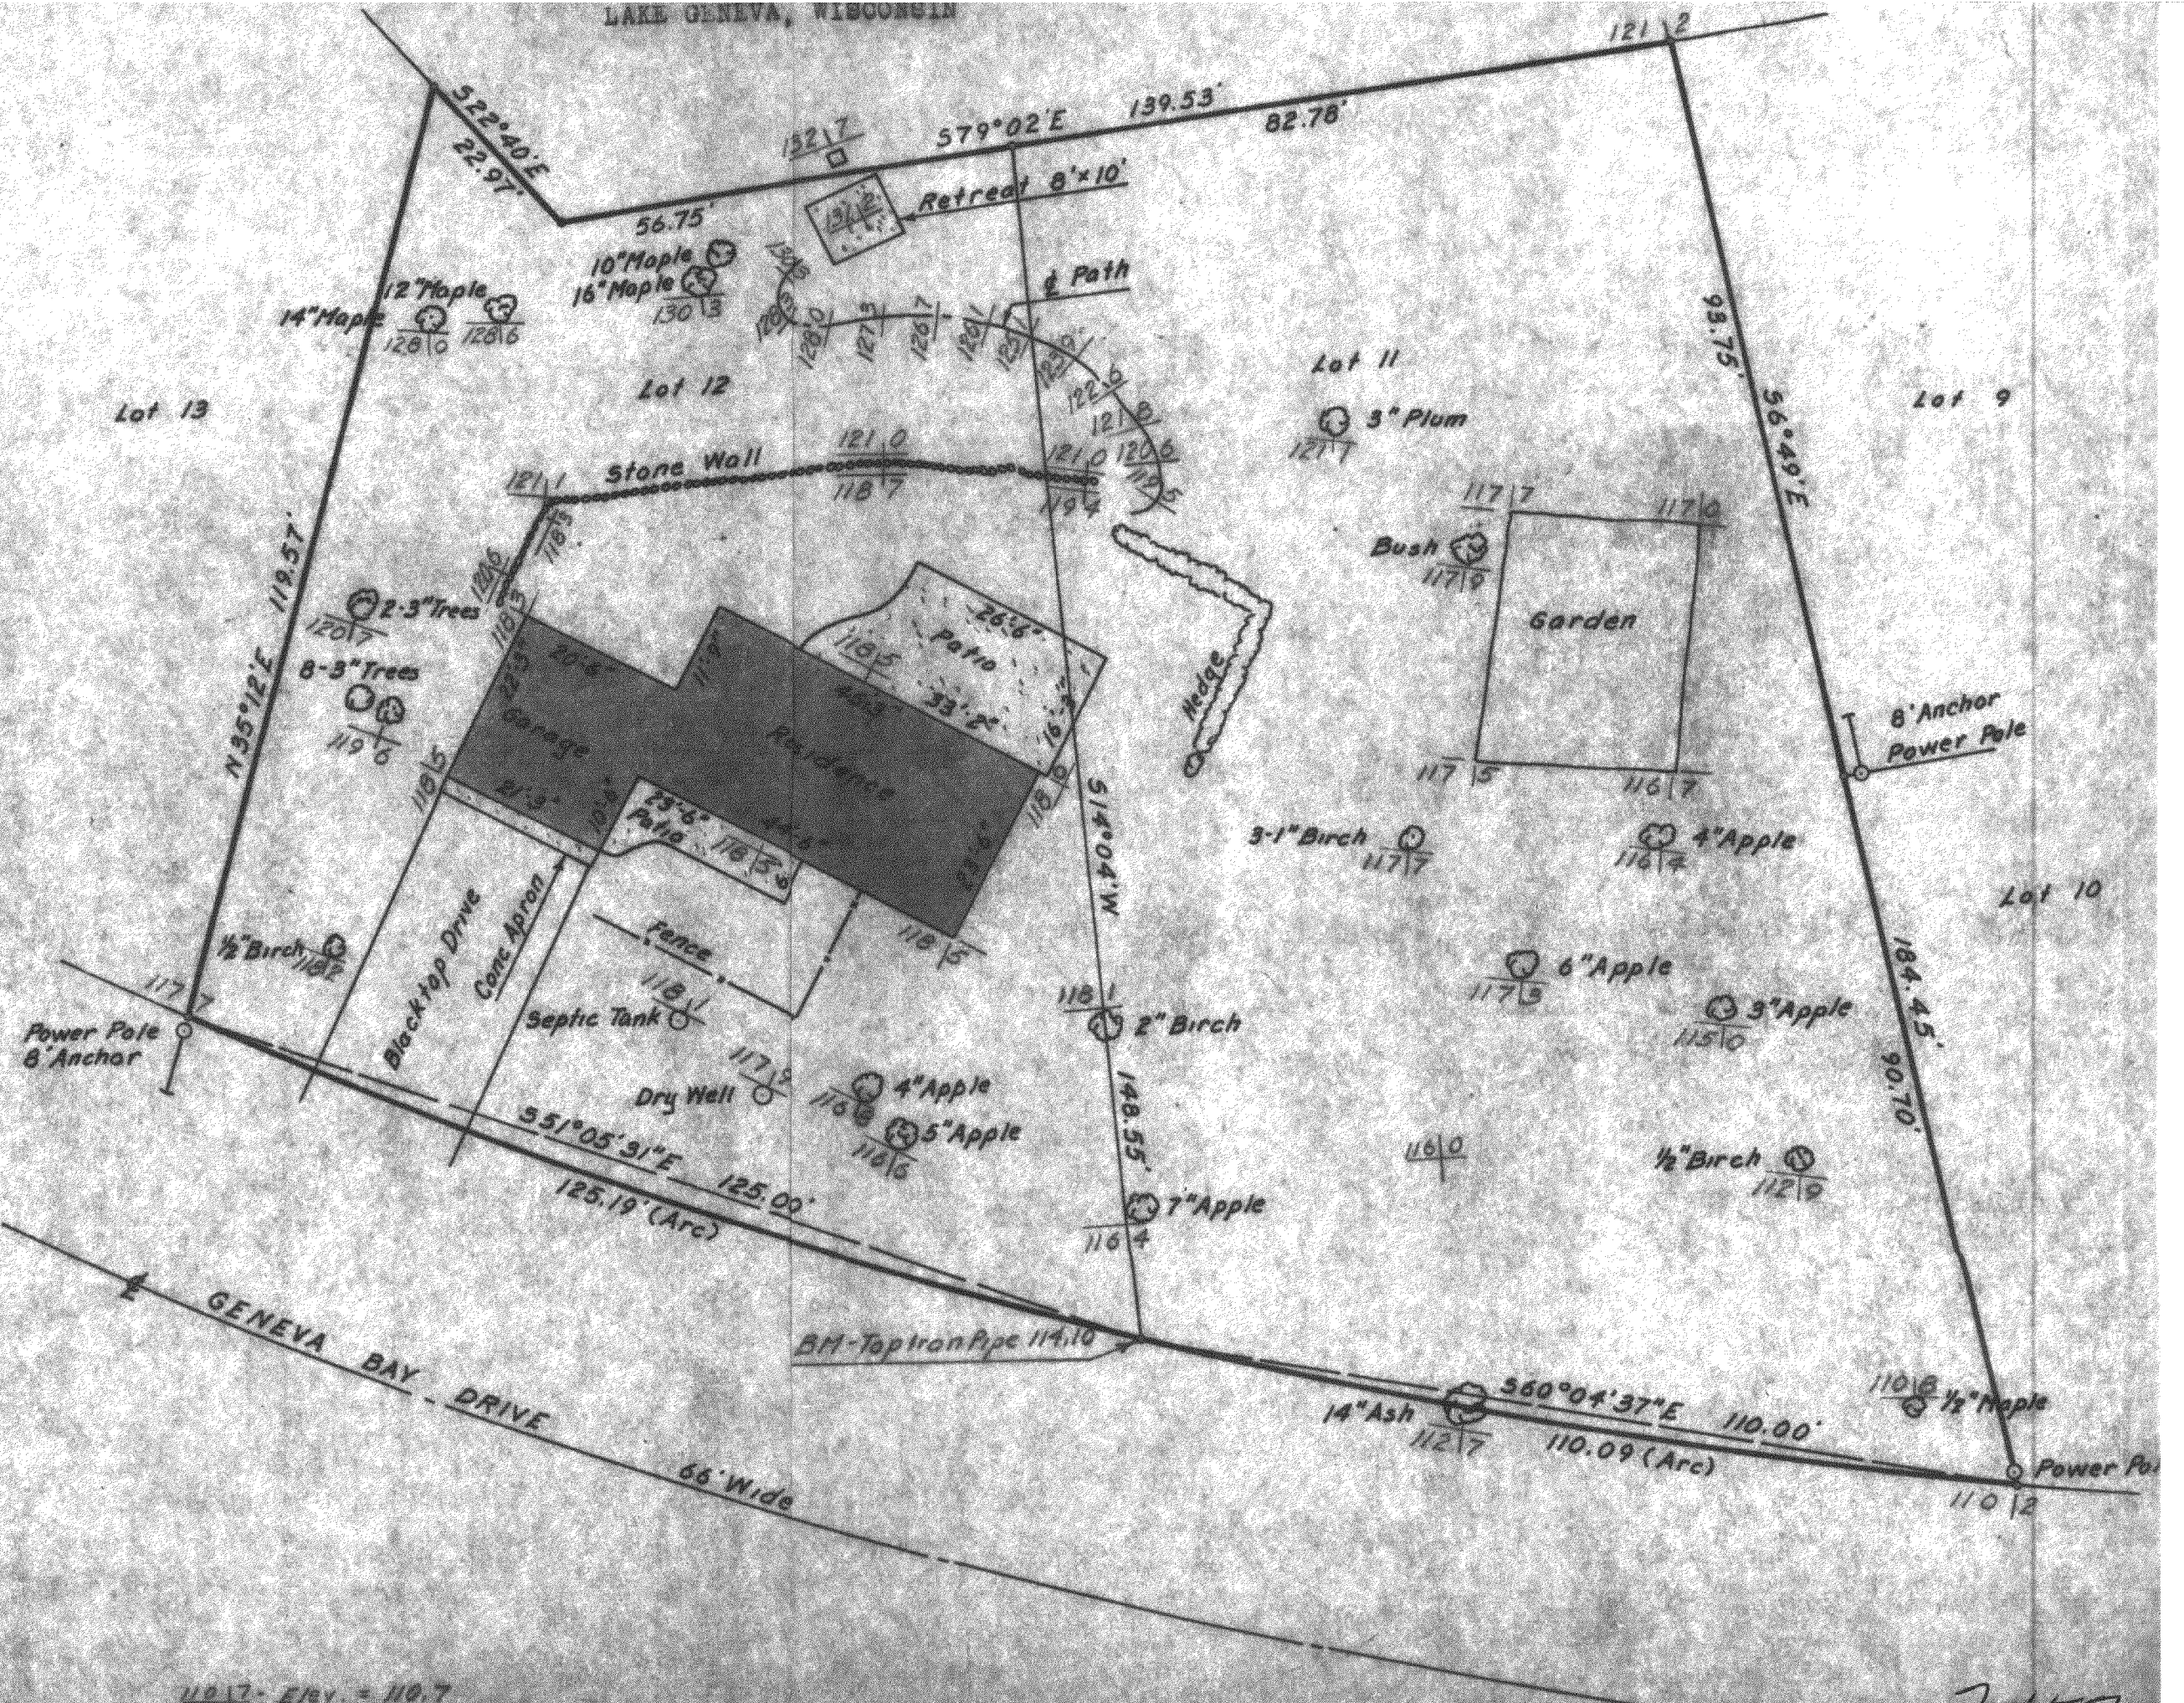

110.17 - Elev. = 110.7
• Conc. Monument Found
• Iron Pipe Found