


HAROLD H. KOLB
REGISTERED PROFESSIONAL LAND SURVEYOR
LAKE GENEVA, WISCONSIN

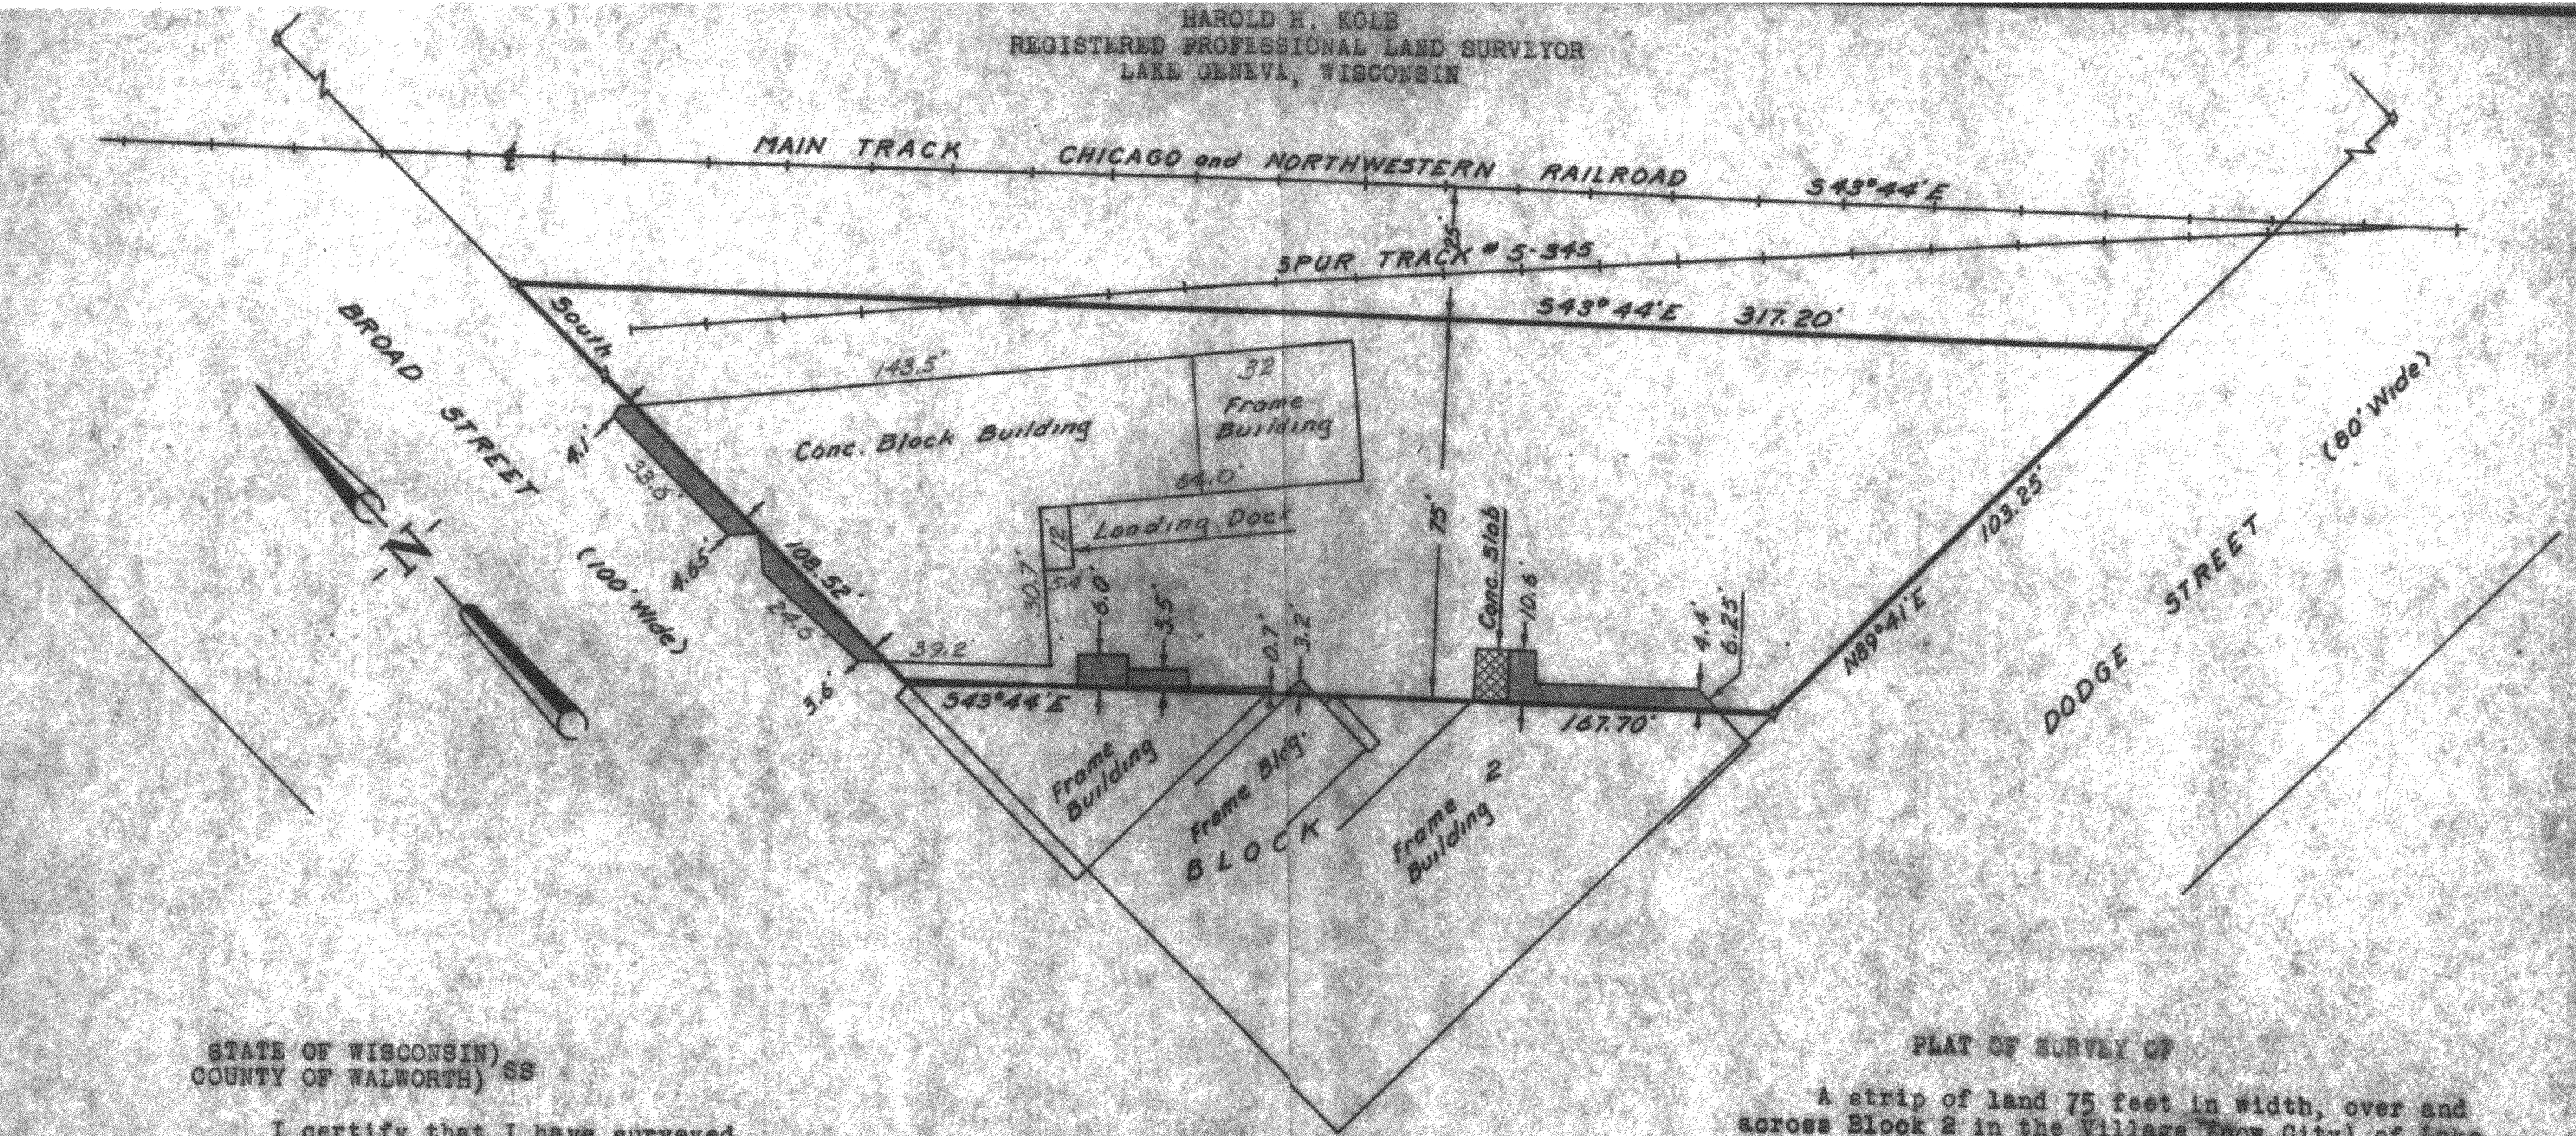

STATE OF WISCONSIN)
COUNTY OF WALWORTH) SS

I certify that I have surveyed the above-described property and that the above plat is an accurate survey and a true representation thereof and correctly shows the exterior boundary lines and location of buildings and other improvements of said property and the correct measurements thereof.

Harold H. Kolb
Harold H. Kolb, Wisconsin Registered Surveyor, S-187
DATE: February 24, 1964

PLAT OF SURVEY OF

A strip of land 75 feet in width, over and across Block 2 in the Village (now City) of Lake Geneva, Wisconsin, lying between two lines drawn parallel with and distant 25 feet and 100 feet Southwesterly of, as measured at right angles from, the center line of the main track of the Chicago and Northwestern Railway Company, as now located and established.

20P-33A

OP-32

Scale 1"=30'

7-162