
51-5

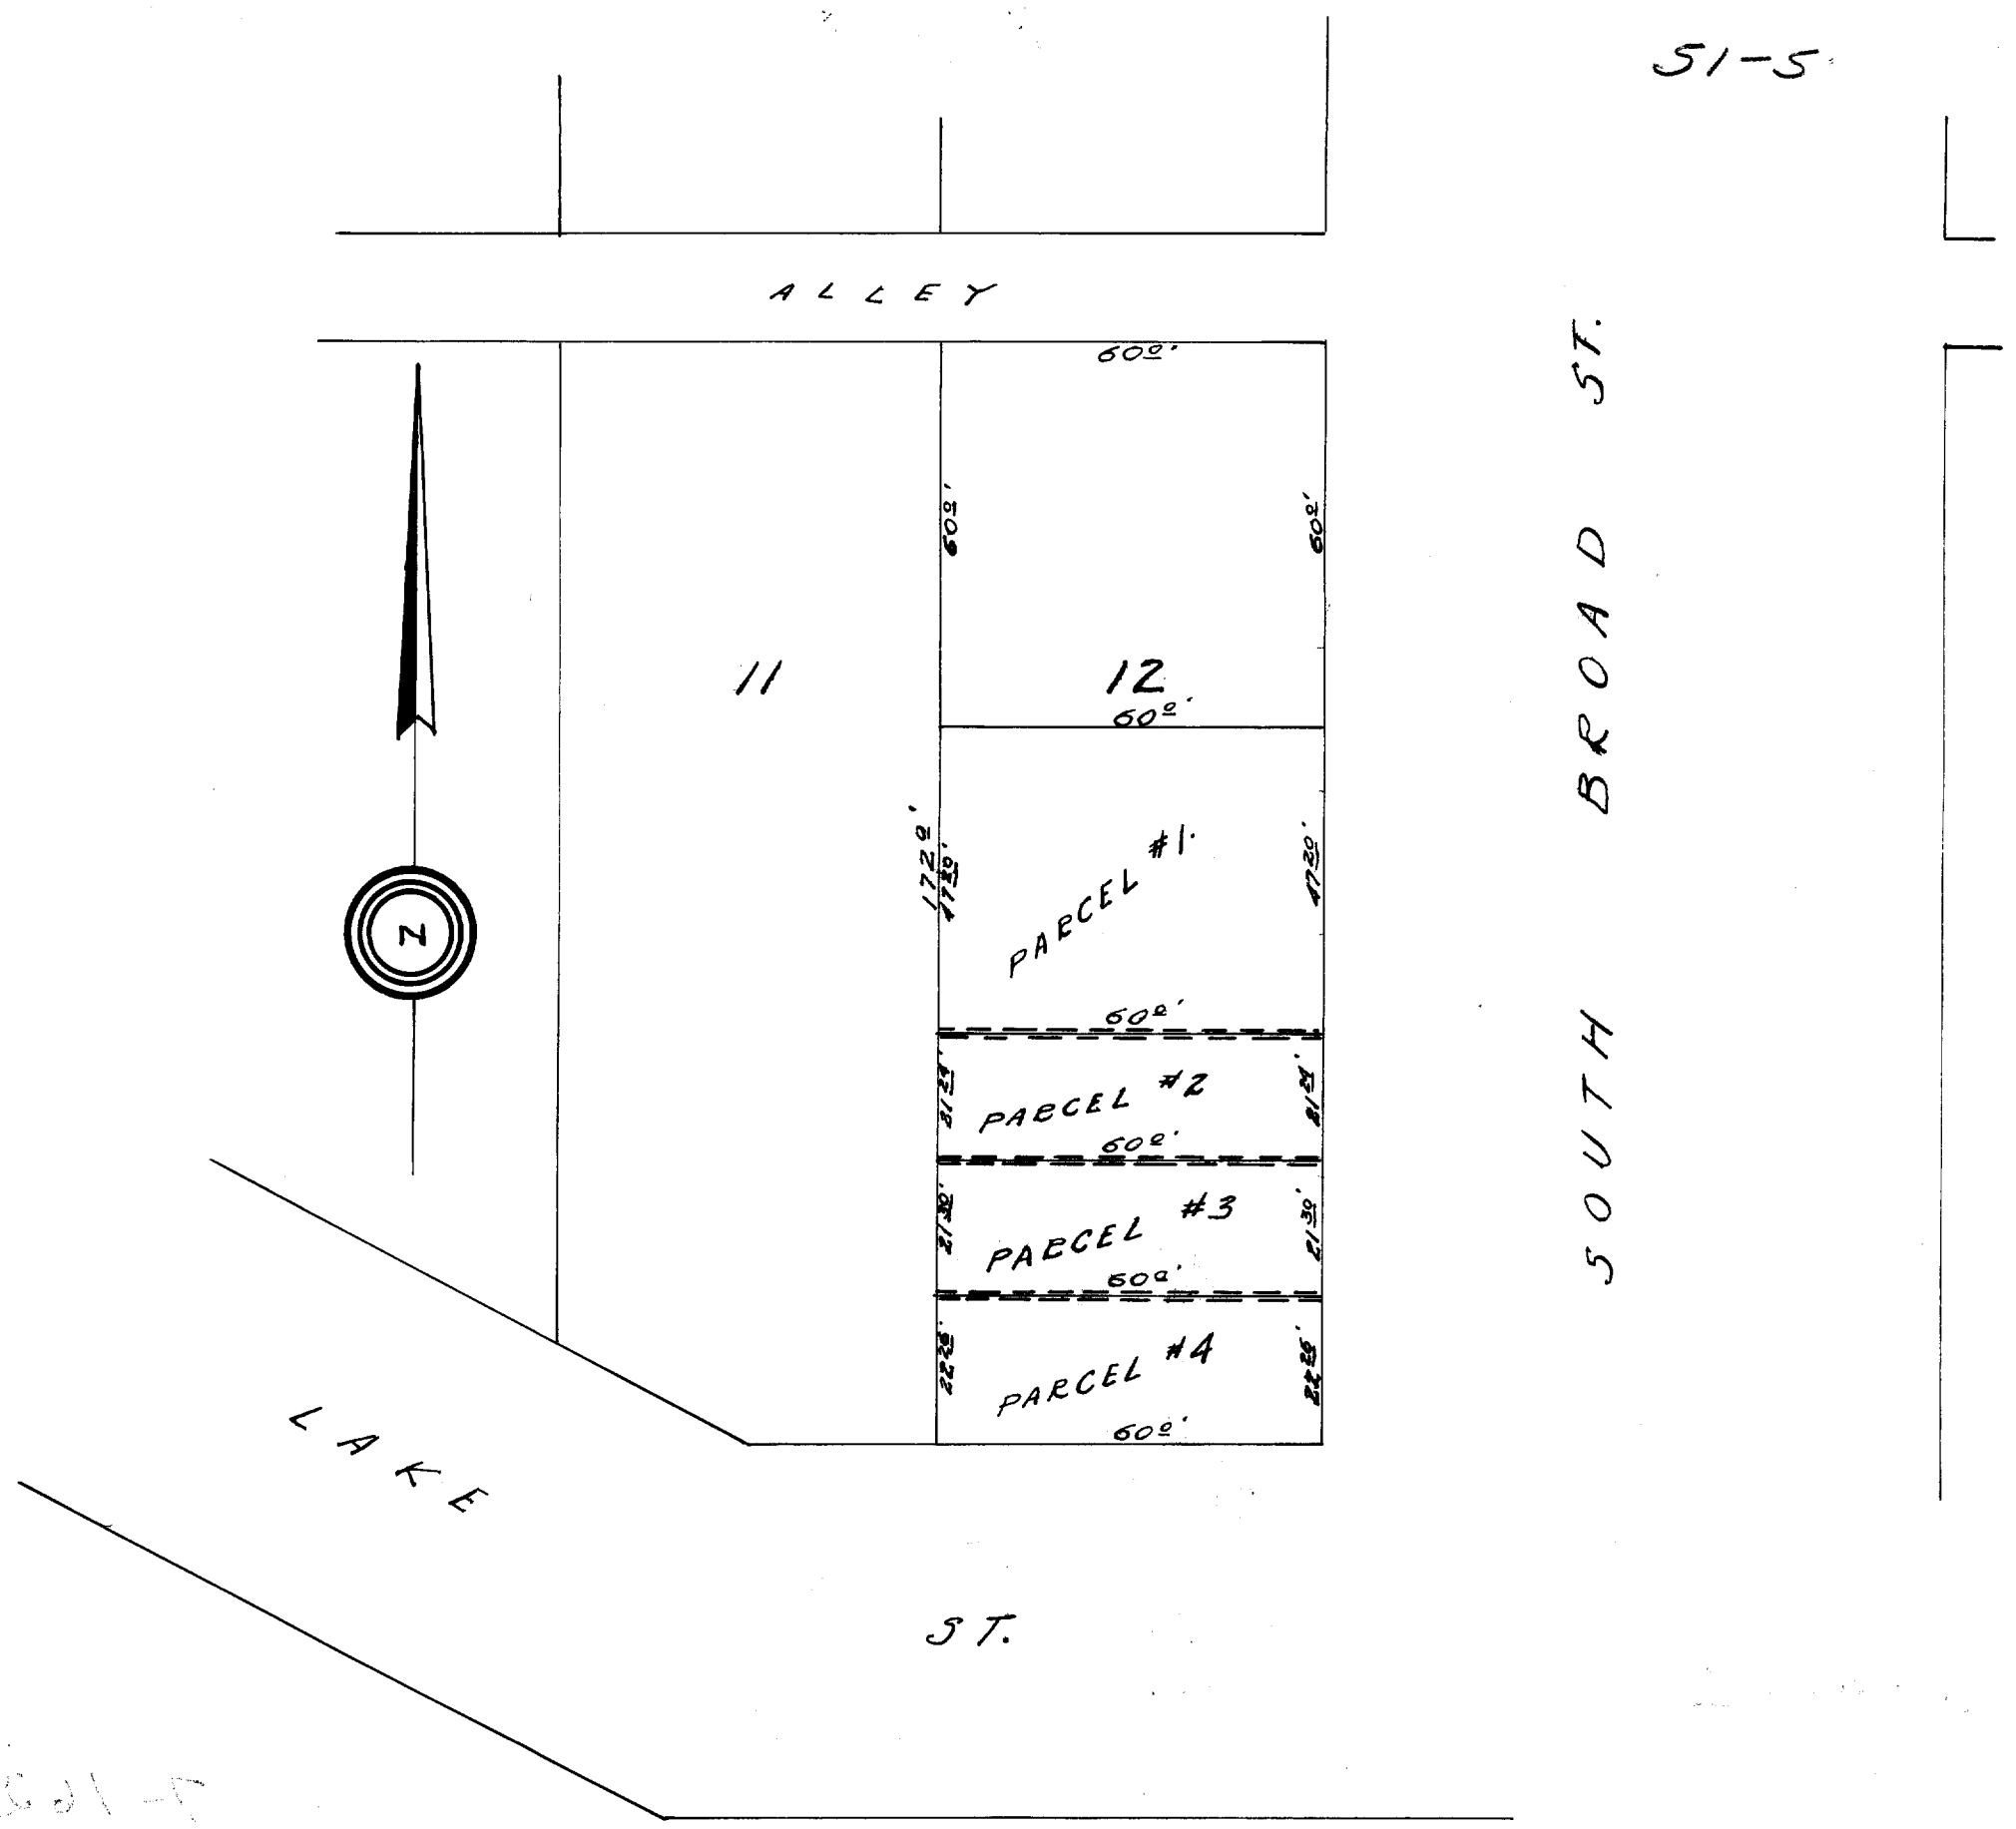

a501-5

DESCRIPTIONS:

PARCEL #1.
The south 47.20 feet of the north 107.20 feet of Lot 12, Block 31, Original Plat of the Village (now city) of Lake Geneva, Walworth County, Wisconsin, Also the right of use of the south one half of a twelve inch wall (party wall) the south one half being located immeadiatly south of and adjacent to the south line of the above described parcel #1.

PARCEL # 2.
The south 21.24 feet of the north 128.44 feet of Lot 12, Block 31, Original Plat of the Village (now city) of Lake Geneva, Walworth County, Wisconsin, Also the right of use of the north one half of a twelve inch wall (party wall) said north one half being located immeadiatly north of and adjacent to the north line of the above described Parcel #2., also the right of use of the south one half of a twelve inch wall (party wall) the said south one half being located immeadiatly south of and adjacent to the south line of the above described Parcel # 2.

PARCEL # 3.
The south 21.30 feet of the north 149.74 feet of Lot 12 Block 31, Original Plat of the Village(now city) of Lake Geneva, Walworth County, Wisconsin, Also the right of use of the north one half of a twelve inch wall (party wall) said north one half being located immeadiatly north of and adjacent to the north line of the above described Parcel #3., also the right of use of the south one half of a twelve inch wall (party wall) the said south one half being located immeadiatly south of and adjacent to the south line of the above described Parcel #3.

PARCEL # 4.
The south 22.26 feet of Lot 12, Block 31, Original Plat of the Village (now city) of Lake Geneva, Walworth County, Wisconsin, also the right of use of the north one half of a twelve inch wall (party wall), said north one half being located immeadiatly north of and adjacent to the north line of the above described Parcel #4.

CERTIFICATE:

I, hereby certify that I have on this the 7th day of September, 1951, surveyed the above described parcels of land according to the official records on file in the office of the Recorder of Deeds in and for Walworth County, Wisconsin, and find that the measurements and bearins of the boundary lines of said property as taken at the site on this day, substantially agree with those in said official record and that no encroachments exist.
SIGNED AND SEALED THIS 10TH DAY OF SEPTEMBER 1951.

Joseph M. Biagi. Professional Engineer
Elkhorn Wisconsin.

OP-347, 347A, 347B + 347C

7-162B